


VERTICAL GRANITE CURB, ITEM 556-B
 Berlin Street
 19+04 - 19+07 (on Railroad St)



Berlin Street Sta 19+75.0
 END CONSTRUCTION

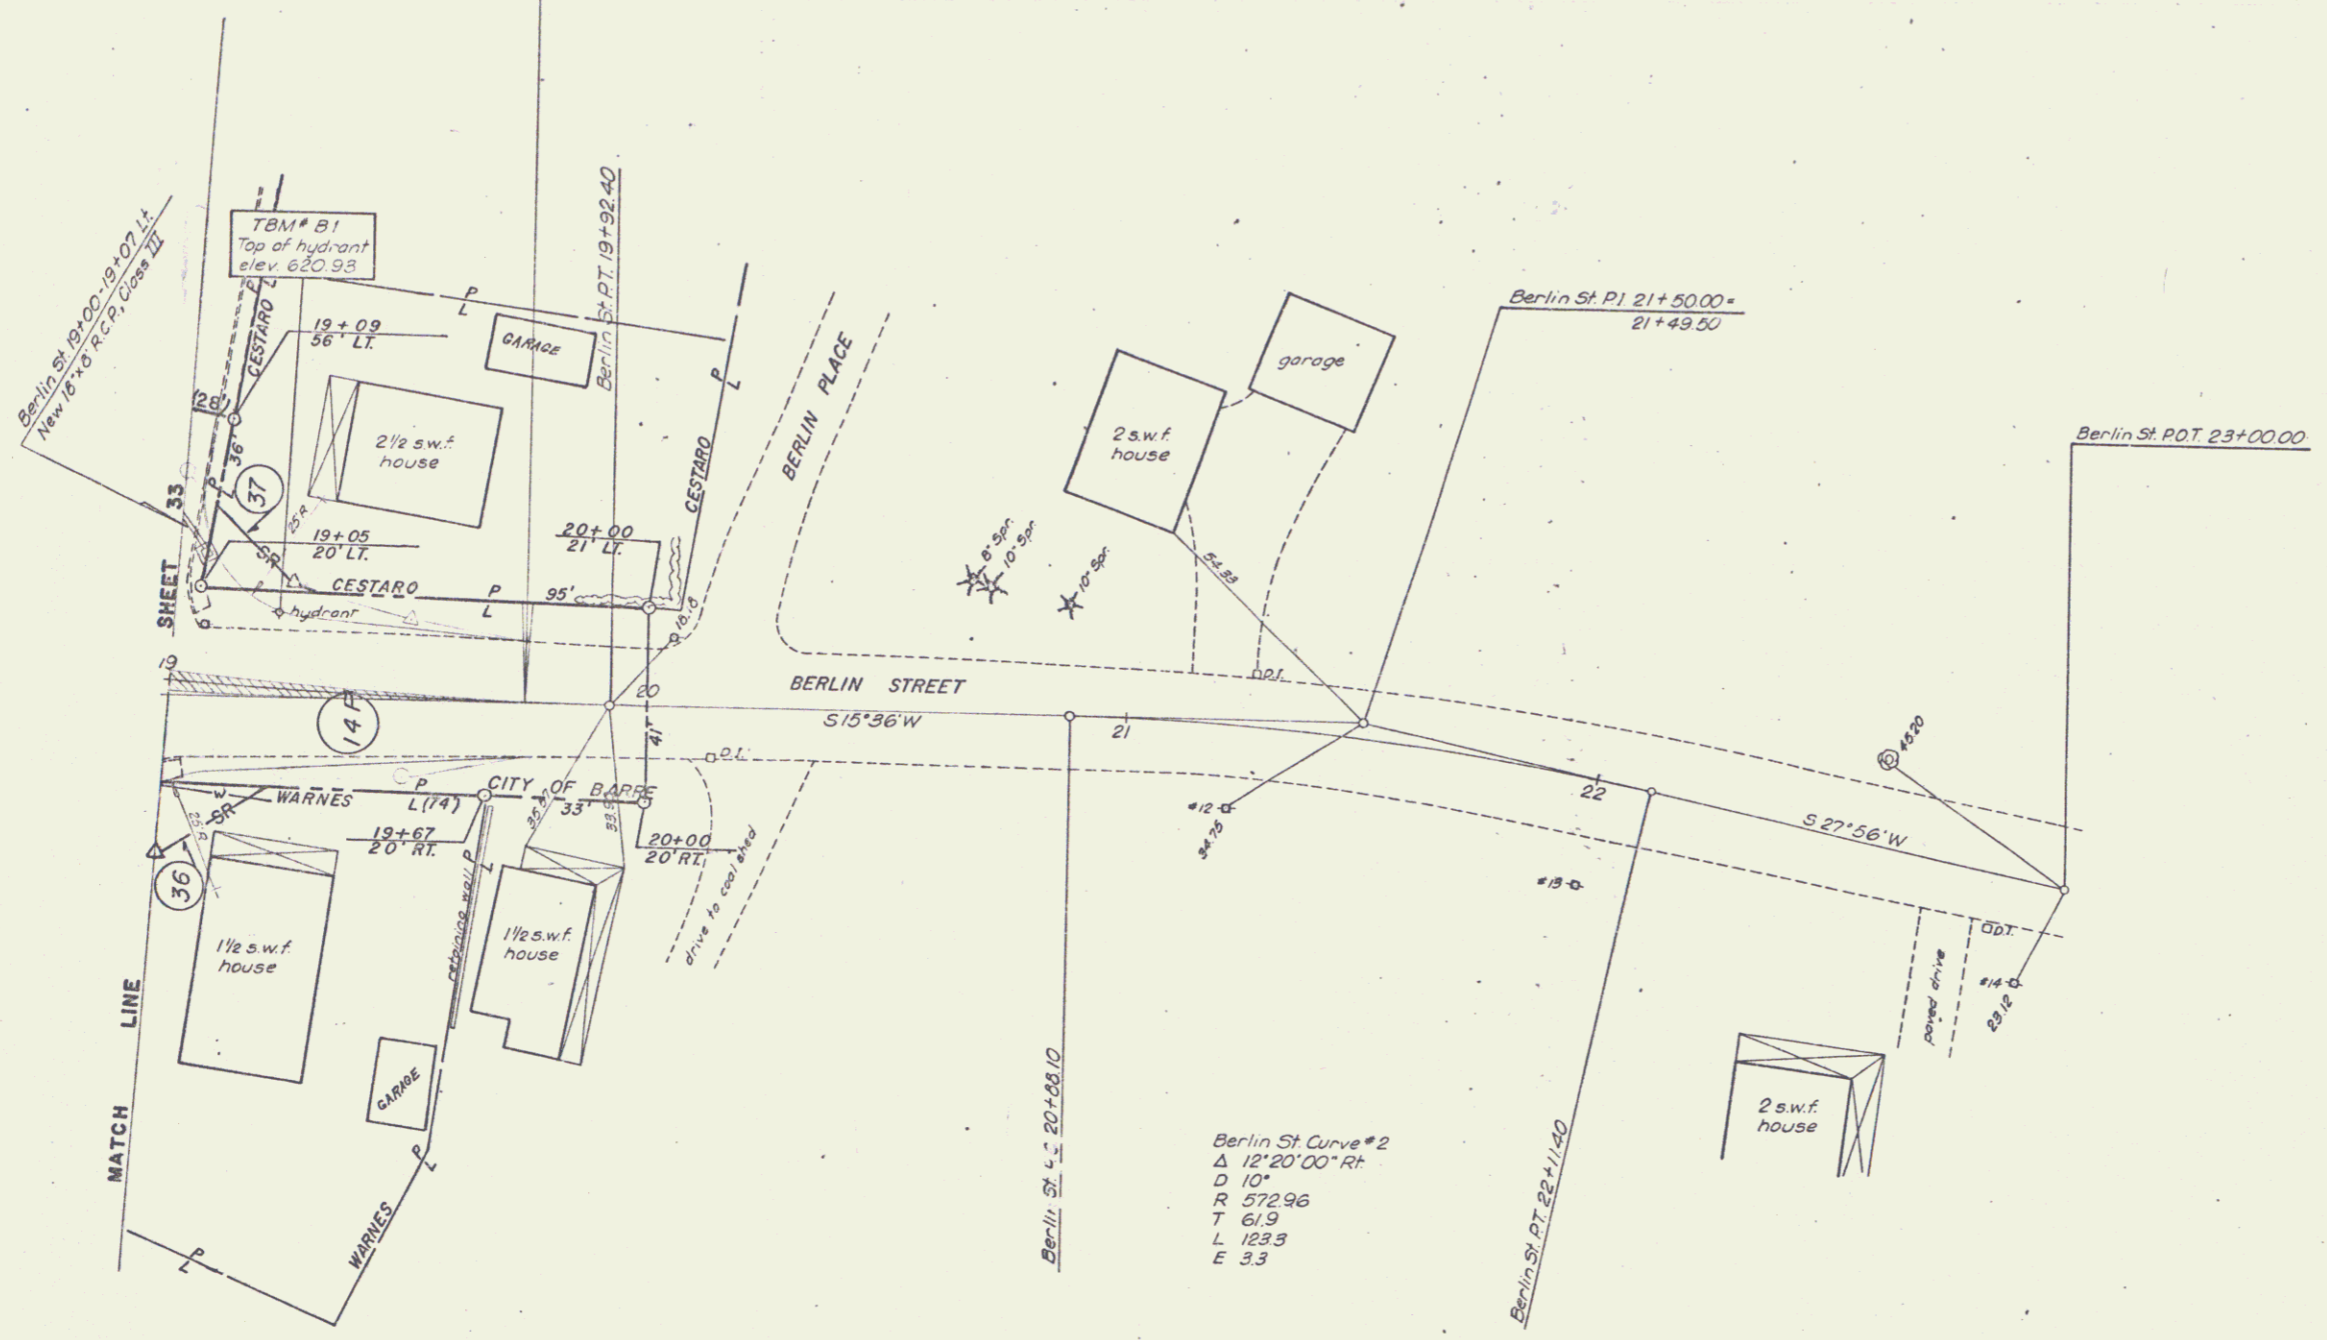

Berlin St Curve #2
 Δ 12°20'00" Rt
 D 10'
 R 572.96
 T 61.9
 L 123.3
 E 3.3

SCALE: 1"=20'

BERLIN STREET	
STATE OF VERMONT	
DEPARTMENT OF HIGHWAYS	
SURVEYED BY	Jewett DATE 2-70
DRAWN BY	Rock DATE 3-70
TRACED BY	C.E.H. DATE 3-70
BERLIN-BARRE	
PROJ. F. NO.	026-1(7)
SHEET	43 OF 63

30
 D-7