

EXCAVATION & REMOVAL OF ASPH.
SURFACES AND/OR PAVEMENTS
ST
152+70 - 152+80
162+15 - 162+20

THREE CABLE GUARD RAIL
WITH LIGHT STEEL POSTS
RT
155+00 - 157+00

DRILLING & PLACING OF SOLID
ROCK SUBGRADE
RT
166+75 - 168+15

DEMOLITION & DISPOSAL
OF BUILDING
RT
157+15



CONSTRUCT APPROACH
RT
162+50

CONSTRUCT SPECIAL DITCH
(TO BE PAID AS ITEM 100-A)
RT
157+10 - 160+15

STONE FILL FOR SLOPE
PROTECTION (200-TYPE)
RT
157+00 - 160+65

UNCLASSIFIED CHANNEL EXCAVATION
RT
167+10 - 167+25

FIELD DRIVE
157+00 LC

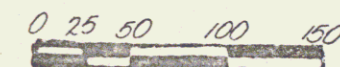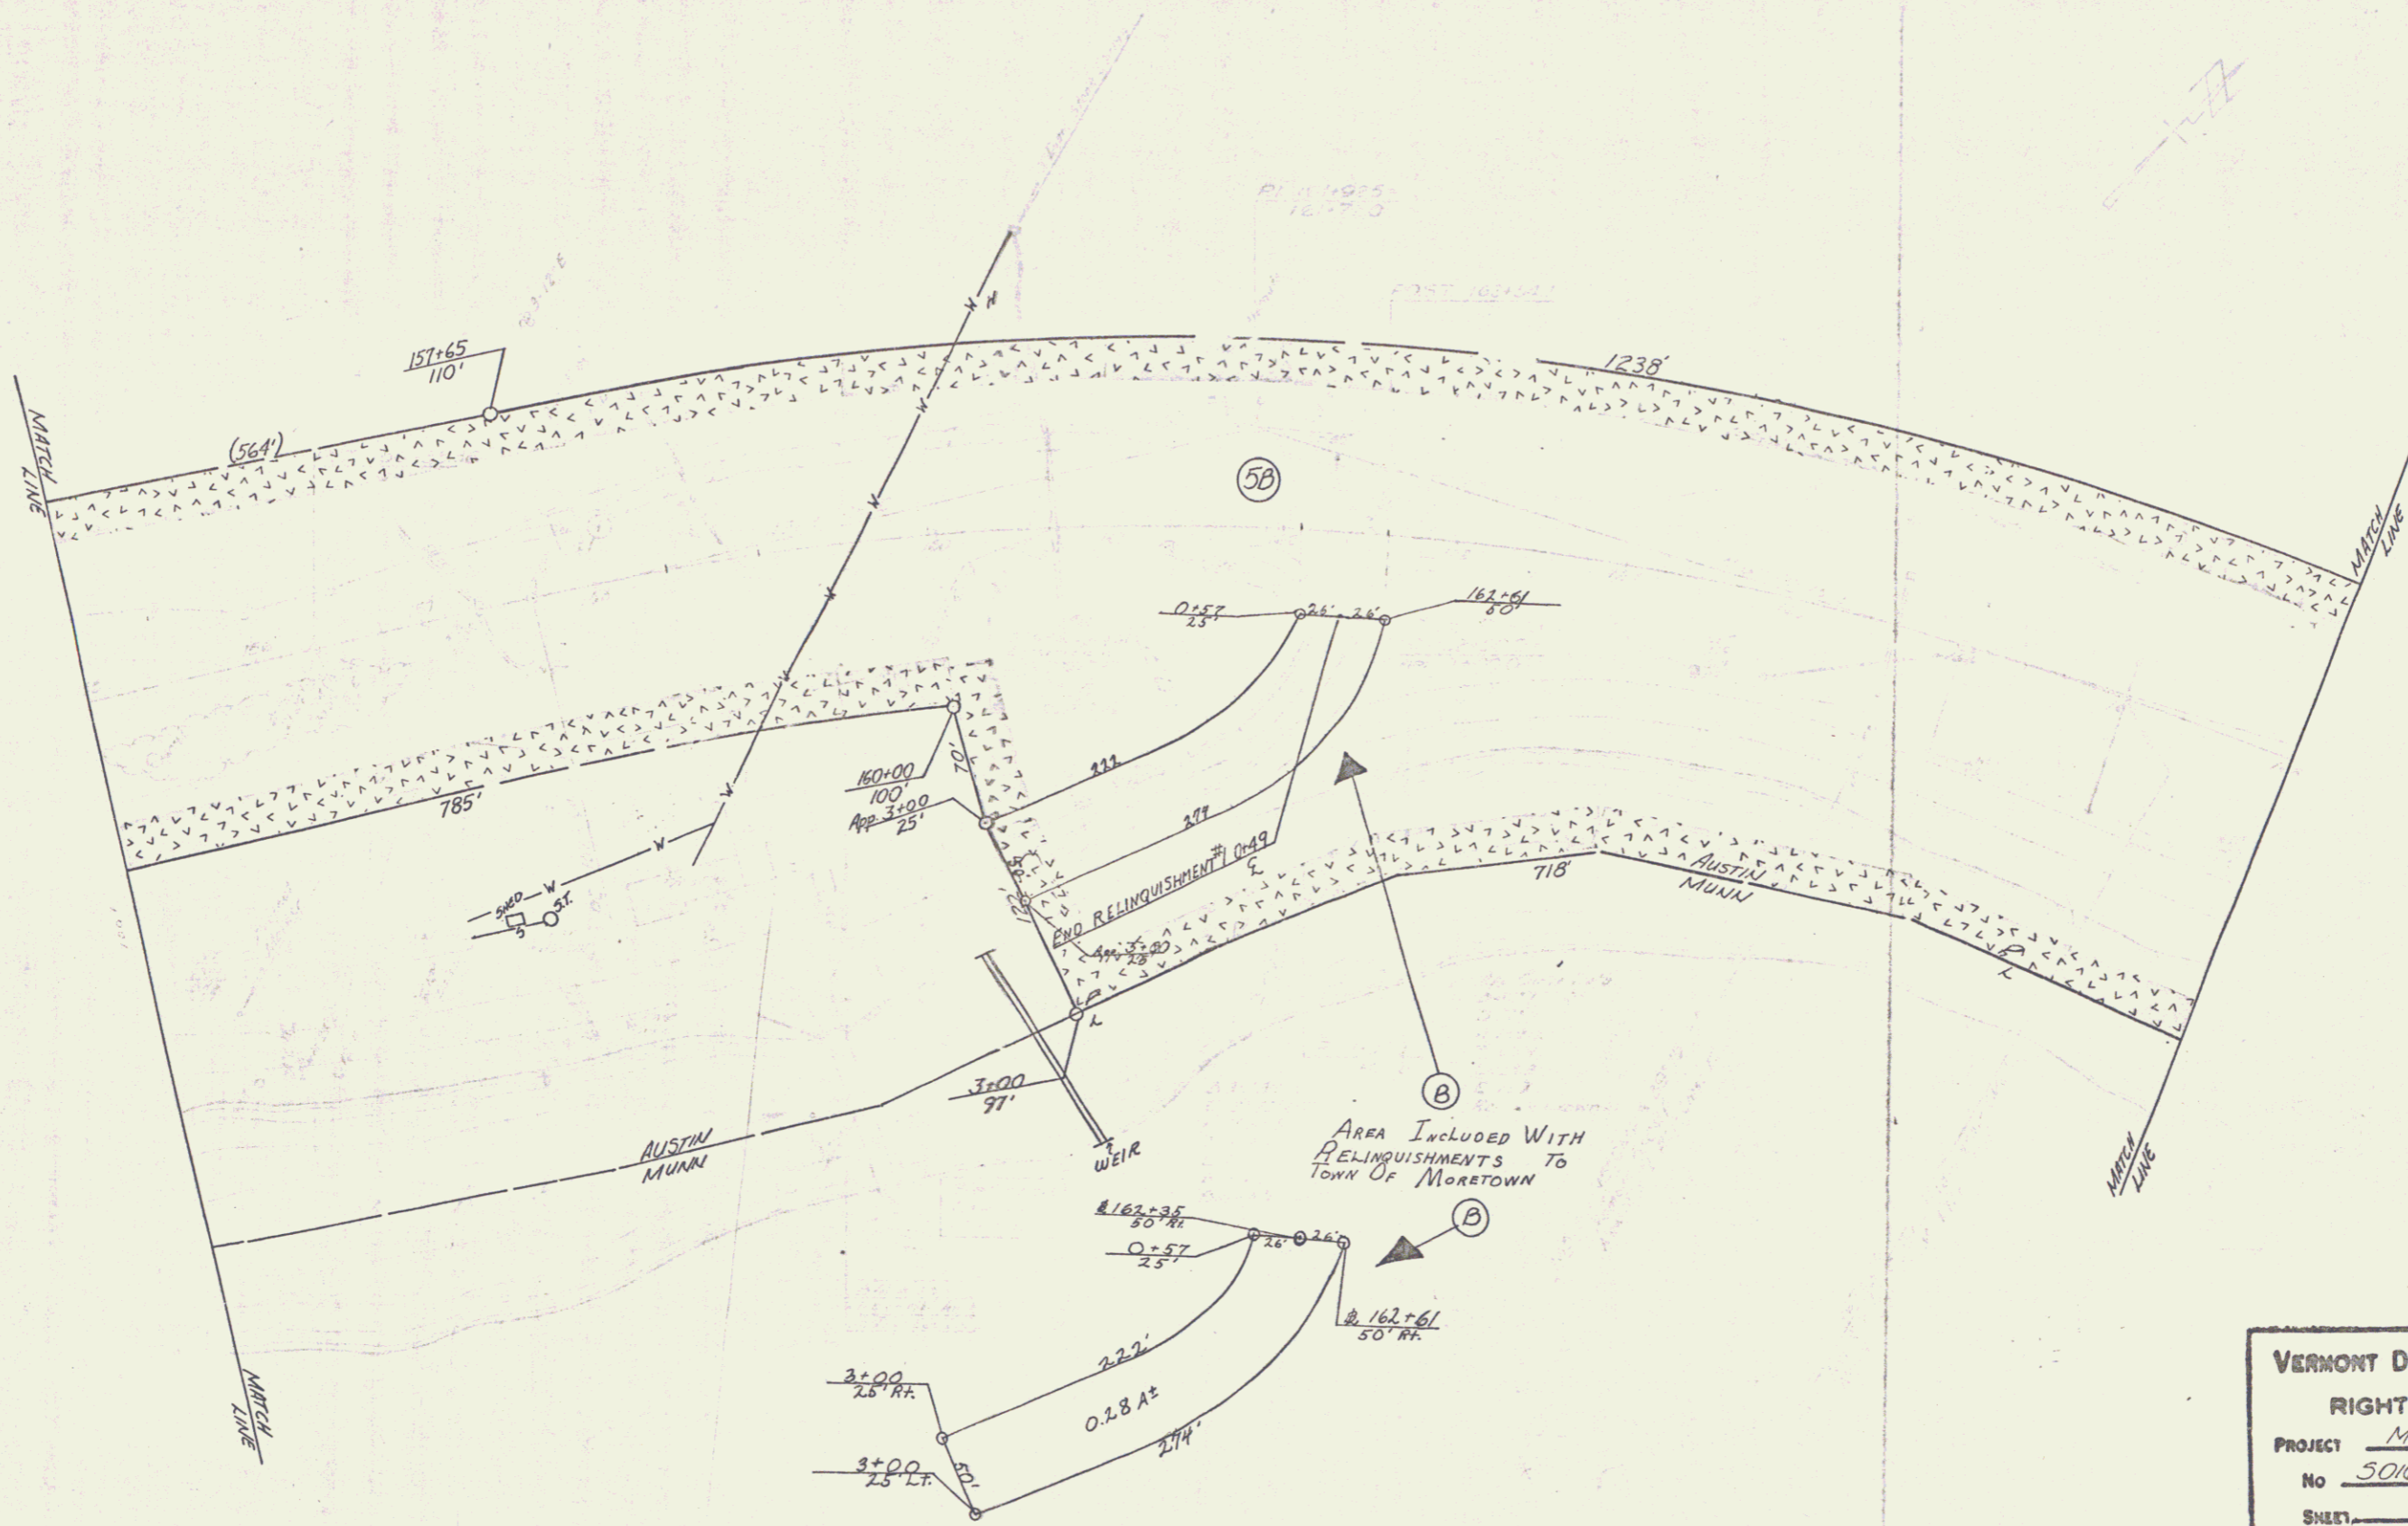

VERMONT DEPARTMENT OF HIGHWAYS
RIGHT-OF-WAY PLANS
PROJECT MORETOWN
No 50167(6)
SHEET 7 OF 16