

THREE CABLE GUARD RAIL WITH STEEL POSTS  
 RT. 4+30  
 181+00-185+34  
 0.153  
 192+34-194+00

DRILLING & BLASTING OF SOLID ROCK SUBGRADE  
 181+25-184+25  
 185+25-189+25.00  
 191+25-194+00

Construct Drive  
 180+78 Lt

G.M.P.C. to rebuild in place for clearance

G.M.P.C. to rebuild in place


BM # 36-D  
 SIT 4" Chy  
 US Elev. 639.48

BM # 37-A  
 Chis on Bc  
 US Elev. 643.85

BM # 38-A  
 SIT 30" E  
 US Elev. 600.40

BM # 37  
 SIR 48" Elm  
 US Elev. 565.480

BM # 38  
 Chis on Ladies  
 US Elev. 564.740

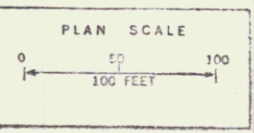

SURVEYED BY *Swett* DATE *Feb. 66*  
 DRAWN BY *A. Gagnon* DATE *Apr. 66*  
 TRACED BY *A. Gagnon* DATE *Apr. 66*  
**MORETOWN**  
 PROJ. S NO. 0167 (6)  
 SHEET 10 OF 85