


96+92
107+00

CONSTRUCT BITUM. L.S. OUTER
USING ITEM 553
10-1-50

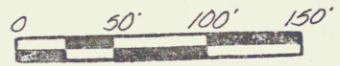

VERMONT DEPARTMENT OF HIGHWAYS
RIGHT-OF-WAY PLANS
PROJECT ROYALTON-TUNBRIDGE
No 50169/11
SHEET 23 OF 35

POOR ORIGINAL COPY