
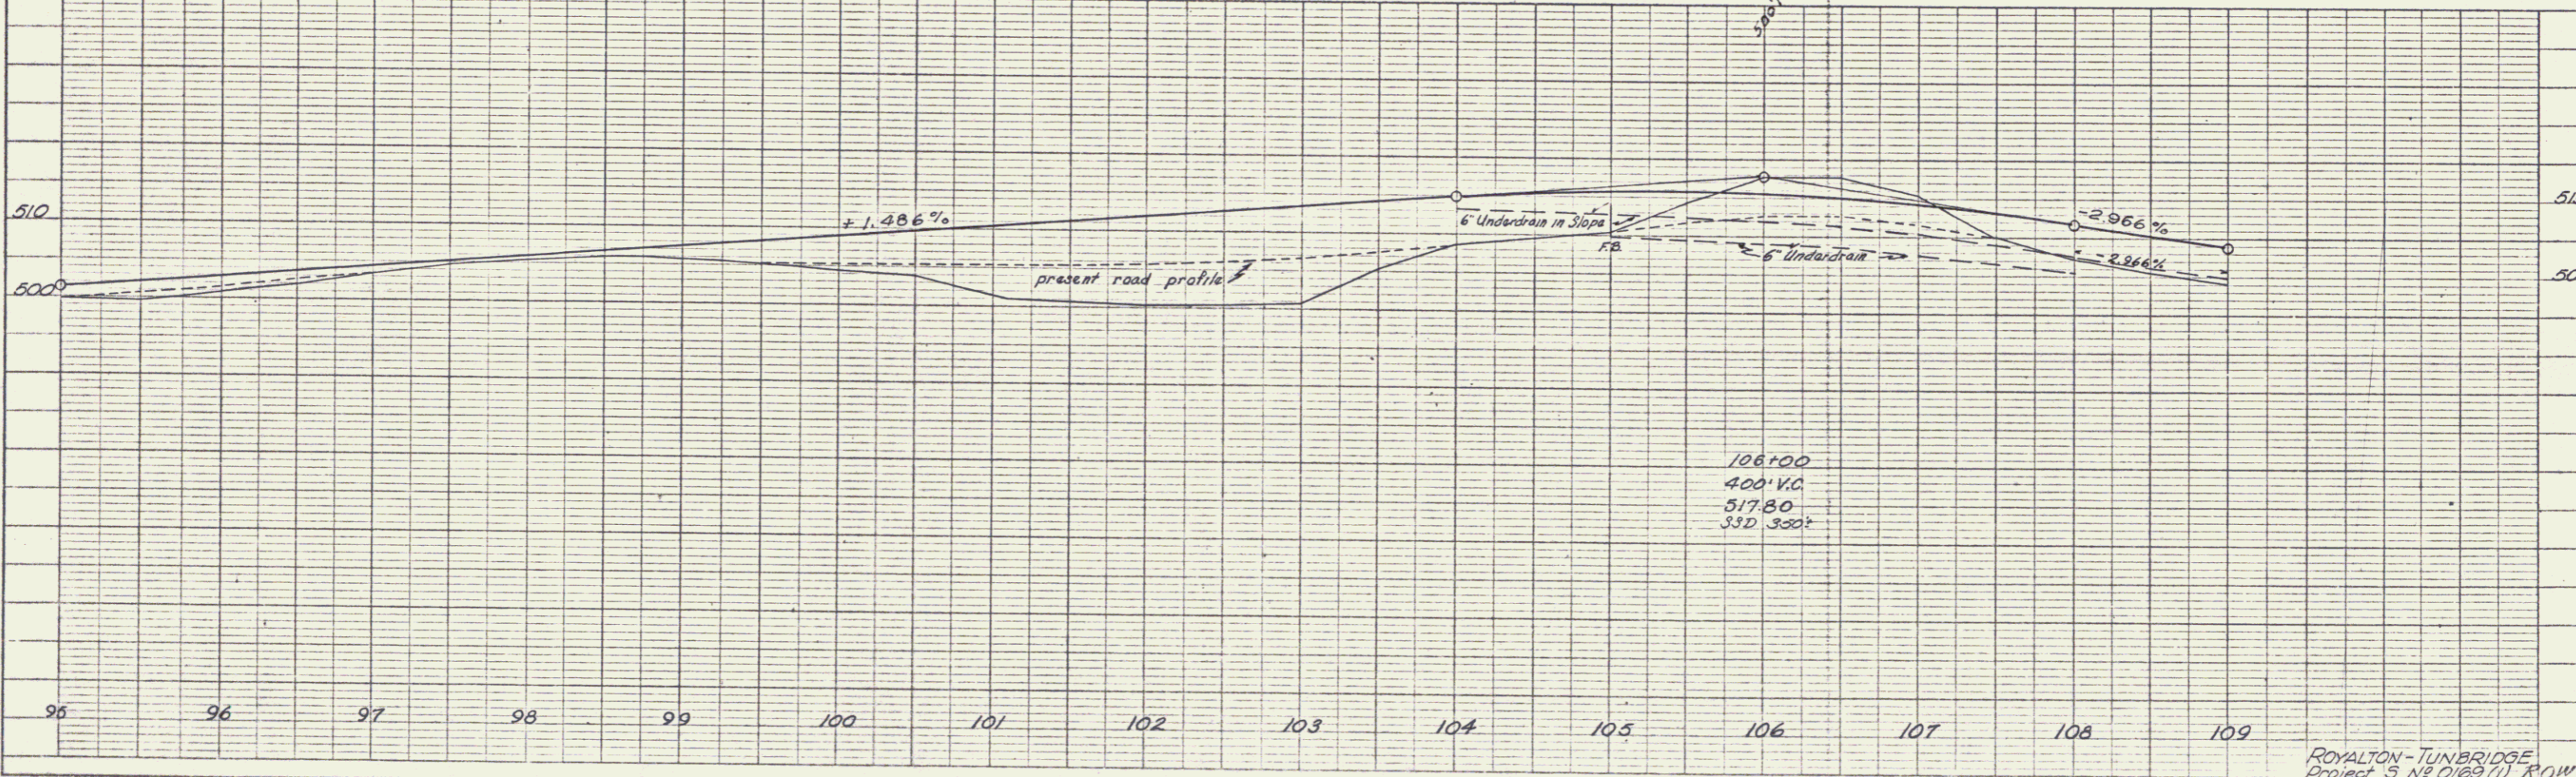


DATE: 1/28/78  
 BY: J. M. [unclear]  
 CHECKED: [unclear]  
 NO. [unclear]

DATE: 1/28/78  
 BY: [unclear]  
 CHECKED: [unclear]  
 NO. [unclear]

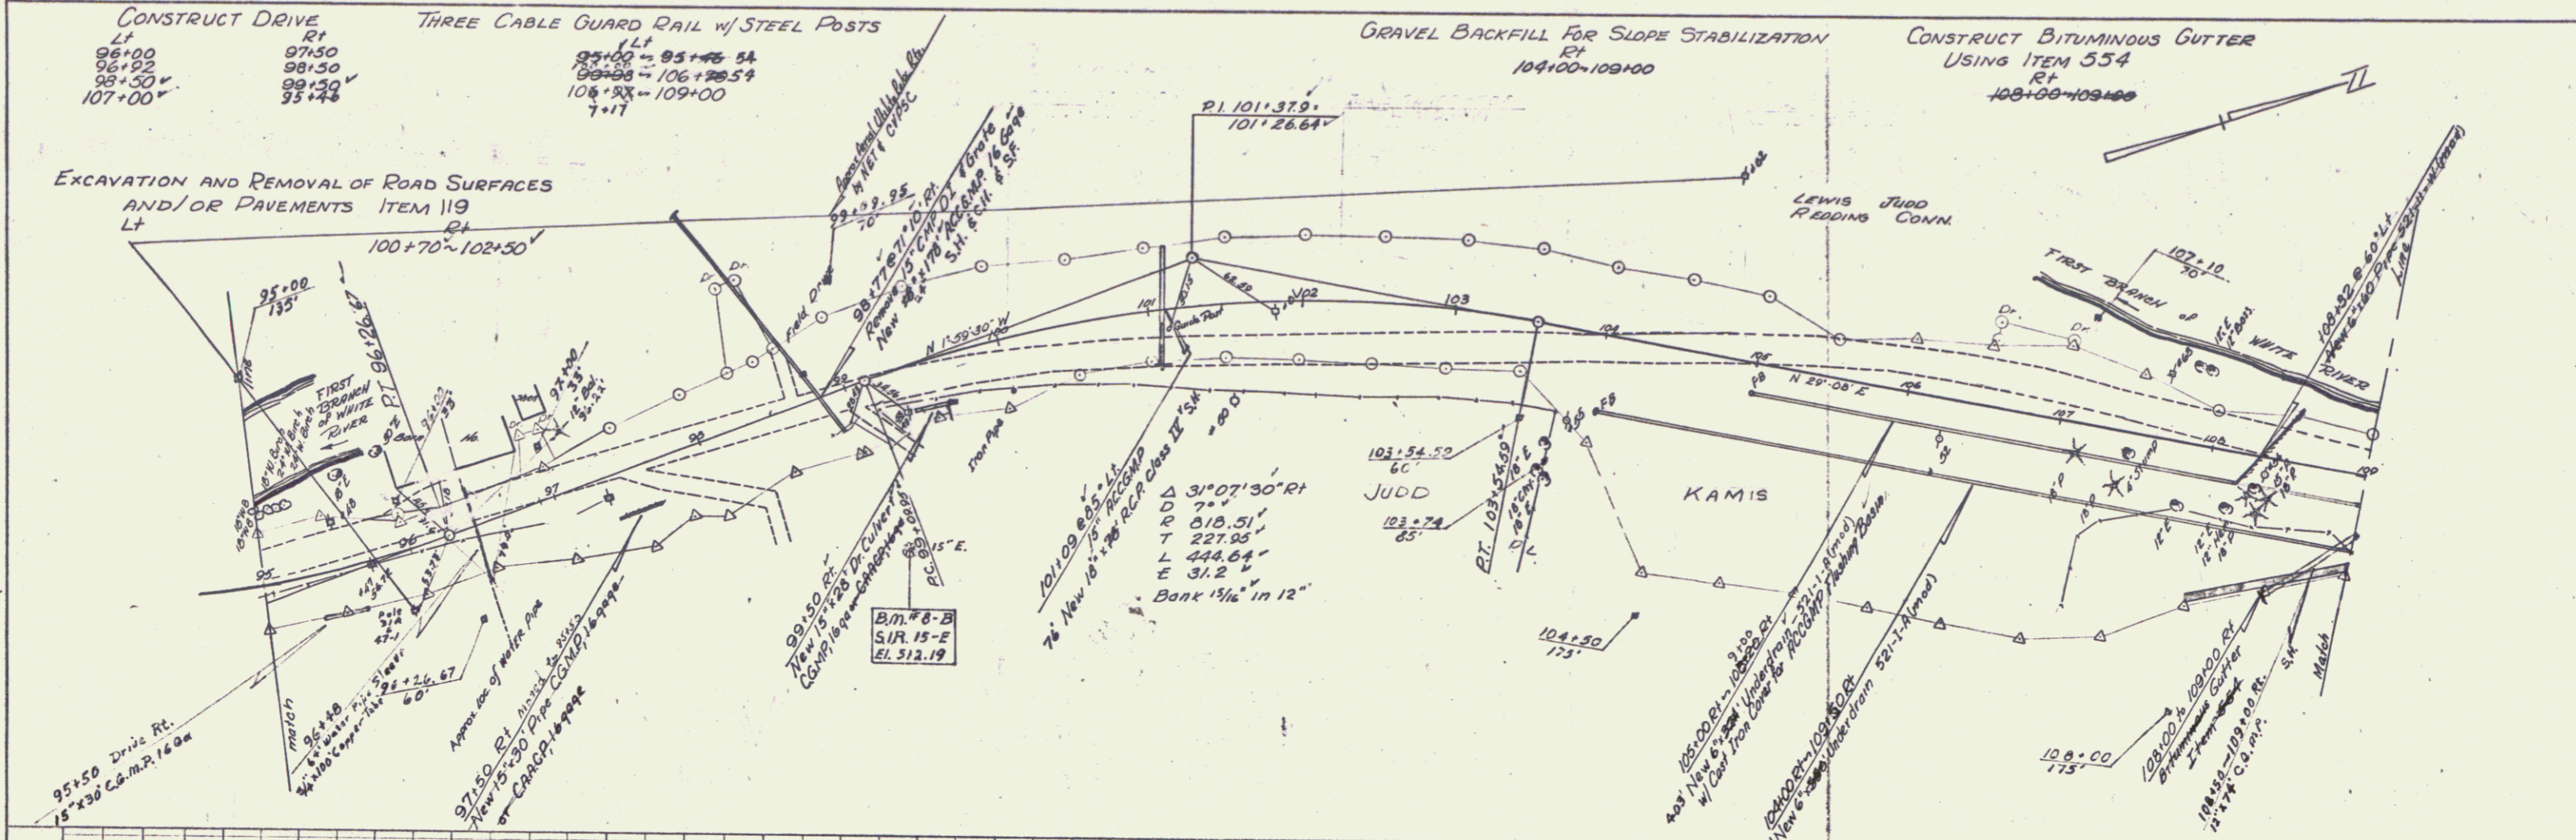

106+00  
 400' V.C.  
 517.80  
 33D 330+

ROYALTON-TUNBRIDGE  
 Project 5, No. 0162(1) ROW  
 Sheet 40 of 164