


Excavation & Removal of Road Surfaces  
And/or Pavements  
L.C.  
123+50 - 124+33.4  
121+96.0 - 122+00

DEMOLITION AND DISPOSAL OF BUILDING  
#19 109+34 Rt. Shed

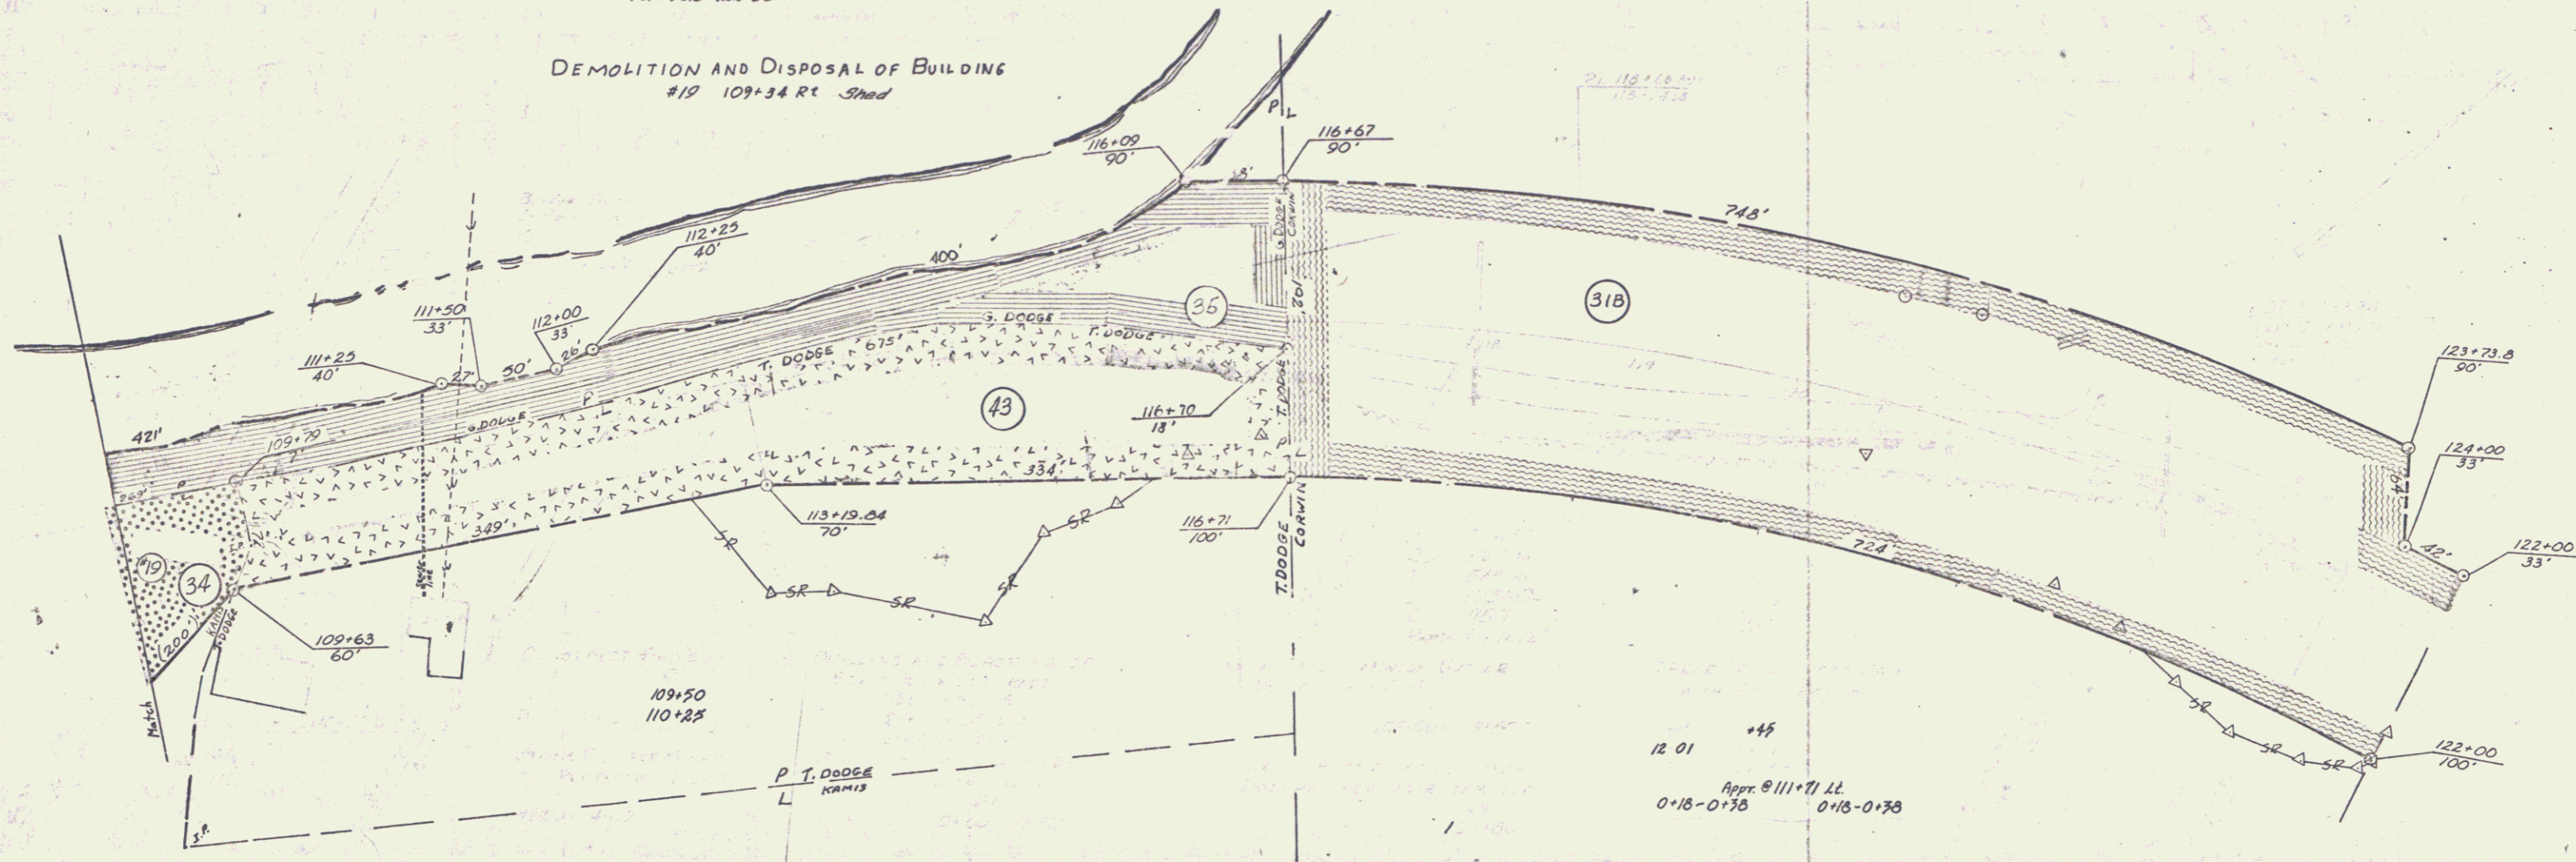

POOR ORIGINAL COPY