

CONSTRUCT DRIVE  
 LT 135+06-135+40 RT 140+00  
 137+50

UNCLASSIFIED CHANNEL EXCAVATION  
 RT 142+15-142+90

CONSTRUCT APPROACH  
 LT 142+33.1

DRILLING & BLASTING OF  
 SOLID ROCK SUBGRADE  
 LT 136+50-137+65  
 RT 140+00

THREE CABLE GUARD RAIL  
 W/ STEEL POSTS  
 LT 142+00-144+00


REMOVAL AND DISPOSAL OF  
 PRESENT GUARD RAIL  
 LT 139+72-140+22 RT 140+30-140+42  
 141+87-143+24

BRIDGE RAILING (FOR BRIDGE APPROACHES)  
 ITEM 572  
 LT 139+02-140+45 RT 140+25-140+51  
 141+61-141+92 141+96-143+05


STONE FILL FOR SLOPE PROTECTION  
 (LIGHT TYPE)  
 RT 142+15-142+90

EXCAVATION AND REMOVAL OF  
 ROAD SURFACES AND / OR  
 PAVEMENTS - ITEM 119  
 LT 135+00-135+70  
 136+20-137+28

$\Delta$  15° 01' LT  
 D 4'  
 R 1432.40'  
 T 188.79'  
 L 375.42'  
 E 12.4'  
 Bank 7/8" in 12"

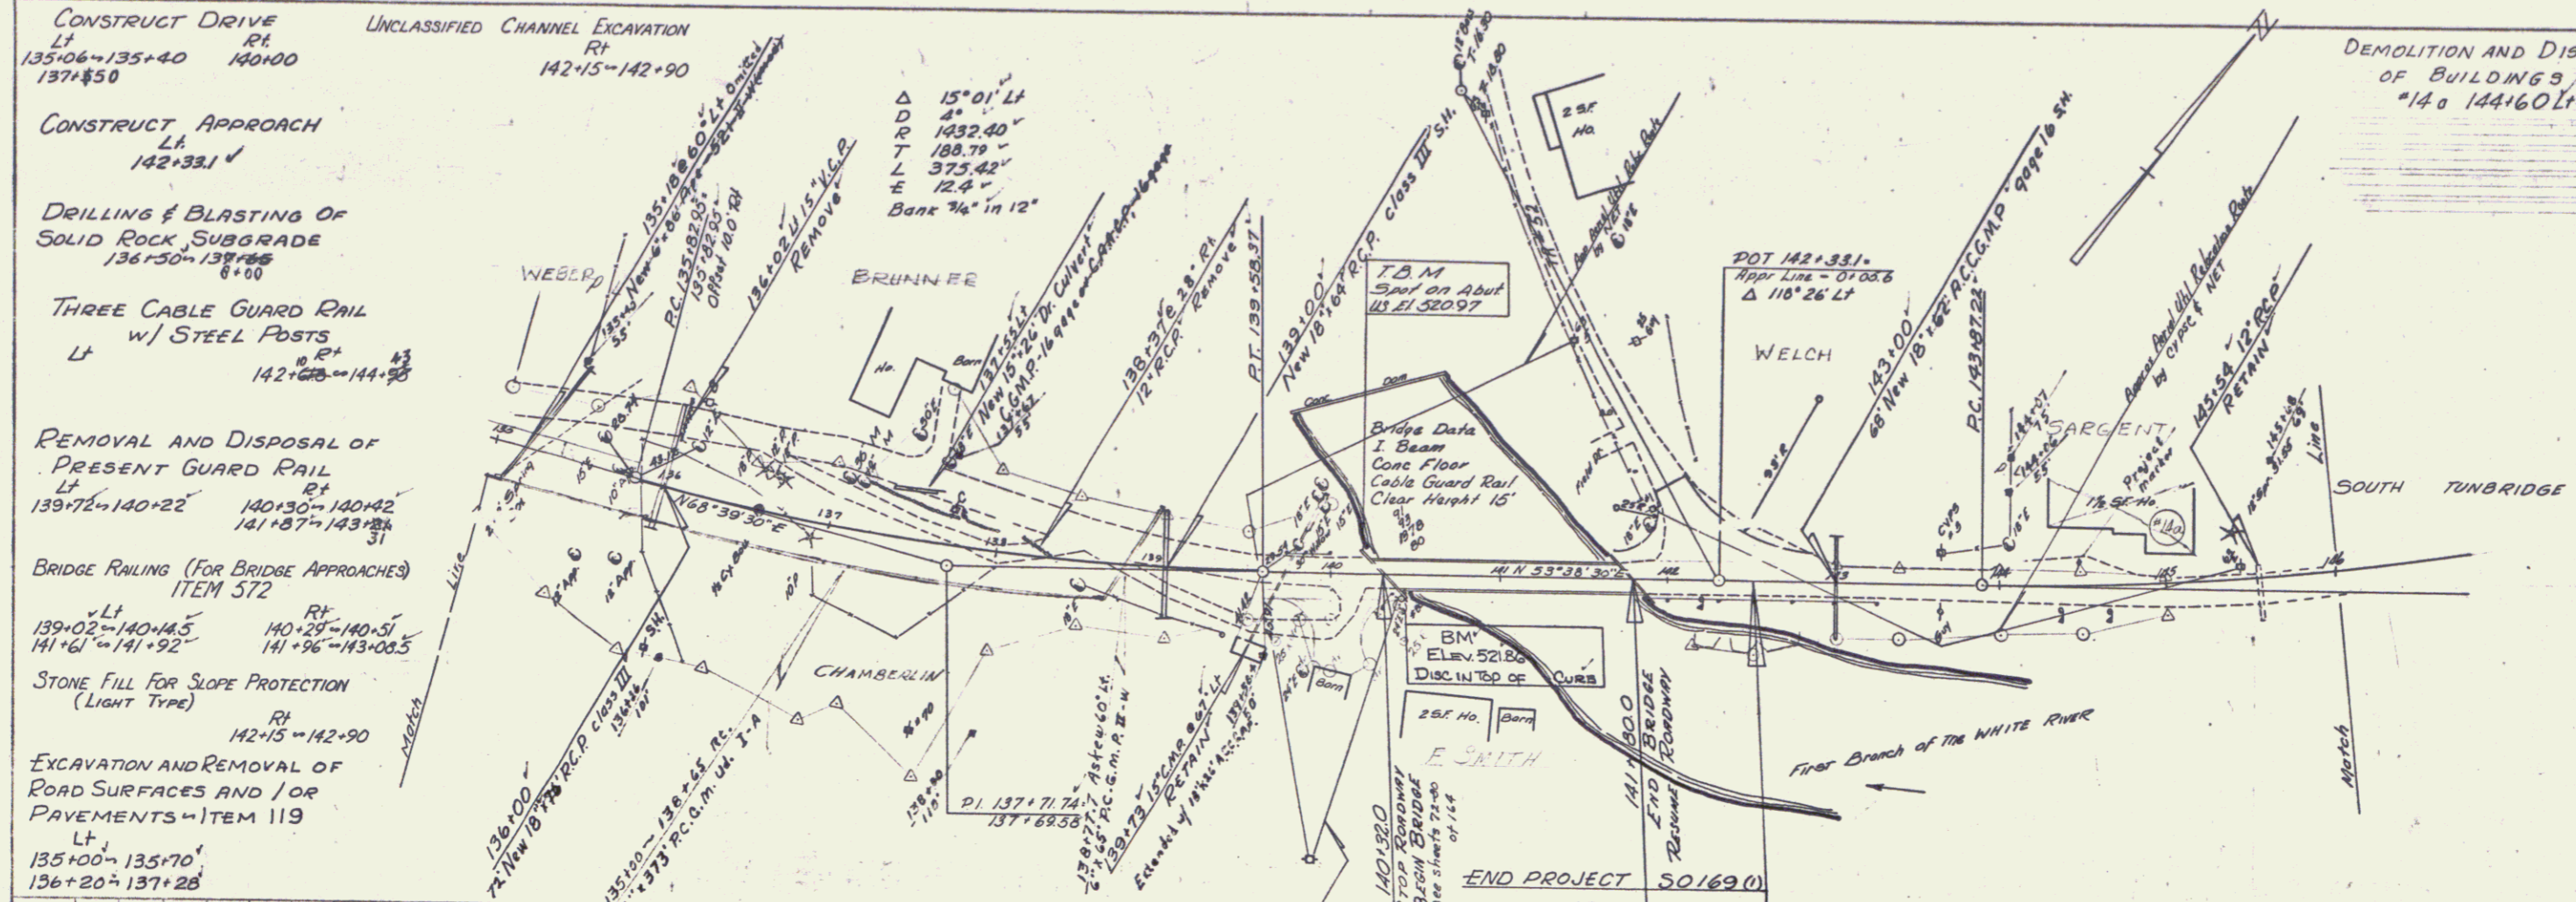

DEMOLITION AND DISPOSAL  
 OF BUILDINGS  
 #14 & 144+60 LT

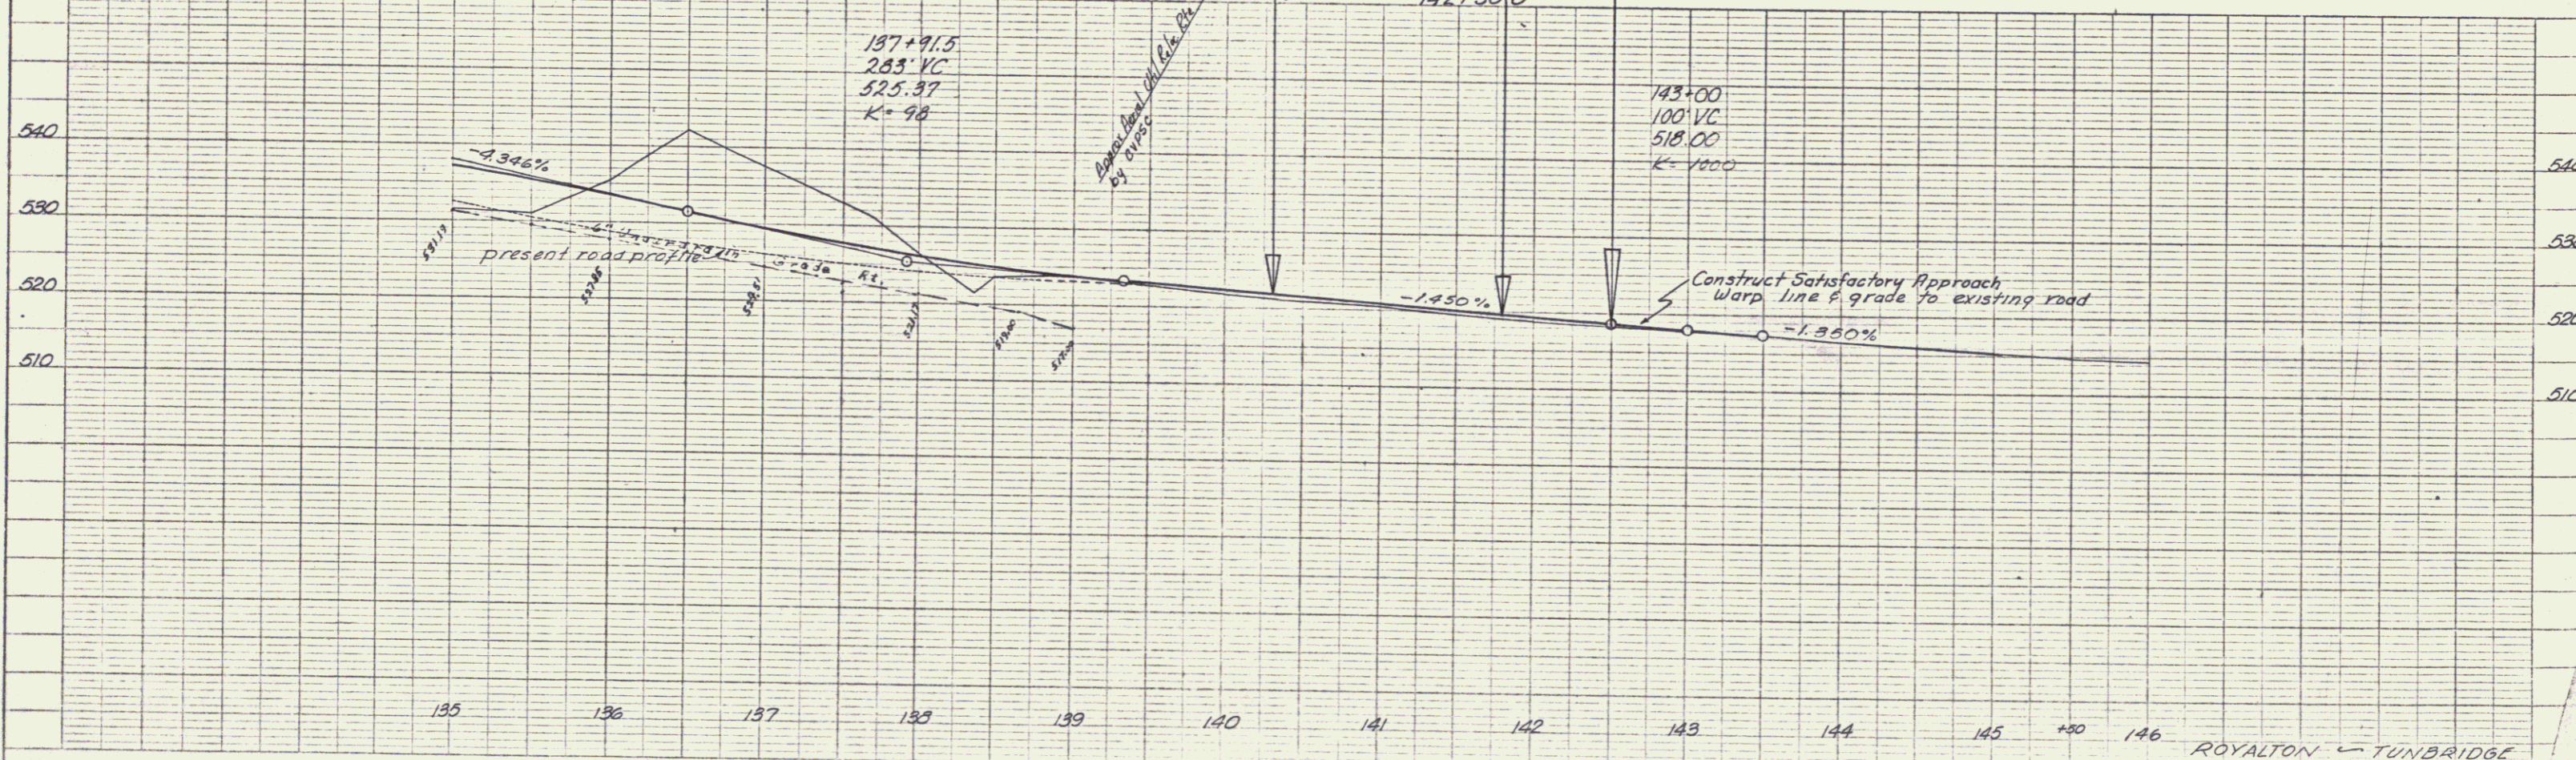

DATE: 4/10  
 BY: [Signature]  
 CHECKED BY: [Signature]  
 APPROVED BY: [Signature]

DATE: 5/85  
 BY: [Signature]  
 CHECKED BY: [Signature]  
 APPROVED BY: [Signature]

ROYALTON - TUNBRIDGE  
 PROJECT 3 0189 (1) ROW  
 Sheet 43 of 164