

STONE FILL FOR SLOPE PROTECTION (LIGHT TYPE) ITEM 512
Western Ave 32+00-34+00 Lt.

Construct Drives
W.A. 31+00 Lt
W.A. 31+00 Rt

CHAIN LINK FENCE (G)
30+00-31+50 Rt (Hill St)
2+50 Lt (Hill St) - 36+00 Rt
32+00-35+00 Lt

BITUMINOUS CONCRETE CURB
Item 555
30+00-33+50 Rt
31+40-34+70 Lt
Hill St App. 0+28-3+00 Rt

Granite Slope Edding
Western Ave 34+20-35+00 (Island)
Western Ave 35+60 Lt (Island)
U.S. 5 8+81-9+51 (Island)
U.S. 5 10+31-11+26 (Island)
Sias Ave 28+45-29+15 (Island)

EXCAVATION & REMOVAL OF ROAD SURFACES AND/OR PAVEMENTS, ITEM 119
Hill St 2+25-3+00 Lt

Property Line Fence w/ Steel Posts
30+00 Rt - Hill St. 3+25 Lt.

REMOVAL & DISPOSAL OF PRESENT GUARD RAIL, ITEM 549
Western Ave. 30+00-34+45 Lt
Hill St. 2+00 Lt - 3+00 Rt

STANDARD STEEL BEAM GUARD RAIL w/ STEEL POSTS ITEM 545-A
6' 3" Spacing
30+00 Rt - 3+70 Rt (Hill St)
3+36 - 3+40 B.S. Lt
2+52 Lt (Hill St) - 10+40 Rt (U.S. 5)

DEMOLITION & DISPOSAL OF BUILDING
ITEM 526
30+25 Lt - 19 Rt
30+50 Lt - 19 Rt
35+10 Rt - 22 Rt
2+15 Rt (Hill St) - 20


VERTICAL GRANITE CURB
Western Ave 34+70 Lt - U.S. 5 8+00 Rt
Hill St. 0+05 Lt - U.S. 5 11+04 Rt
U.S. 5 11+25 - 12+34 Rt
Sias Ave 28+40 - 29+00 Rt
U.S. 5 8+00 Lt - Sias Ave 29+24 Lt

PLAIN GUARD RAIL
ITEM 540
Hill St. 3+00 Lt

STANDARD CONCRETE STEPS
ITEM 401-B
E. Main St - 10+97 Lt
Sias Ave. 29+05 Rt

BITUMINOUS CONCRETE SIDEWALK
ITEM 562
Hill St. 0+85 Lt - U.S. 5 12+34 Rt
W.A. 30+00 Lt - U.S. 5 9+00 Rt.

U.S. 5 POT. 10+0000
Sias Ave. POT. 28+1422
Western Ave. POT. 36+1544

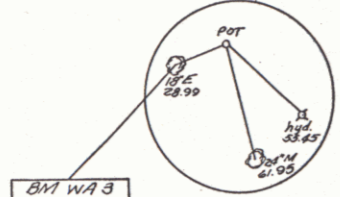


BM H-1
U.S. Elev.
706.63

Approx. Aerial Utilities Relocation
Route by Citizens Utilities Co.,
NET. & T. Co., Newport Cablevision,
Inc., City of Newport (Fire Alarm)



NEWPORT
SURVEYED BY: Fall DATE 2/64
DRAWN BY: Tramply DATE 4/64
TRACED BY: WJ DATE 9/82
SINGLE STAGE CONSTRUCTION
PROJ. U.S. NO. 0317(3)
SHEET 91 OF 298

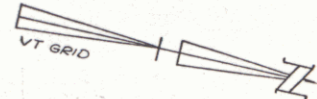

NEWPORT CITY WATER & SEWER MAINS
0+00 Lt. 3+00 (HILL ST)
28+25 Rt - 30+55 Lt. (WESTERN AVE.)
28+14 - 30+26 (SIAS AVE.)
8+80 - 12+48 (E. MAIN ST)
RELOCATION & ADJUSTMENTS BY
HIGHWAY PRIME CONTRACTOR,
SEE SHEETS 93 & 94 OF 298

Sias Ave. 30+26
End Construction

Sias Ave. 30+73
Sias Ave. 30+73

