

INDEX OF SHEETS

1	TITLE
2-3	ALIGNMENT AND TIES
4	TYPICAL SECTIONS
5-7	SUMMARY OF QUANTITIES
8-9	ITEM DETAIL AND DRAINAGE
10-15	EARTHWORK AND GRADE
16-3	BLANK
32-44	R.O.W. DETAIL-MONTPELIER
45	R.O.W. DETAIL-MIDDLESEX
46-56	PLAN AND PROFILE
57	GOULD HILL BRIDGE PLAN SHEET
58-61	UTILITIES
61A-61G	SIGN DETAIL SHEET
62-69	BR SERIES 740 @ 157+75
70-74	BR SERIES 750 @ 208+5.5
75-88	BR SERIES 760 @ 227+26.75
82	BLANK
83	A-61 SOLID ROCK EXCAVATION 8-26-B1R
84	B-5 TYPICAL SLOPE ROUNDING 12-6-71
85	B-11 UNDERDRAIN IN SHATTERED ROCK 12-12-74R
86	C-1 CURBS, BITUMINOUS SIDEWALK 12-16-80R
87	D-2 HEADWALLS, UNDERDRAIN 12-16-76R
88	D-3 GUTTERS 4-27-73R
89	D-4 METAL END SECTIONS AND FLUSH BASINS 7-24-75R
90	D-6 DROP INLET 4-4-73 R
91	D-8 DROP INLET 12-6-71
92	D-9 DROP INLET TOPS 12-6-71
93	D-10 DROP INLET TOPS 12-6-71
94	D-11 CAST IRON GRATE TYPE A 8-24-B1R
95	D-12 CAST IRON GRATE TYPE D 10-6-78R
96	D-16 CAST IRON GRATE TYPE B 11-14-72R
97	E-2 ROAD CONSTRUCTION APPROACH SIGNS 3-4-81R
98	E-6 ON PROJECT SIGNS 4-1-80R
99	E-7 DELINEATION AND BARRICADES 2-12-82 R
100	E-7A BREAKAWAY BARRICADE 4-8-82
100A	E-13 ROUTE MARKER 2-3-82R
101	E-15 REGULATORY SIGNS 7-29-81
102	E-17 REGULATORY SIGNS 1-8-74R
103	E-20 WARNING SIGN 5-16-78R
104	E-23 GUIDE SIGNS 12-29-71
105	E-24A SIGN SUPPORTS 1-8-81R
106	E-25 SIGN SUPPORTS 6-17-81R
107	E-29 SIGN PLACEMENT 8-25-81R
108	E-34 TRAFFIC SIGNAL DETAIL 8-23-82R
109A	E-36 VEHICLE DETECTOR LOOP 8-23-82R
109B	G-1 GUARD RAIL, STEEL BEAM 12-16-80R
110	G-10 GUARD RAIL, STEEL BEAM 12-16-80R
111	G-4 MARKER POSTS 5-25-82R
112	G-11 ANCHOR FOR STEEL BEAM GUARD RAIL 5-29-79R
113	J-1 BOUNDARY MARKERS 6-27-80
114	T-1 TEMPORARY EROSION CONTROL 12-7-76R
115	T-2 TEMPORARY EROSION CONTROL 7-5-72
116	SB-R6-82 BRIDGE RAILING 6-18-82R
117	SCB-DI-75 GENERAL INFORMATION 9-14-81R
118	SCB-D6-75 BRIDGE DETAILS 1-3-79R
119	SCB-D9-71 CURTAIN WALLS 1-27-75R
120-191	CROSS SECTIONS

RECORD PLANS
 CONTRACT DATED - FEB. 22, 1983
 CONSTRUCTION BEGAN - FEB. 25, 1983
 COMPLETED & ACCEPTED - JAN 3, 1985
 CONTRACTOR - EARTH CONSTRUCTION INC.
 RESIDENT ENGINEER - JACQUES G. COUTURE
 RECORD PLANS - JAMES F. MARSCHELL

STATE OF VERMONT
 AGENCY OF TRANSPORTATION





PROPOSED IMPROVEMENT
 CITY OF MONTPELIER - TOWN OF MIDDLESEX

MATERIAL SUPPLIERS
 GRAN BACKFILL FOR STRUCTURES - ALEXANDER PIT, MONTPELIER, VT.
 SUBBASE OF GRAVEL - ALEXANDER PIT, MONTPELIER, VT.
 PLANT MIX BASE COURSE - COOLEY, BERLIN, VT.
 BITUMINOUS CONC. PAVEMENT - COOLEY, BERLIN, VT.
 CONCRETE - ANDERSON, BERLIN, VT.
 REINFORCING STEEL - PIONEER VALLEY STEEL CO., MEDFORD, MASS.
 CGMP - ARCH-LANE METAL PRODUCTS, BALSTON SPA, NY.
 WATER REPELLENT - SONNEBORN BUIL. PRO., MASPETH, NY.
 SHEET MEMBRANE WATERPROOFING - A.D. ROSSI, ST. J., VT.
 ACCGMP - LANE METAL PRODUCTS, BALSTON SPA, NY.
 RCP - FIELD CONCRETE PIPE CO., WAUREGAN, CT.
 CGMP - LANE METAL PRODUCTS, BALSTON SPA, NY.
 CAST IRON GRATE - E. L. LEBARON, BROCKTON, MASS.
 6" UNDERDRAIN - LANE METAL PRODUCTS, BALSTON SPA, NY.
 GUARD RAIL - Q.W. HUBBEL & SONS, NEW HARTFORD, N.Y.
 ABS SEWER PIPE, SOLID WALL - ARMO INC. MIDDLETOWN, OHIO
 SEAMLESS COPPER WATER TUBE - CERRO COPPER PRODUCTS, E. ST. LOUIS, ILL.
 DUCTILE IRON PIPE, CEMENT LINED - GRIFFIN PIPE PRODUCTS CO., FLORENCE, N.J.
 EXTENSION SERVICE BOX & CURB STOP - E.J. PRESCOTT INC., MONTPELIER, VT.
 GATE VALVE & HYDRANT - E. J. PRESCOTT INC., MONTPELIER, VT.
 PIPE INSULATION - E. J. PRESCOTT INC. MONTPELIER, VT.


COUNTY OF WASHINGTON

VT. ROUTE 12 - (ELM STREET)

PROJECT MONTPELIER M 6400(8) (VT ROUTE 12) BEGINS AT A POINT ON ELM ST. IN MONTPELIER 2.101 MILES SOUTH OF THE MONTPELIER-MIDDLESEX TOWN LINE AND EXTENDS NORTHERLY 2.101 MILES. MIDDLESEX RS 0241(12) BEGINS ON VT ROUTE 12 AT THE MONTPELIER-MIDDLESEX TOWN LINE AND EXTENDS NORTHERLY 0.028 MILES.
 1979 ADT = 1970 3000
 2000 ADT = 2840-4320
 2000 DHV = 400-570
 V = 40 MPH
 LENGTH OF MONTPELIER PROJECT M 6400(8) 11,092.68 FT. = 2.101 MILES
 LENGTH OF MIDDLESEX PROJECT RS 0241(12) 150 FT. = 0.028 MILES
 LENGTH OF CONTRACT 11,242.68 FT. = 2.129 MILES

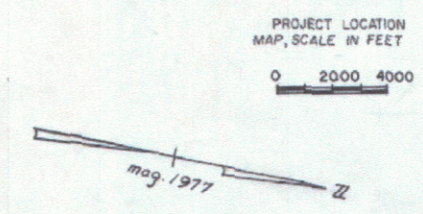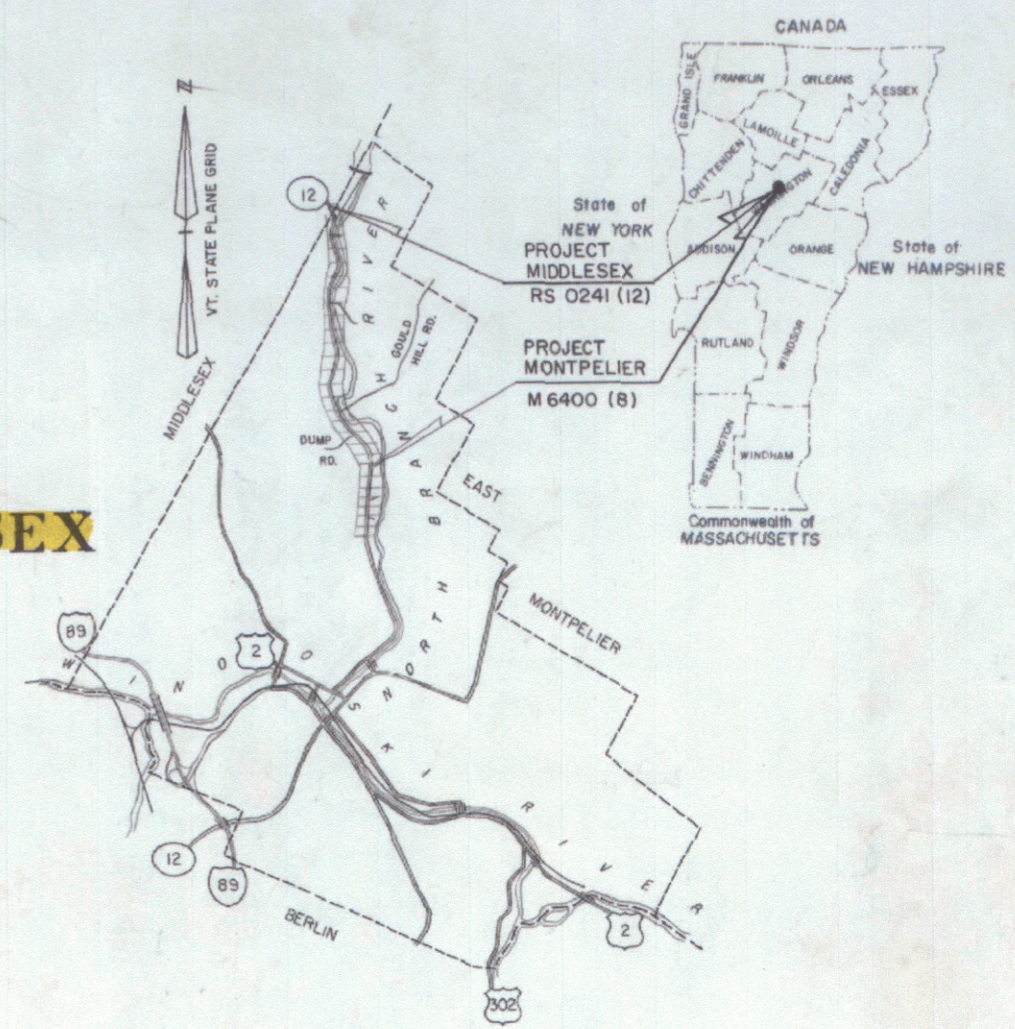

RECORD PLANS - MIDDLESEX RS 0241(12) - SEE ABOVE
 MATERIAL SUPPLIERS - MIDDLESEX RS 0241(12) - SEE ABOVE

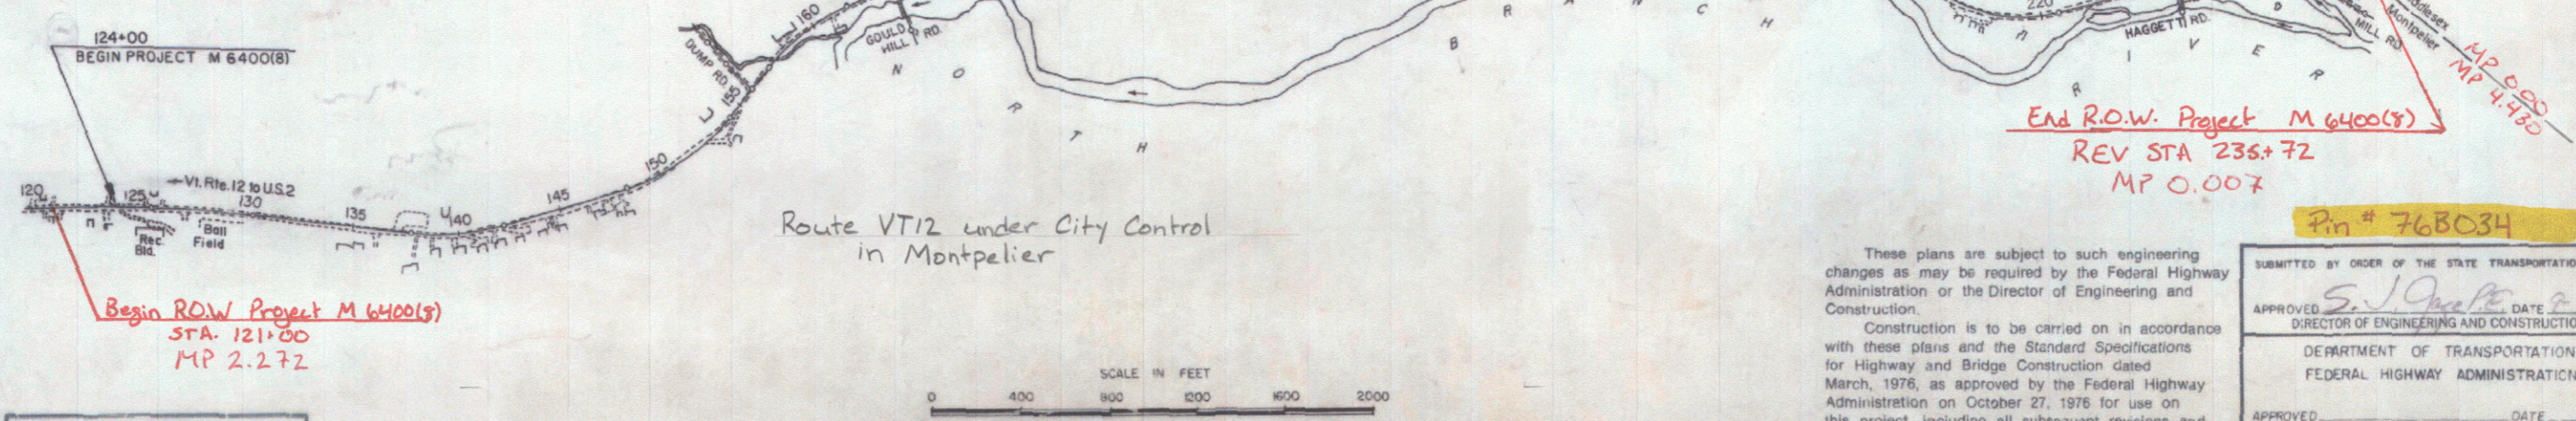


CONVENTIONAL SIGNS

---	COUNTY LINE
---	TOWN LINE
---	LIMITS OF ACCESS
X	POINT OF ACCESS
---	FENCE LINE
---	STONE WALL
---	TRAVELED WAY
---	GUARD RAIL
---	RAILROAD
---	SURVEY LINE
---	CULVERT
○	POWER POLE
○	TELEPHONE POLE
○	TREES
---	CONTROL OF ACCESS
---	PROPERTY LINE
---	R.O.W. TAKING LINE
○	SLOPE RIGHTS
○	TOP OF CUT
○	TOE OF SLOPE

DATUM

VERTICAL	NGVD 1929
HORIZONTAL	N/A

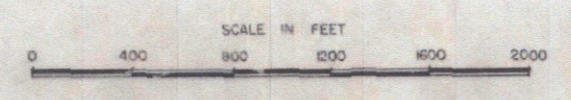

End R.O.W. Project M 6400(8)
 REV STA 235+72
 MP 0.007

Pin # 768034

These plans are subject to such engineering changes as may be required by the Federal Highway Administration or the Director of Engineering and Construction.
 Construction is to be carried on in accordance with these plans and the Standard Specifications for Highway and Bridge Construction dated March, 1976, as approved by the Federal Highway Administration on October 27, 1976 for use on this project, including all subsequent revisions and such revised specifications and special provisions as are incorporated in these plans.

SUBMITTED BY ORDER OF THE STATE TRANSPORTATION BOARD

APPROVED: *S. J. O'Connell* DATE: *5/28/85*
 DIRECTOR OF ENGINEERING AND CONSTRUCTION

DEPARTMENT OF TRANSPORTATION
 FEDERAL HIGHWAY ADMINISTRATION

APPROVED: _____ DATE: _____
 DIVISION ADMINISTRATOR

PROJECT M 6400(8)
 RS 0241(12)
 SHEET 1 OF 19 SHEETS

PWS 1056