



| | |
|-----------|--|
| DATE | |
| BY | |
| PROJECT | |
| LOCATION | |
| SCALE | |
| NOTE BOOK | |
| NO. | |
| PLAN | |
| DATE | |
| BY | |
| PROJECT | |
| LOCATION | |
| SCALE | |
| NOTE BOOK | |
| NO. | |

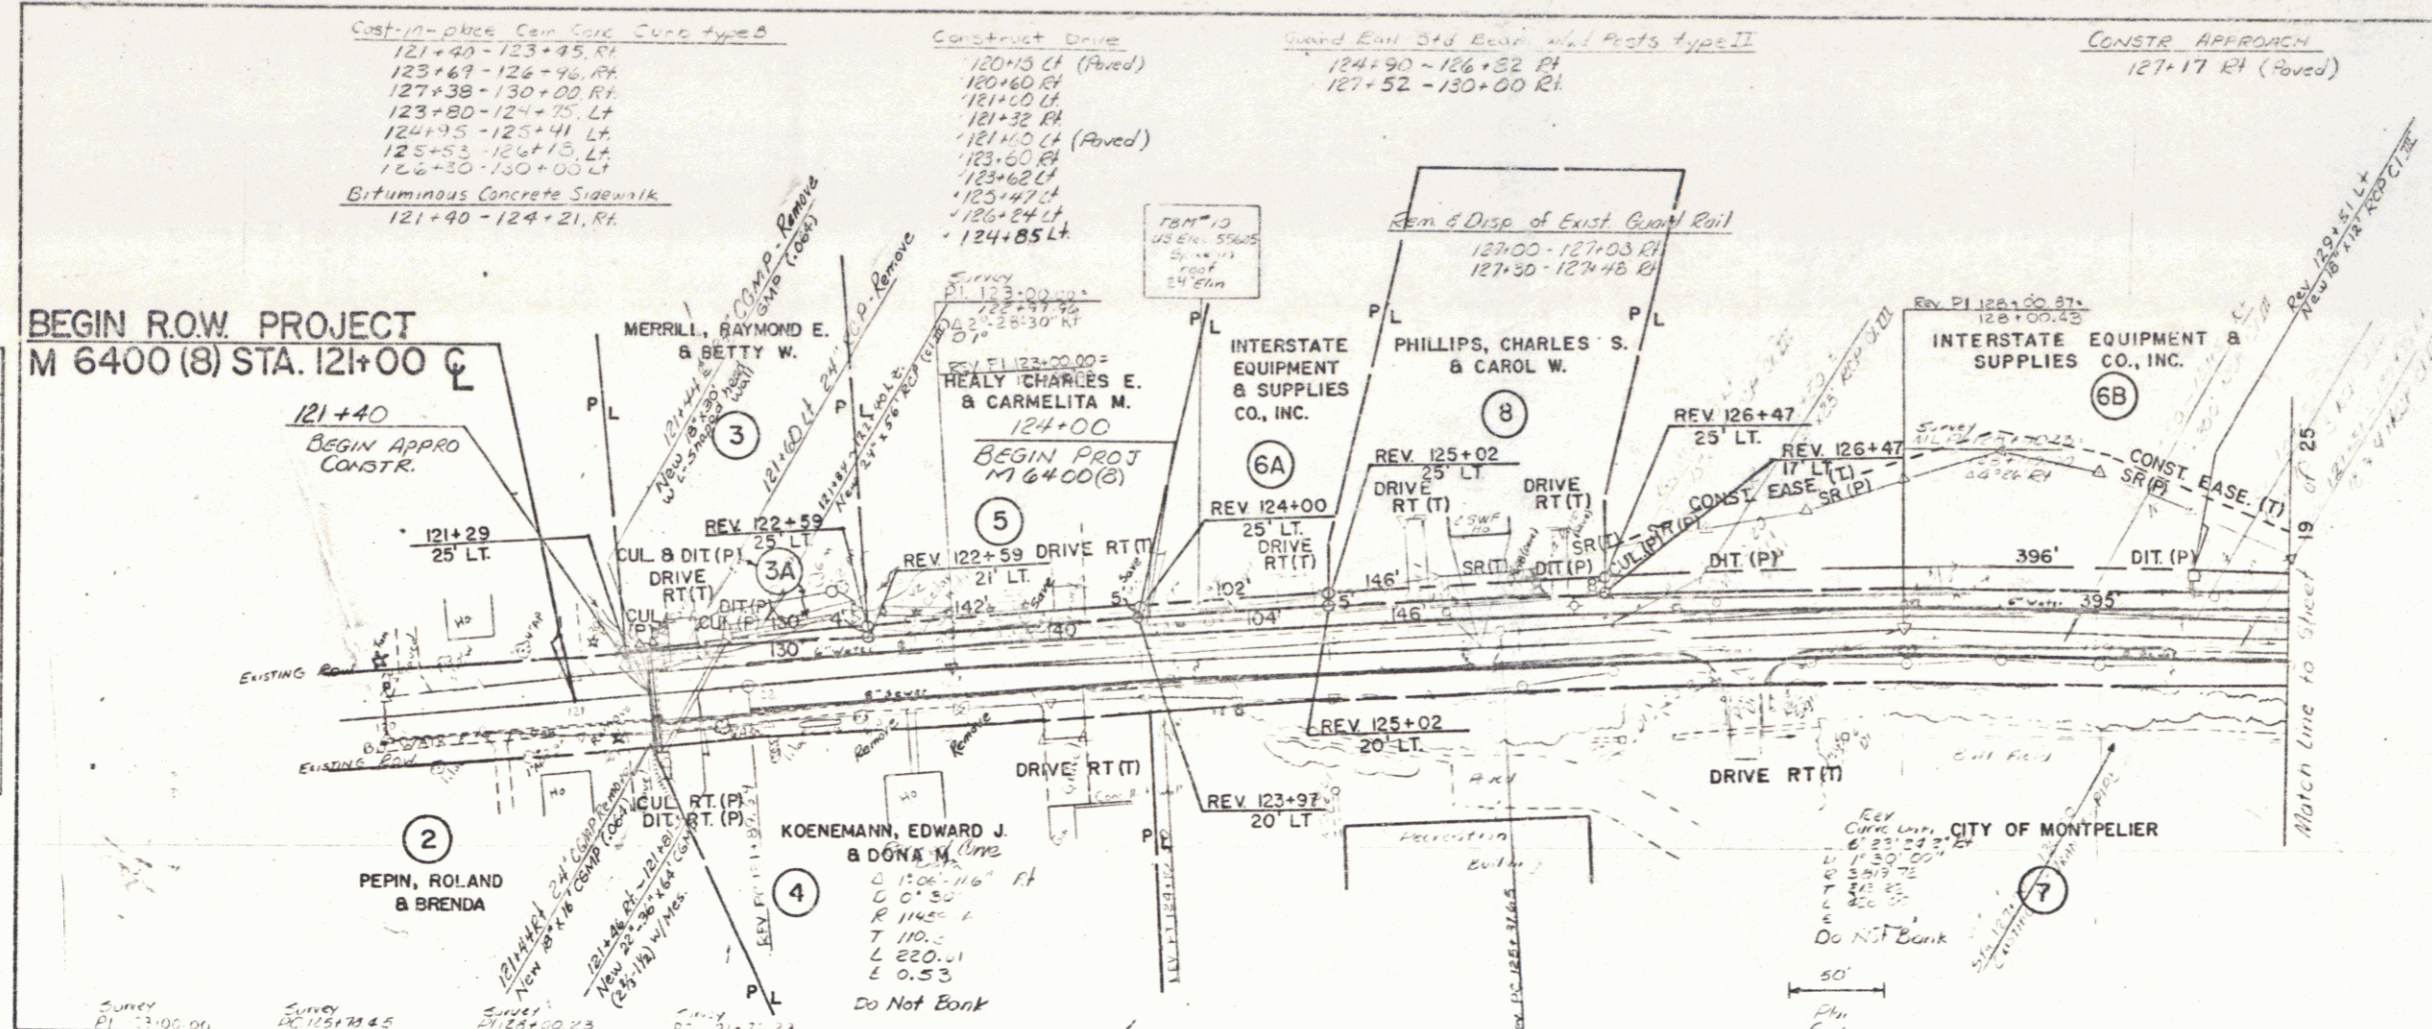

| | |
|-----------|--|
| DATE | |
| BY | |
| PROJECT | |
| LOCATION | |
| SCALE | |
| NOTE BOOK | |
| NO. | |
| PROFILE | |
| DATE | |
| BY | |
| PROJECT | |
| LOCATION | |
| SCALE | |
| NOTE BOOK | |
| NO. | |

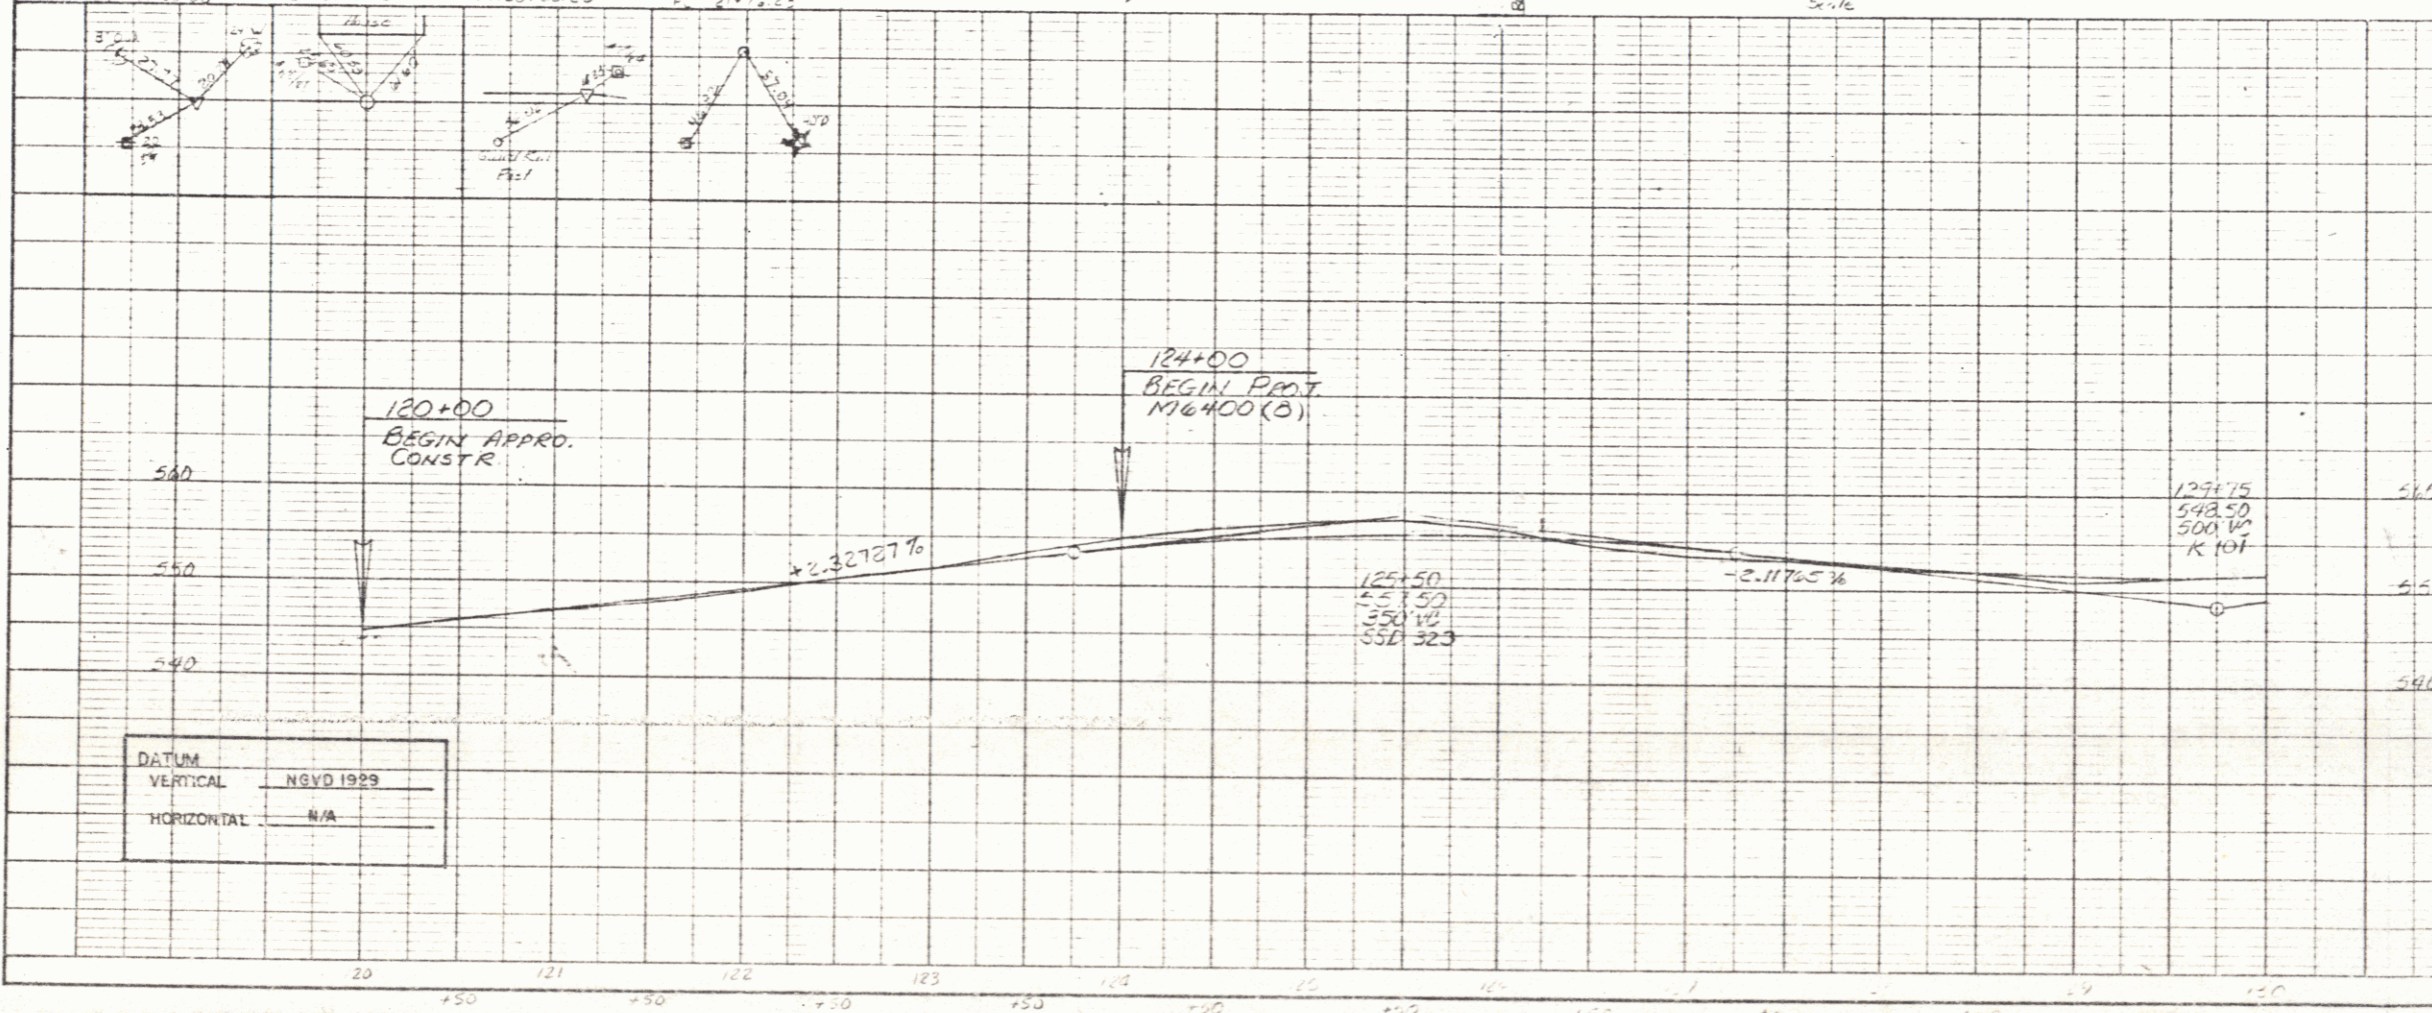

DATUM
 VERTICAL NGVD 1929
 HORIZONTAL N/A

MAY 27 1985
 Elm Street
 Drawn by Sweeney & Co
 Traced by Sweeney & Co
 Montpelier
 M6400 (8)
 Sheet 18 of 25