


PLAN  
 1088 BOOK  
 No. 1088

PROFILE  
 1088 BOOK  
 No. 1088

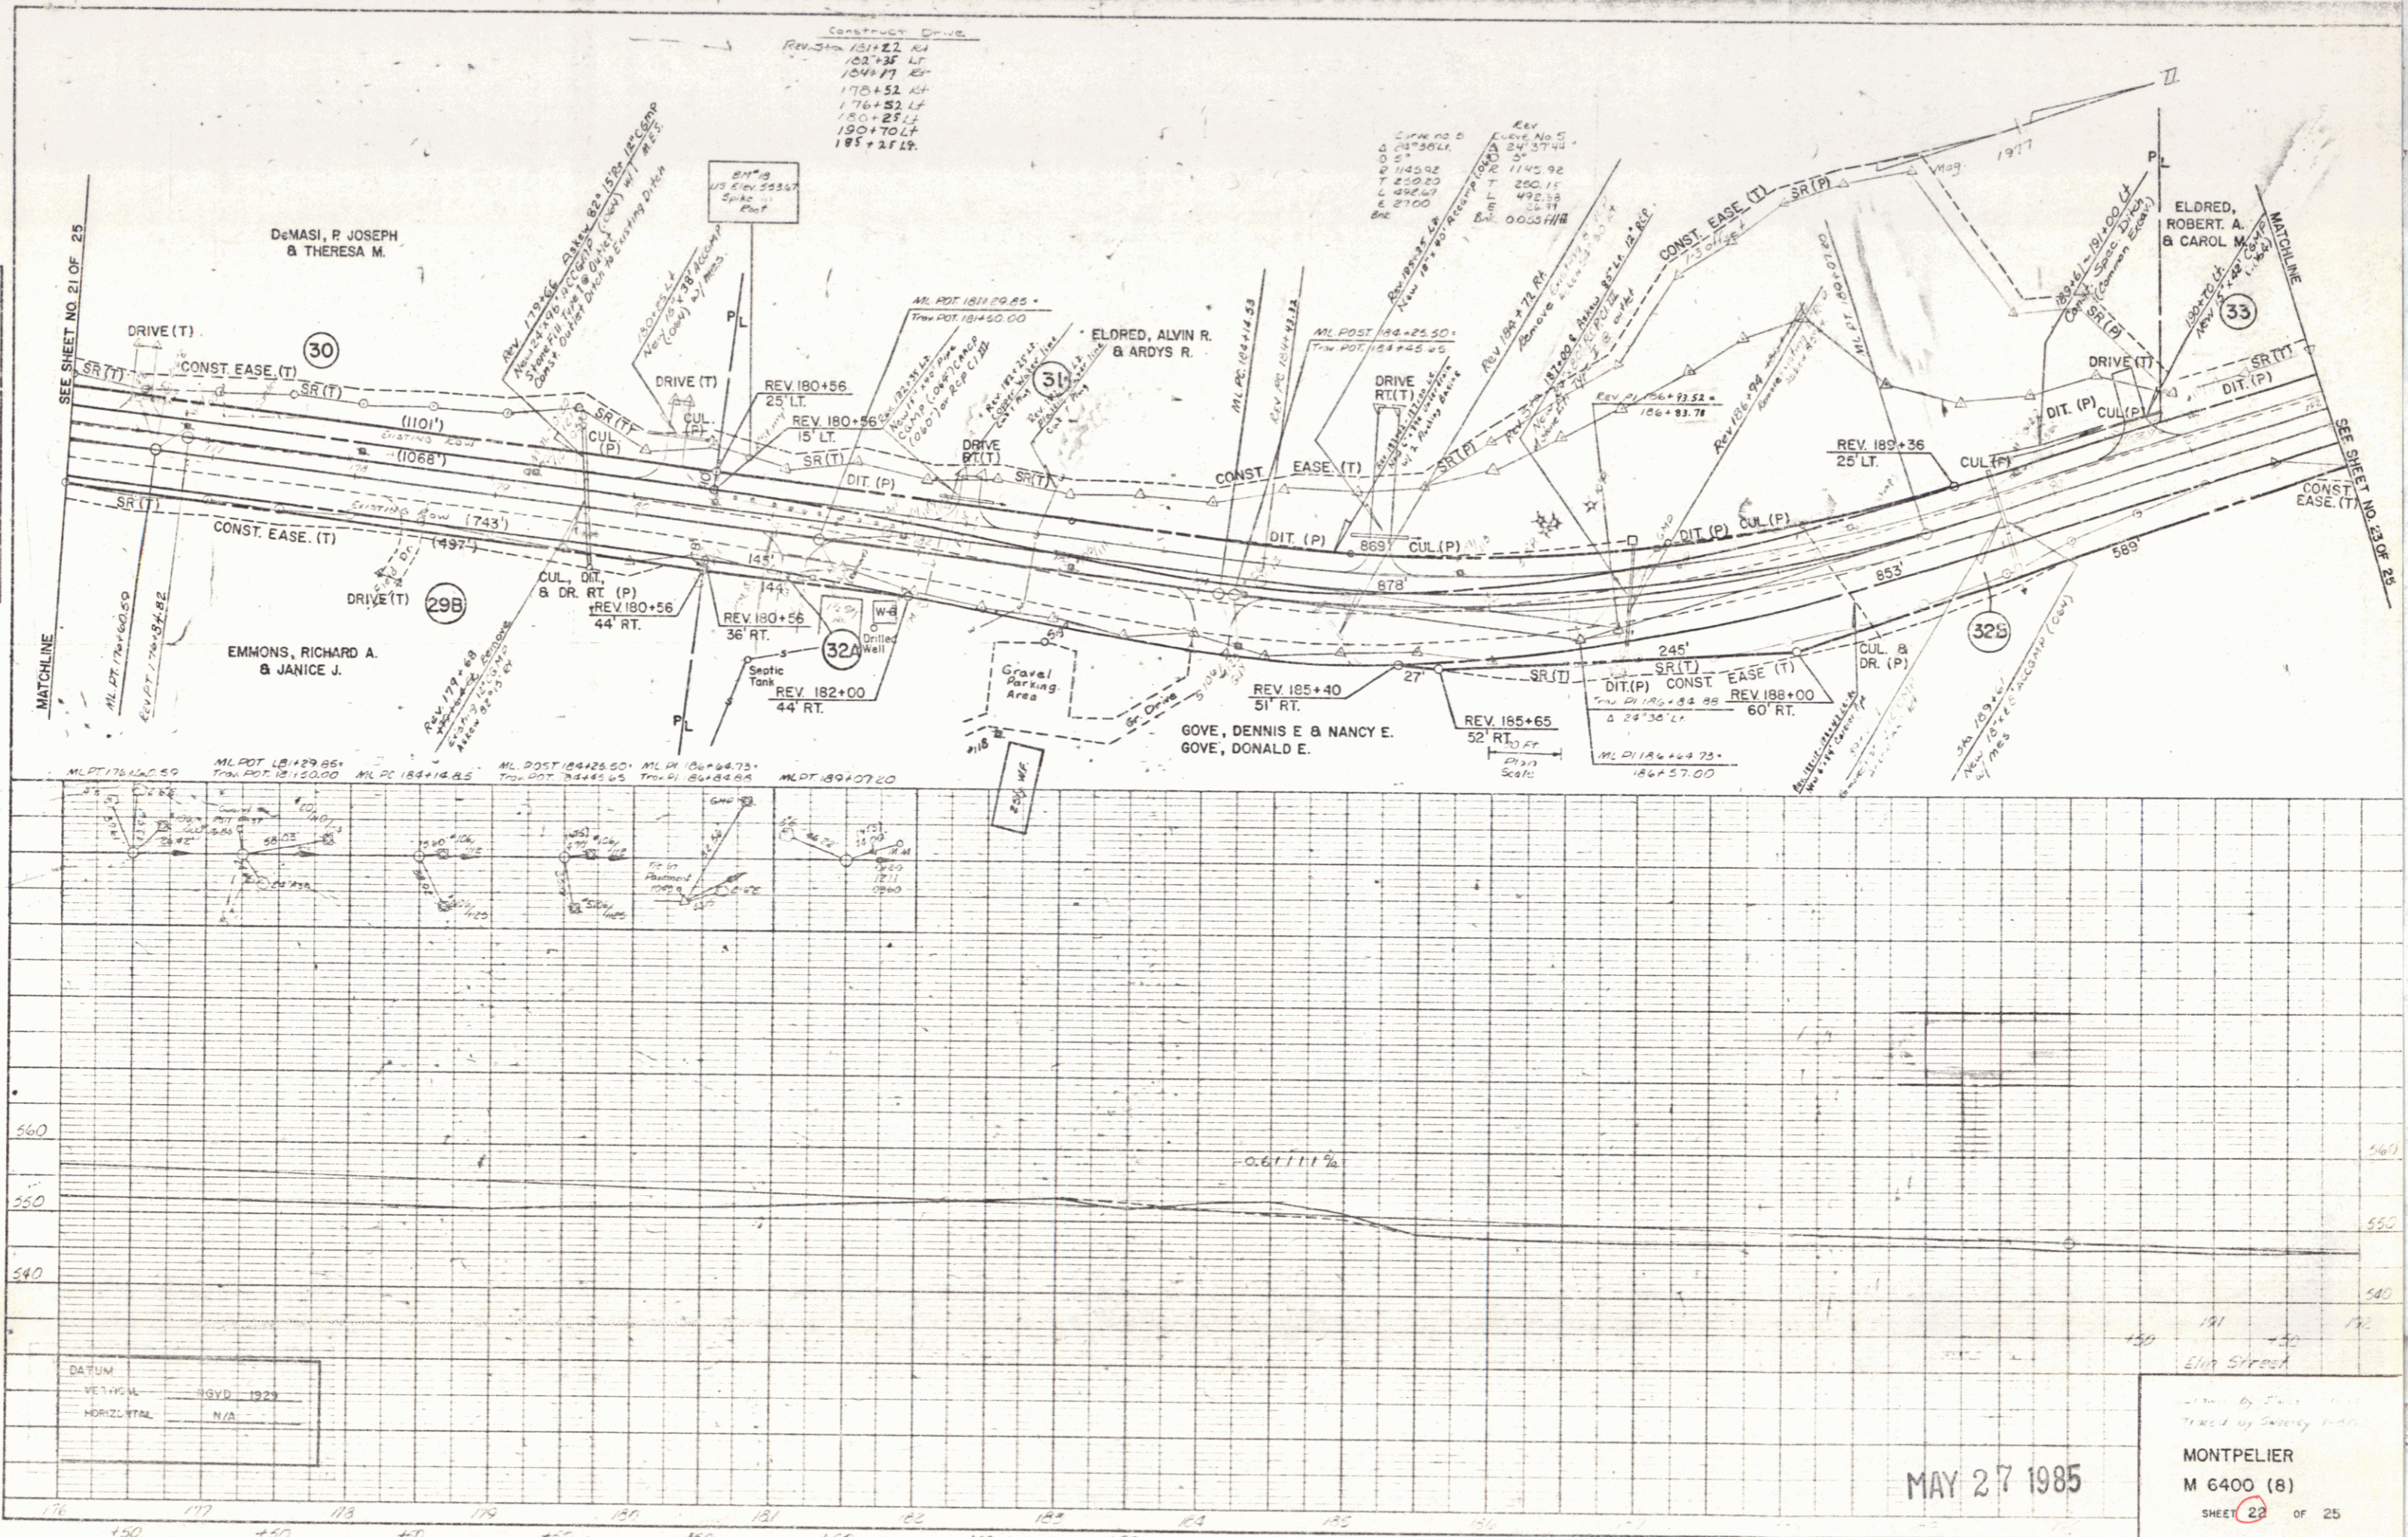

MAY 27 1985

MONTPELIER  
 M 6400 (8)  
 SHEET 22 OF 25

22