


PLAN
NOTES

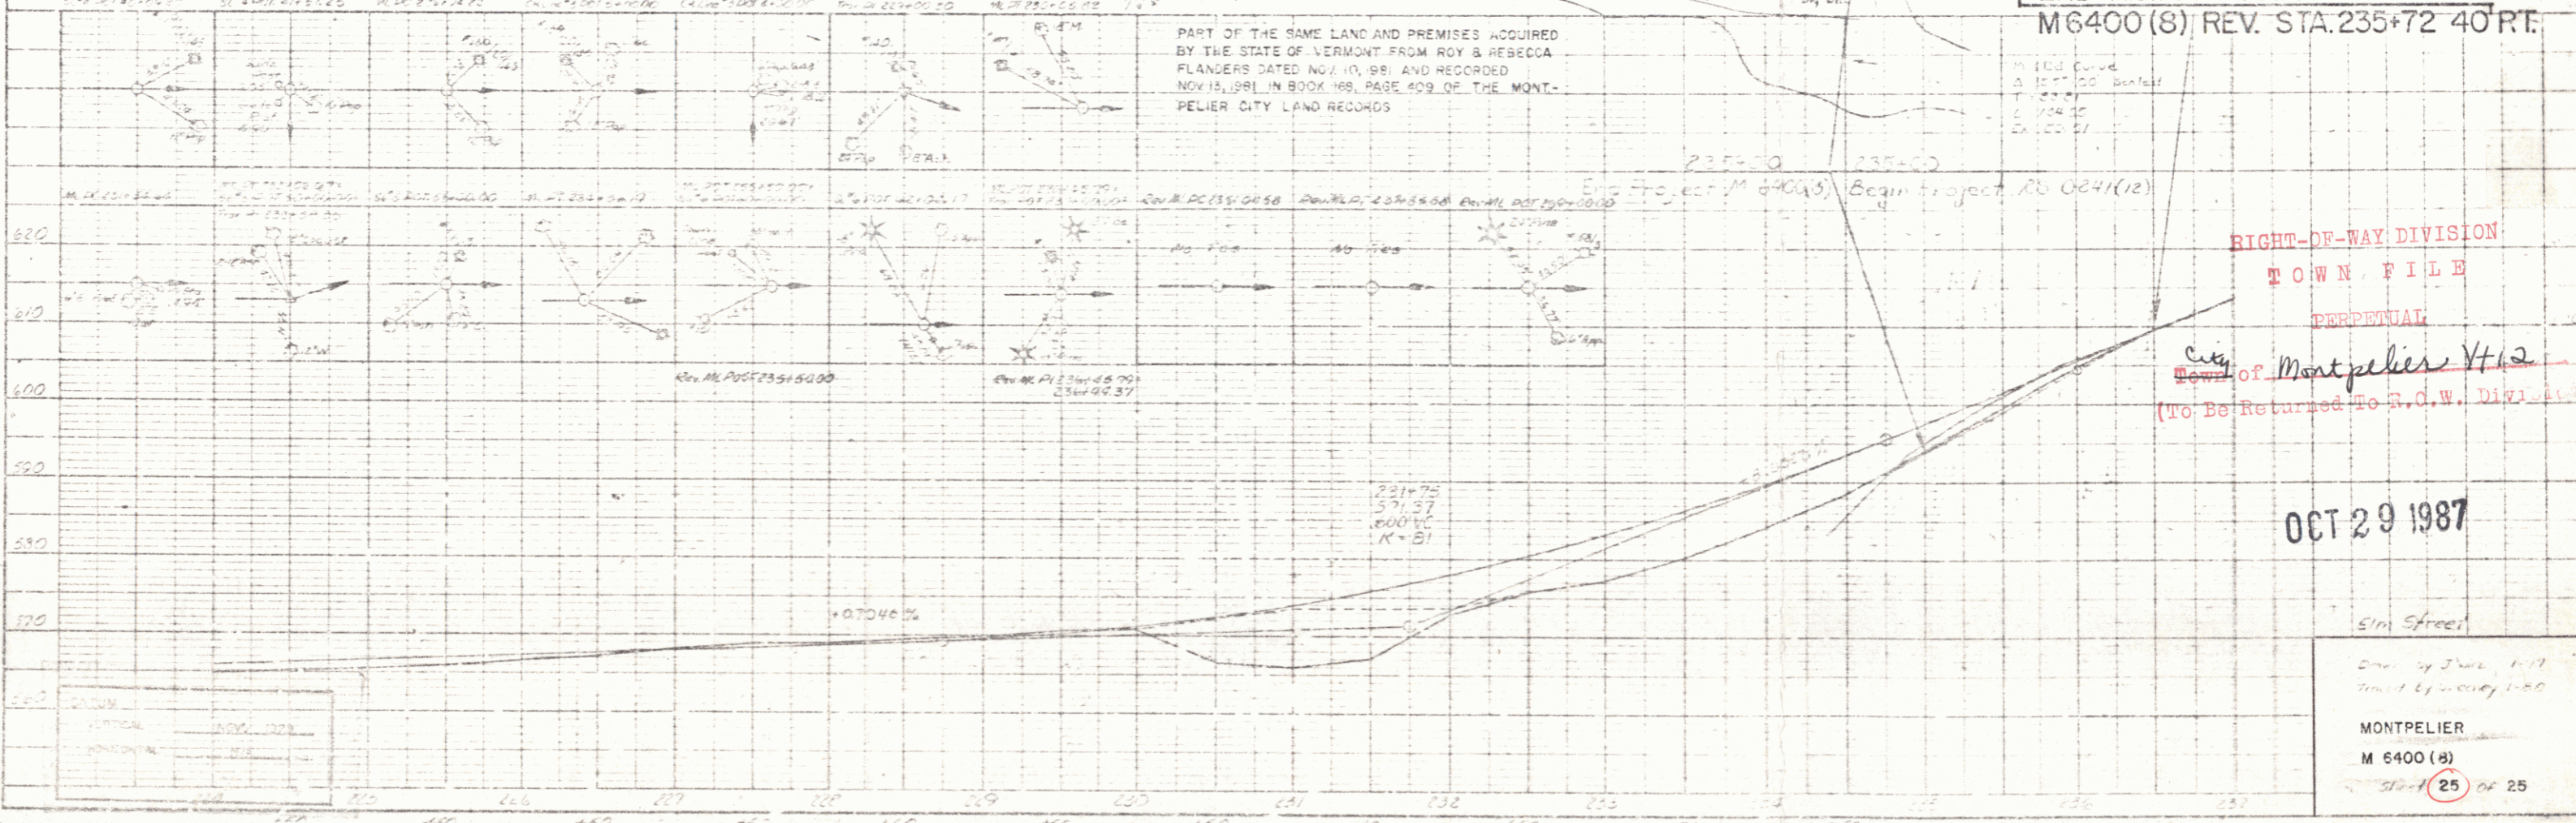

PROFILE
NOTES