

SPECIAL DITCH
(To be paid under item 203.17)
Lt 372+00 ~ 372+50 Rt

GUARD RAIL, THREE CABLE
w/ LIGHT WOOD POSTS
Lt 377+50 ~ 383+00 Rt



STONE FILL Type II
Lt 379+94 ~ 380+06 Rt
Lt 377+75 ~ 383+00 Rt

UNCLASSIFIED CHANNEL
EXCAVATION
Lt 377+75 ~ 383+00 Rt

ALL DRIVES AS INDICATED ON
PLANS ARE SUBJECT TO PER-
MITS PURSUANT TO TITLE 19,
SECTION 43, V.S.A.

CONSTRUCT TURNOUT
Lt 372+00 ~ 376+00 (20' Wide)
Rt

CONSTRUCT DRIVE
Lt 373+50 (16' Wide)
Rt

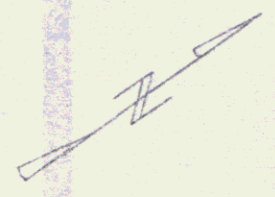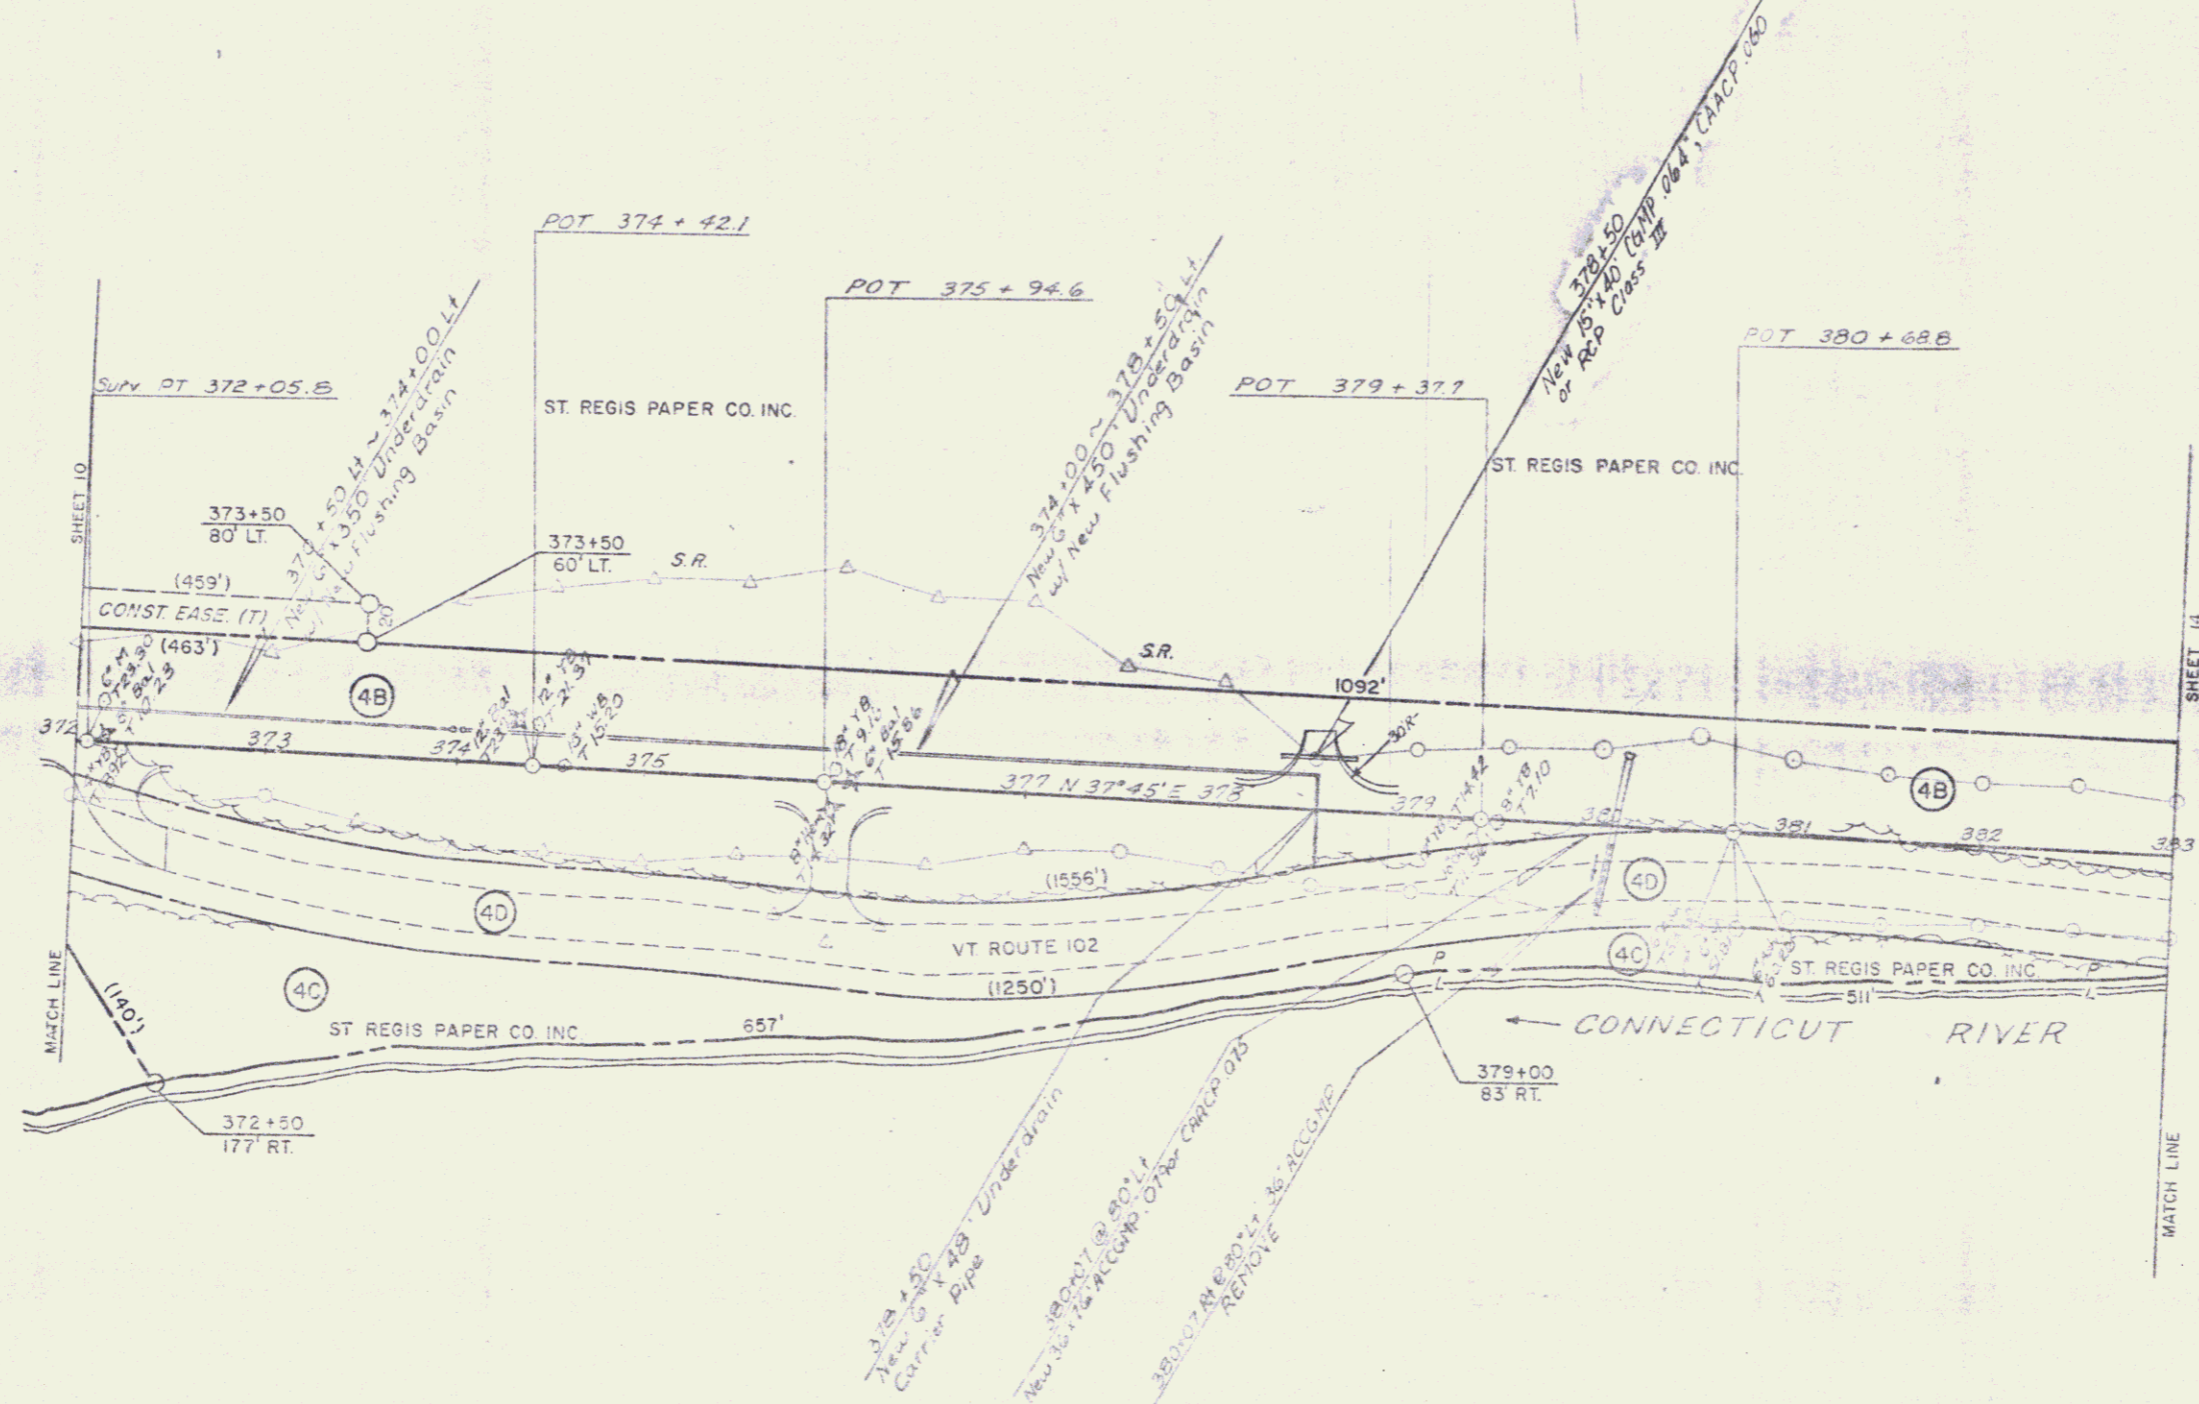

APR 04 1986

Scale 0 50 Feet

SURVEYED BY: [Signature]
DRAWN BY: [Signature]
CHECKED BY: [Signature]
LEMINGTON
PROJ. RS NO. 0211(9)
SHEET 12 OF 27

10