


GUARD RAIL, THREE CABLE  
w/LIGHT WOOD POSTS  
Lt Rt  
383+00~393+00

STONE FILL, Type II  
Lt Rt  
383+00~384+25  
383+47~388+53

UNCLASSIFIED CHANNEL  
EXCAVATION  
Lt Rt  
383+00~386+25

CONSTRUCT DRIVES  
Lt Rt  
389+75

ALL DRIVES AS INDICATED ON  
PLANS ARE SUBJECT TO PER-  
MITS PURSUANT TO TITLE 19,  
SECTION 43, VS A

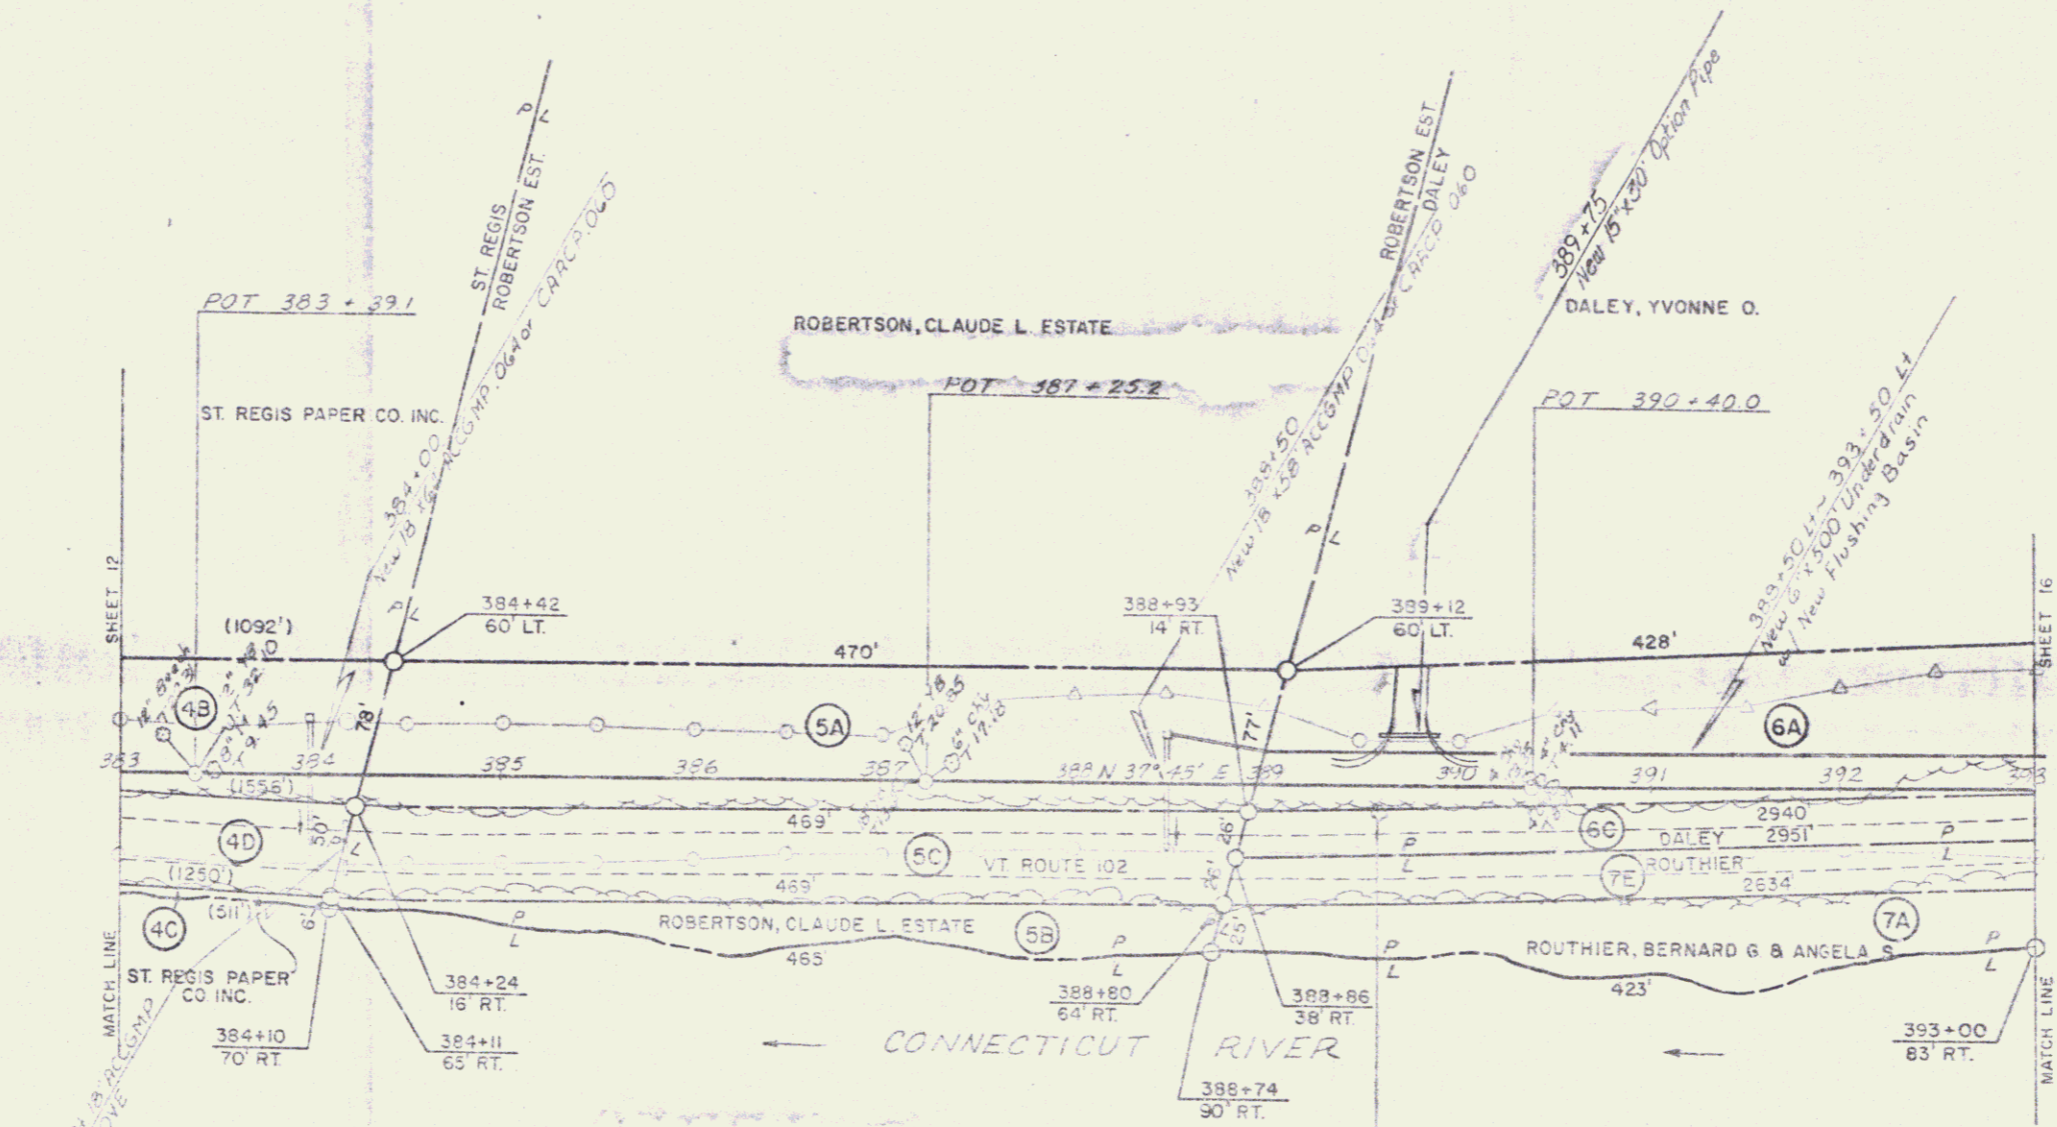

BM # 45  
SIT 15" Y8  
U.S. Elev 1009.18

APR 04 1986

SUPPLIED BY: \_\_\_\_\_  
DRAWN BY: \_\_\_\_\_  
TRACED BY: \_\_\_\_\_  
LENINGTON  
PLANS No. 0271(1)  
SHEET 14 of 27