

DEMOLITION and DISPOSAL
of BUILDING
LT
#3 - 420+00

CONSTRUCT DRIVE
LT
418+50 ~ 422+30 (20' Wide)
420+50 ~ 427+00 (14' Wide)
429+00 (1/2' Wide)
430+75 (1/2' Wide)

ALL DRIVES AS INDICATED ON
PLANS ARE SUBJECT TO PER-
MITS PURSUANT TO TITLE 19,
SECTION 43, VS A.

SPECIAL DITCH
(To be paid under item 203.11)
LT
418+50 ~ 419+50
431+35 ~ 432+00
421+00 ~ 422+75

SPECIAL DITCH w/
STONE FILL TYPE II
RT
430+25 ~ 431+10


STONE FILL, Type II
LT
431+35 ~ 431+50
RT
430+25 ~ 431+25
417+97 ~ 418+03

WOOD GUIDE POSTS
(2' 0" on Ctr)
RT
428+00 ~ 431+52

CURVE DATA	REV. CURVE DATA
Δ 17° 33' LT	Δ 16° 15' LT
D 2' 00'	D 2' 00'
R 2864.79	R 2864.79
T 442.2	T 409.0
L 877.5	L 812.5
E 33.93	E 29.0

Bank 0.035' per ft. Bank 0.035' per ft.

REV. CURVE DATA
Δ 1° 18' LT
D 0' 45"
R 7639.44
T 86.65
L 173.3
E 0.5
Bank 0.023' per ft.

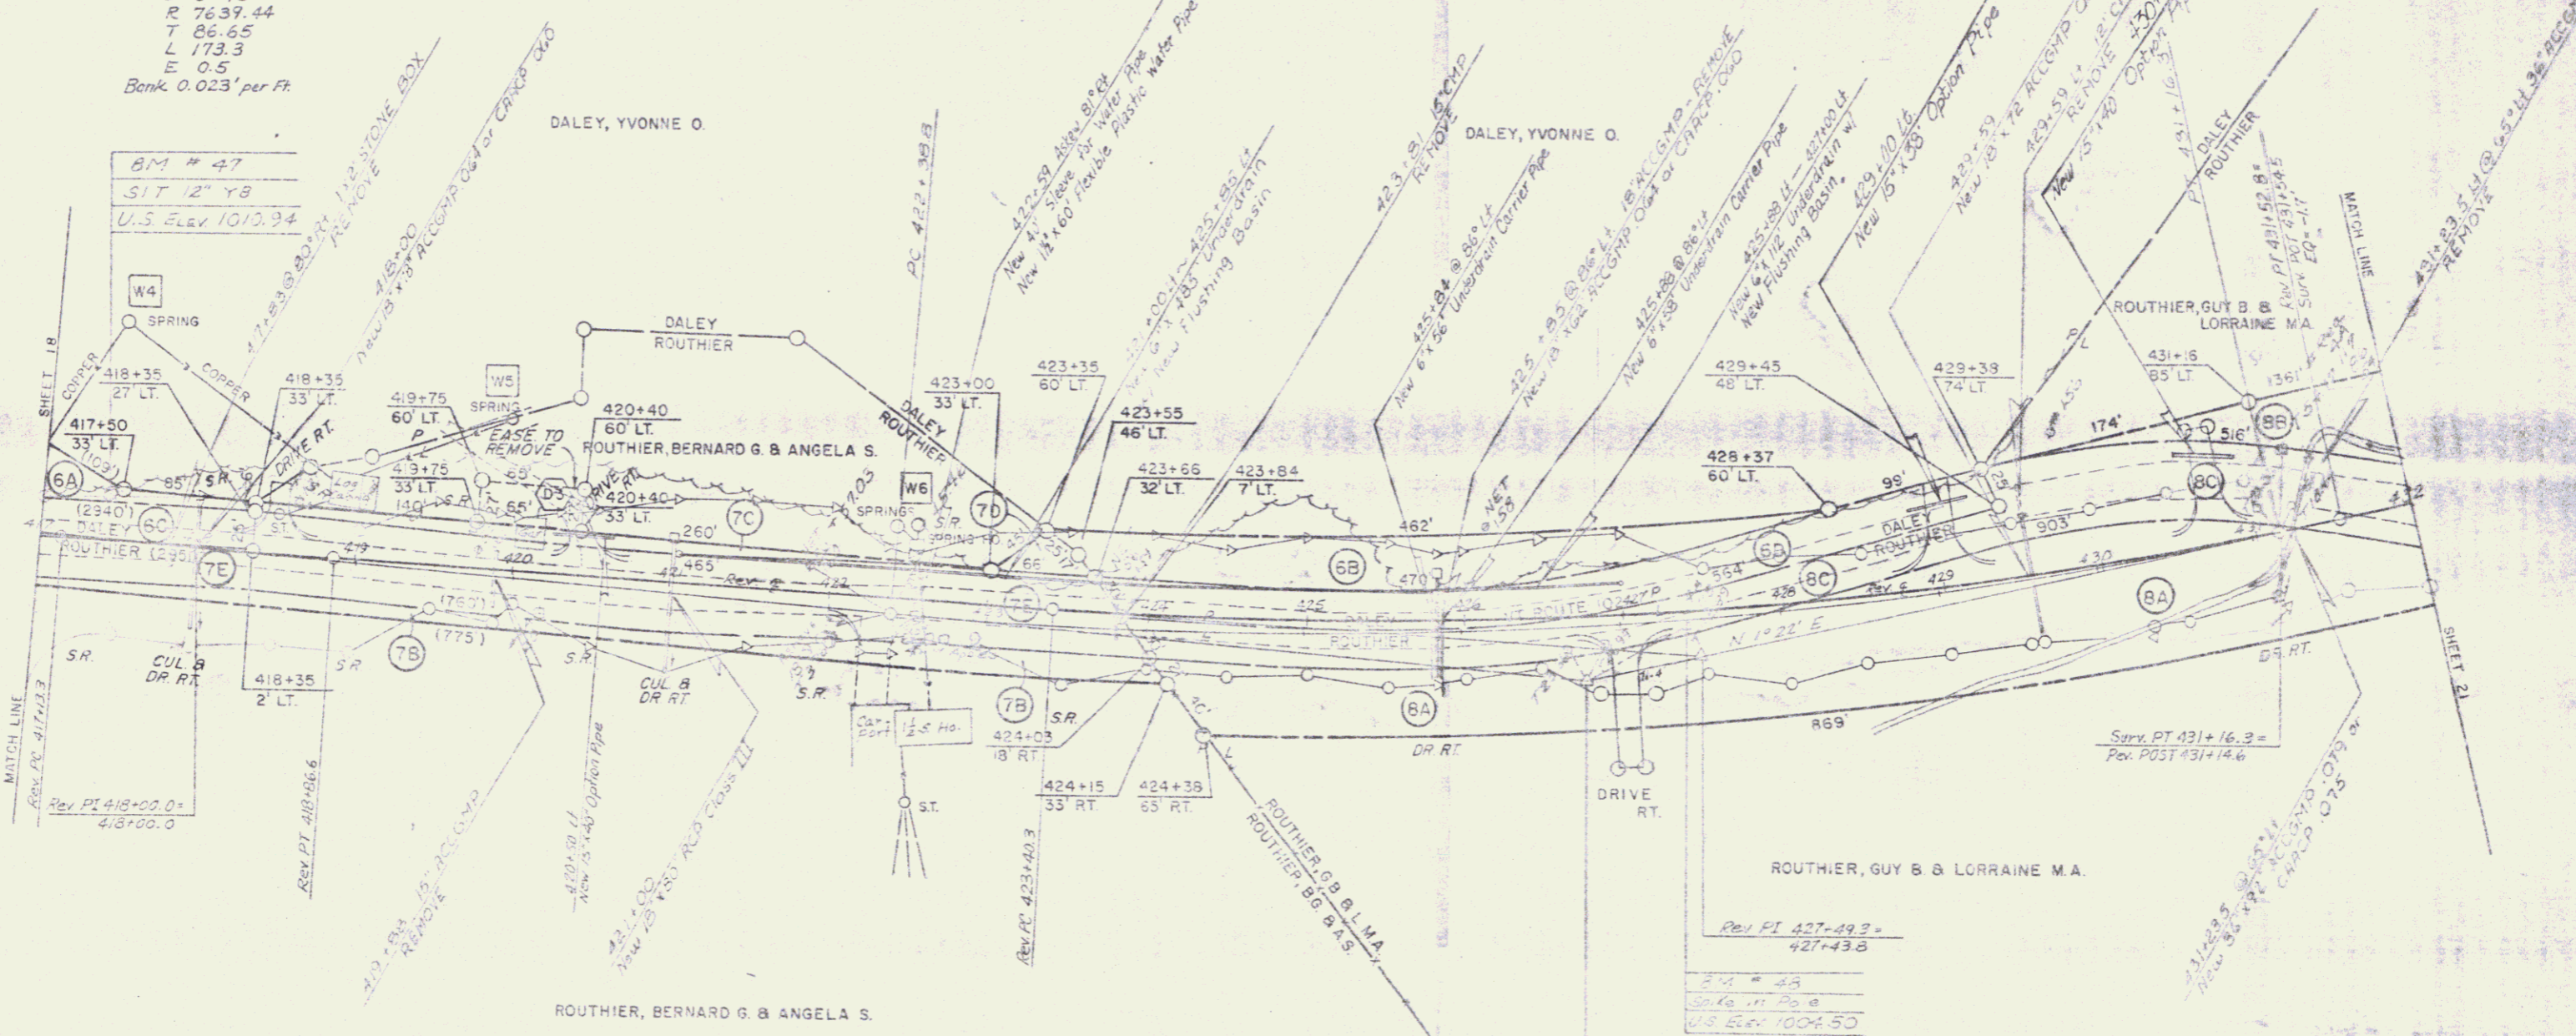

APR 04 1986

Scale 1" = 50'
Feet

APPROVED BY: _____ DATE: _____
MADE BY: _____ DATE: _____
REVISIONS: _____
19