

MUCK EXCAVATION
 432+00 ~ 440+00
 Construct Drive
 Lt Rt
 434+00 (16' Wide)

SPECIAL DITCH
 (To be Paid Under Item 203.17)
 Lt Rt
 432+00 ~ 440+00 432+00 ~ 433+75


ROCK FILL
 433+00 ~ 440+00

ALL DRIVES AS INDICATED ON
 PLANS ARE SUBJECT TO PER-
 MITS PURSUANT TO TITLE 13,
 SECTION 43, V.S.A.


CM # 43
 52 Paved # 25
 US Elev 100125

PLAN
 DATE: 12/11/85
 DRAWN BY: J.E.W.
 CHECKED BY: J.E.W.
 SCALE: 1" = 40'

PROFILE
 DATE: 12/11/85
 DRAWN BY: J.E.W.
 CHECKED BY: J.E.W.
 SCALE: 1" = 40'

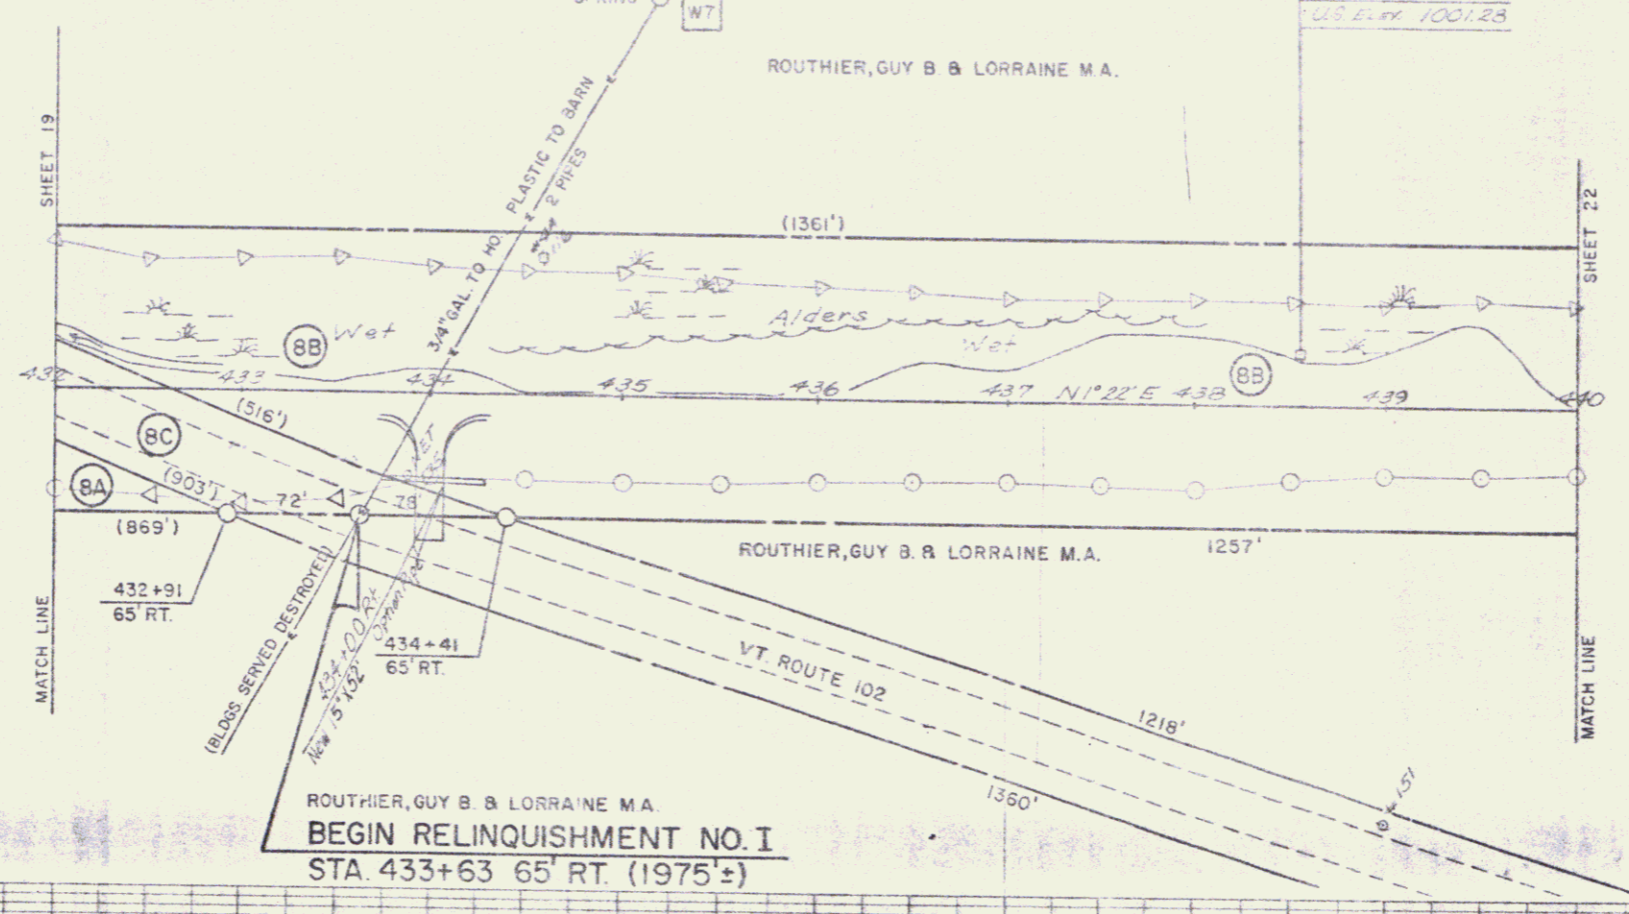

Scale 0 50 Feet

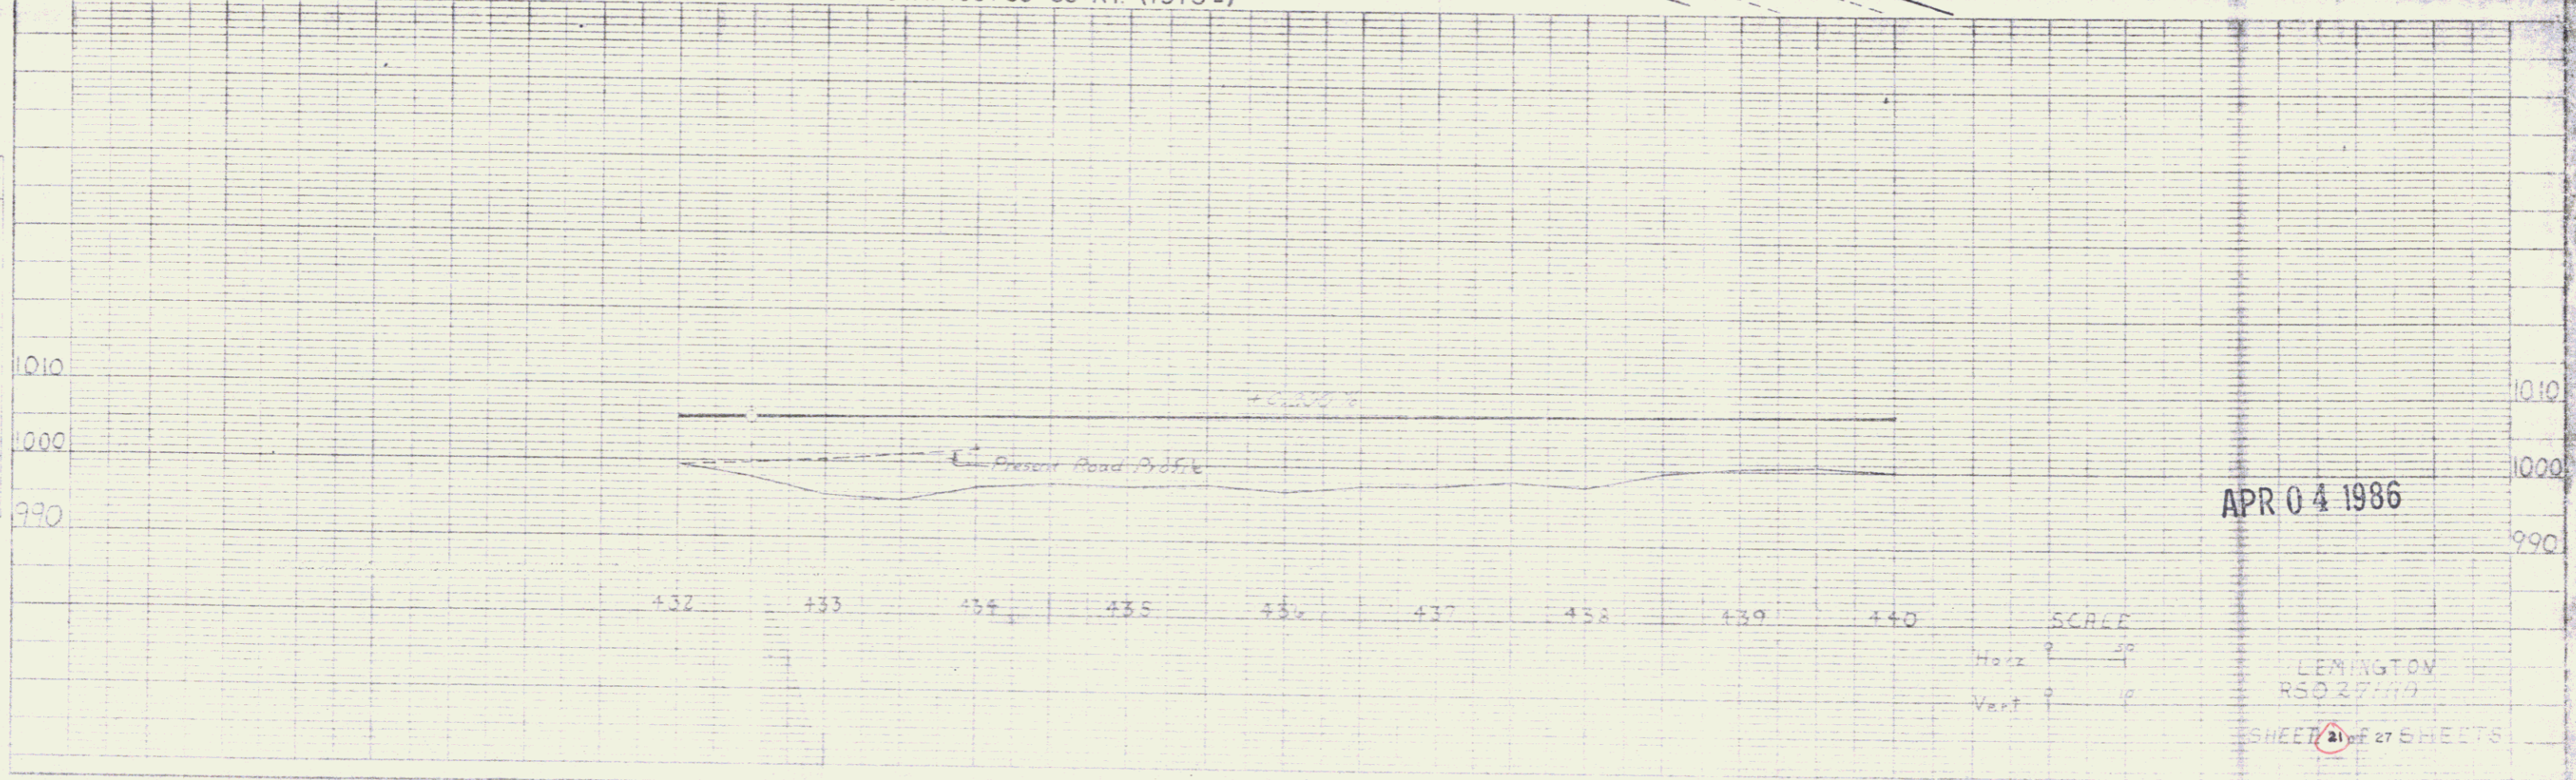

APR 04 1986

SCALE
 Horiz 1" = 40'
 Vert 1" = 4'

LEMINSTON
 RSD 27/100
 SHEET 21 of 27 SHEETS

15