



PLAN
 DATE: 3/78
 DRAWN BY: [Signature]
 CHECKED BY: [Signature]
 NO. 10

PROFILE
 DATE: 3/78
 DRAWN BY: [Signature]
 CHECKED BY: [Signature]
 NO. 10

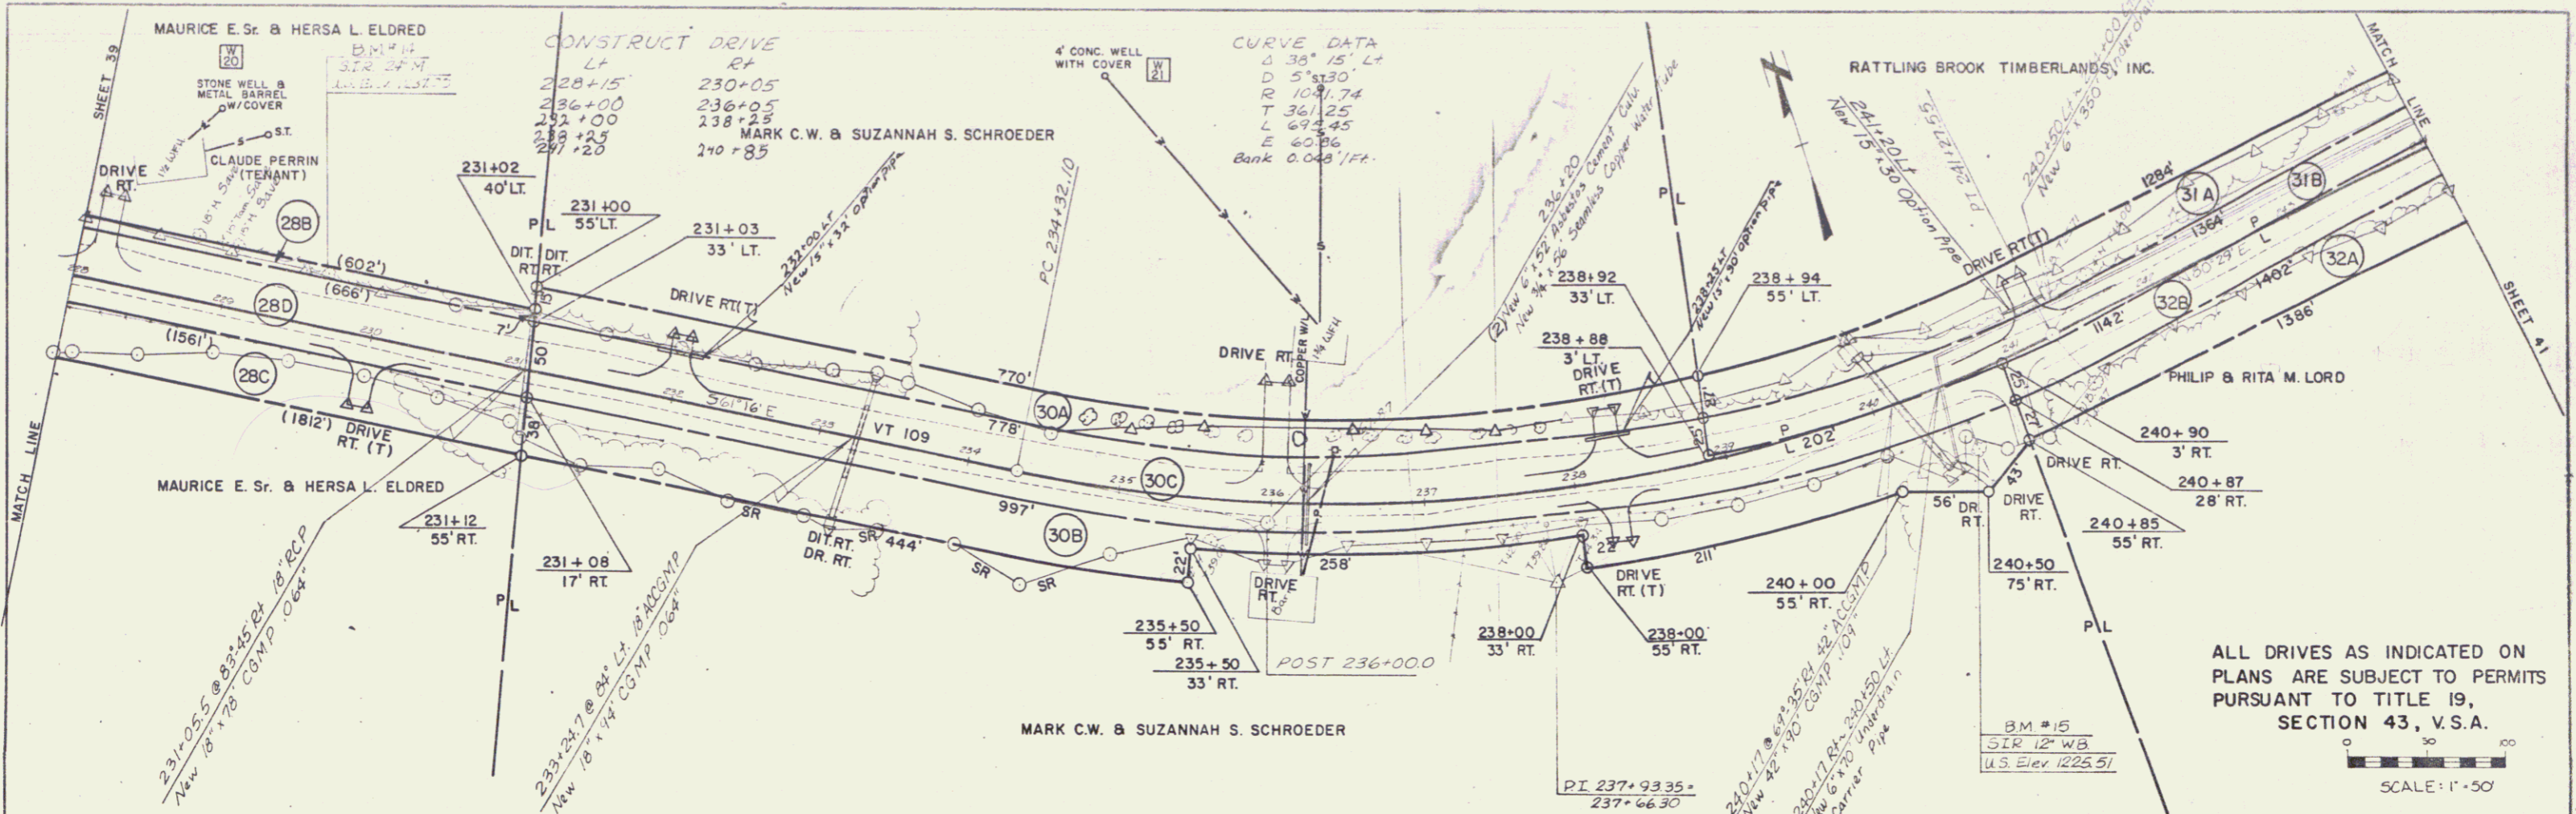

ALL DRIVES AS INDICATED ON
 PLANS ARE SUBJECT TO PERMITS
 PURSUANT TO TITLE 19,
 SECTION 43, V.S.A.
 SCALE: 1" = 50'
 B.M. # 5
 S.I.R. 12" W.B.
 U.S. Elev. 1225.51

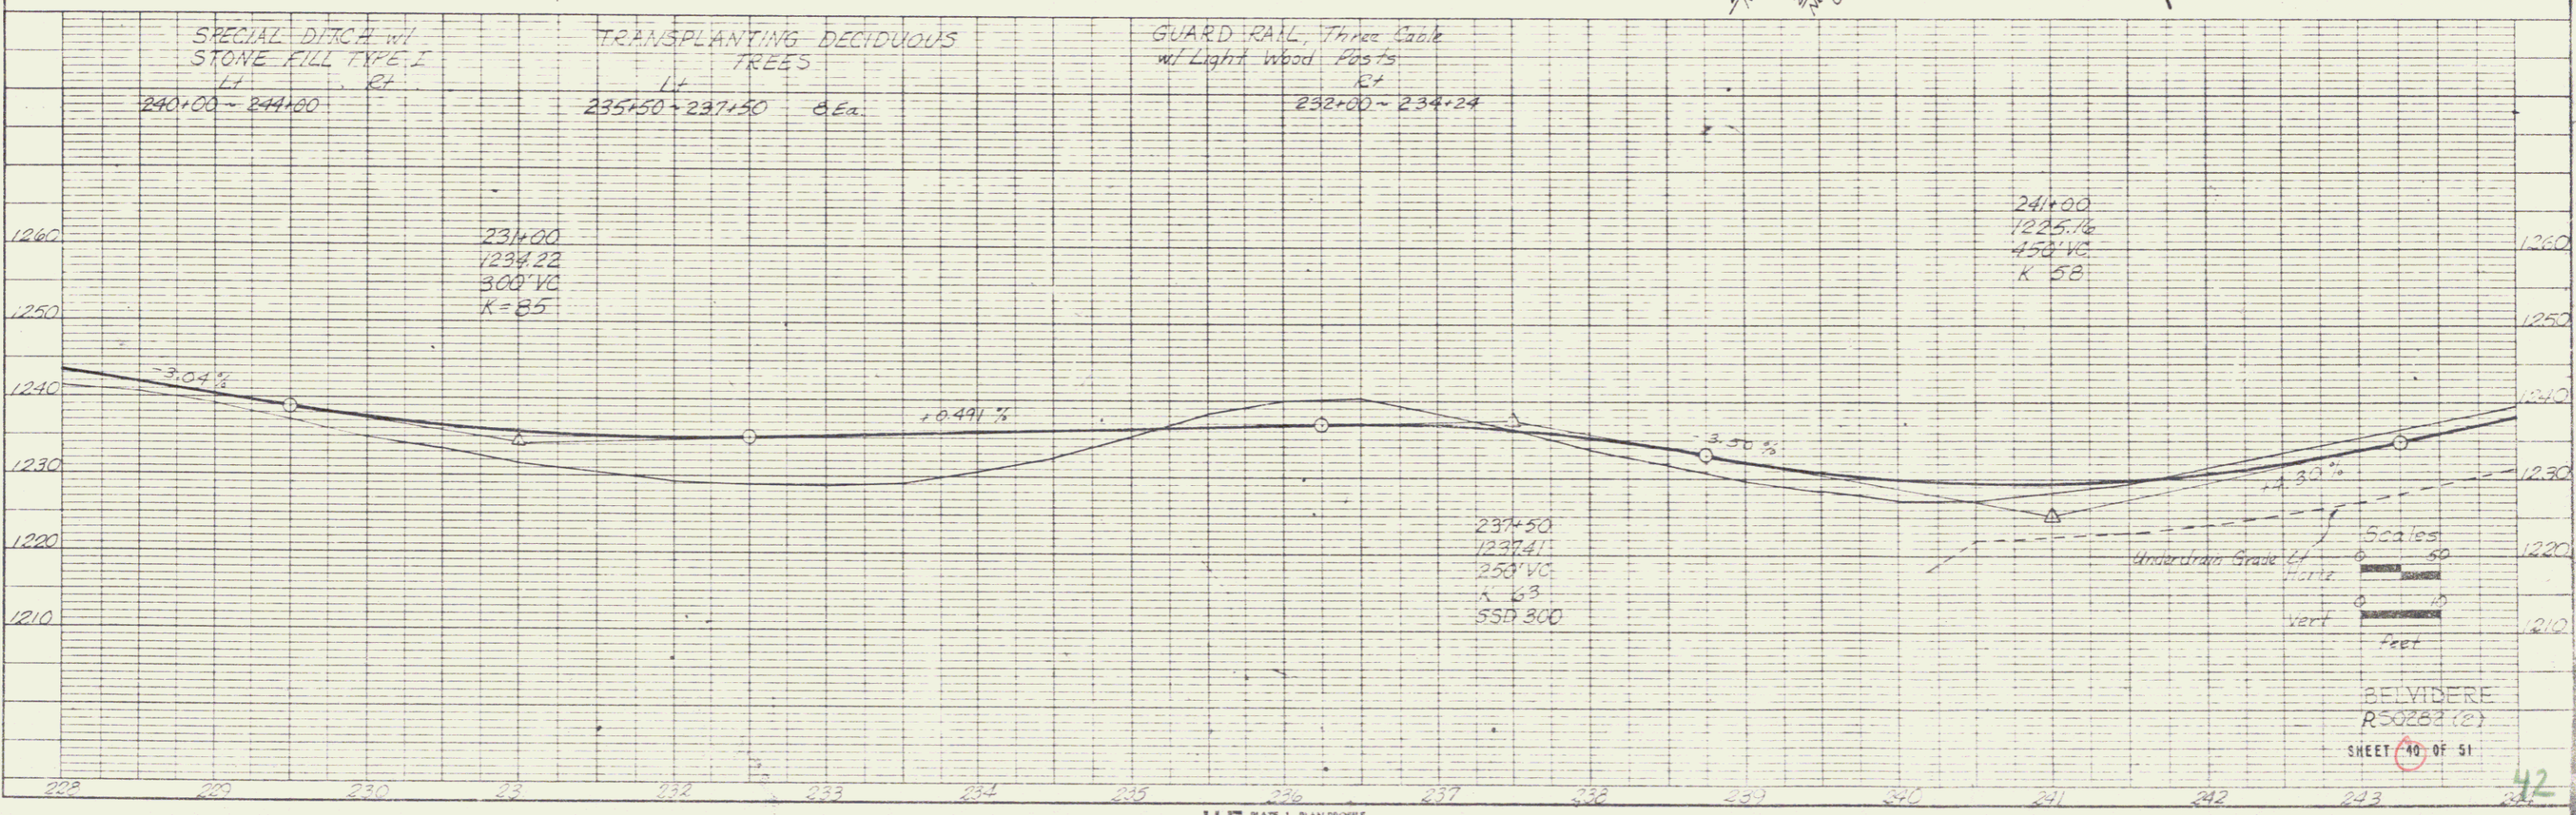

BELVIDERE
 R50282 (2)
 SHEET 40 OF 51