
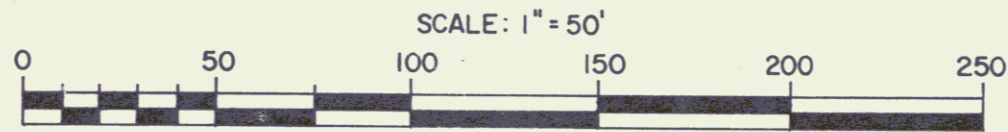


ESTABLISHED BY ORDER OF THE STATE HIGHWAY BOARD
PURSUANT TO LEGISLATIVE ACT 61 OF 1931 AND WAS
TAKEN INTO THE STATE HIGHWAY SYSTEM ON MAY 20, 1949.

mP0561

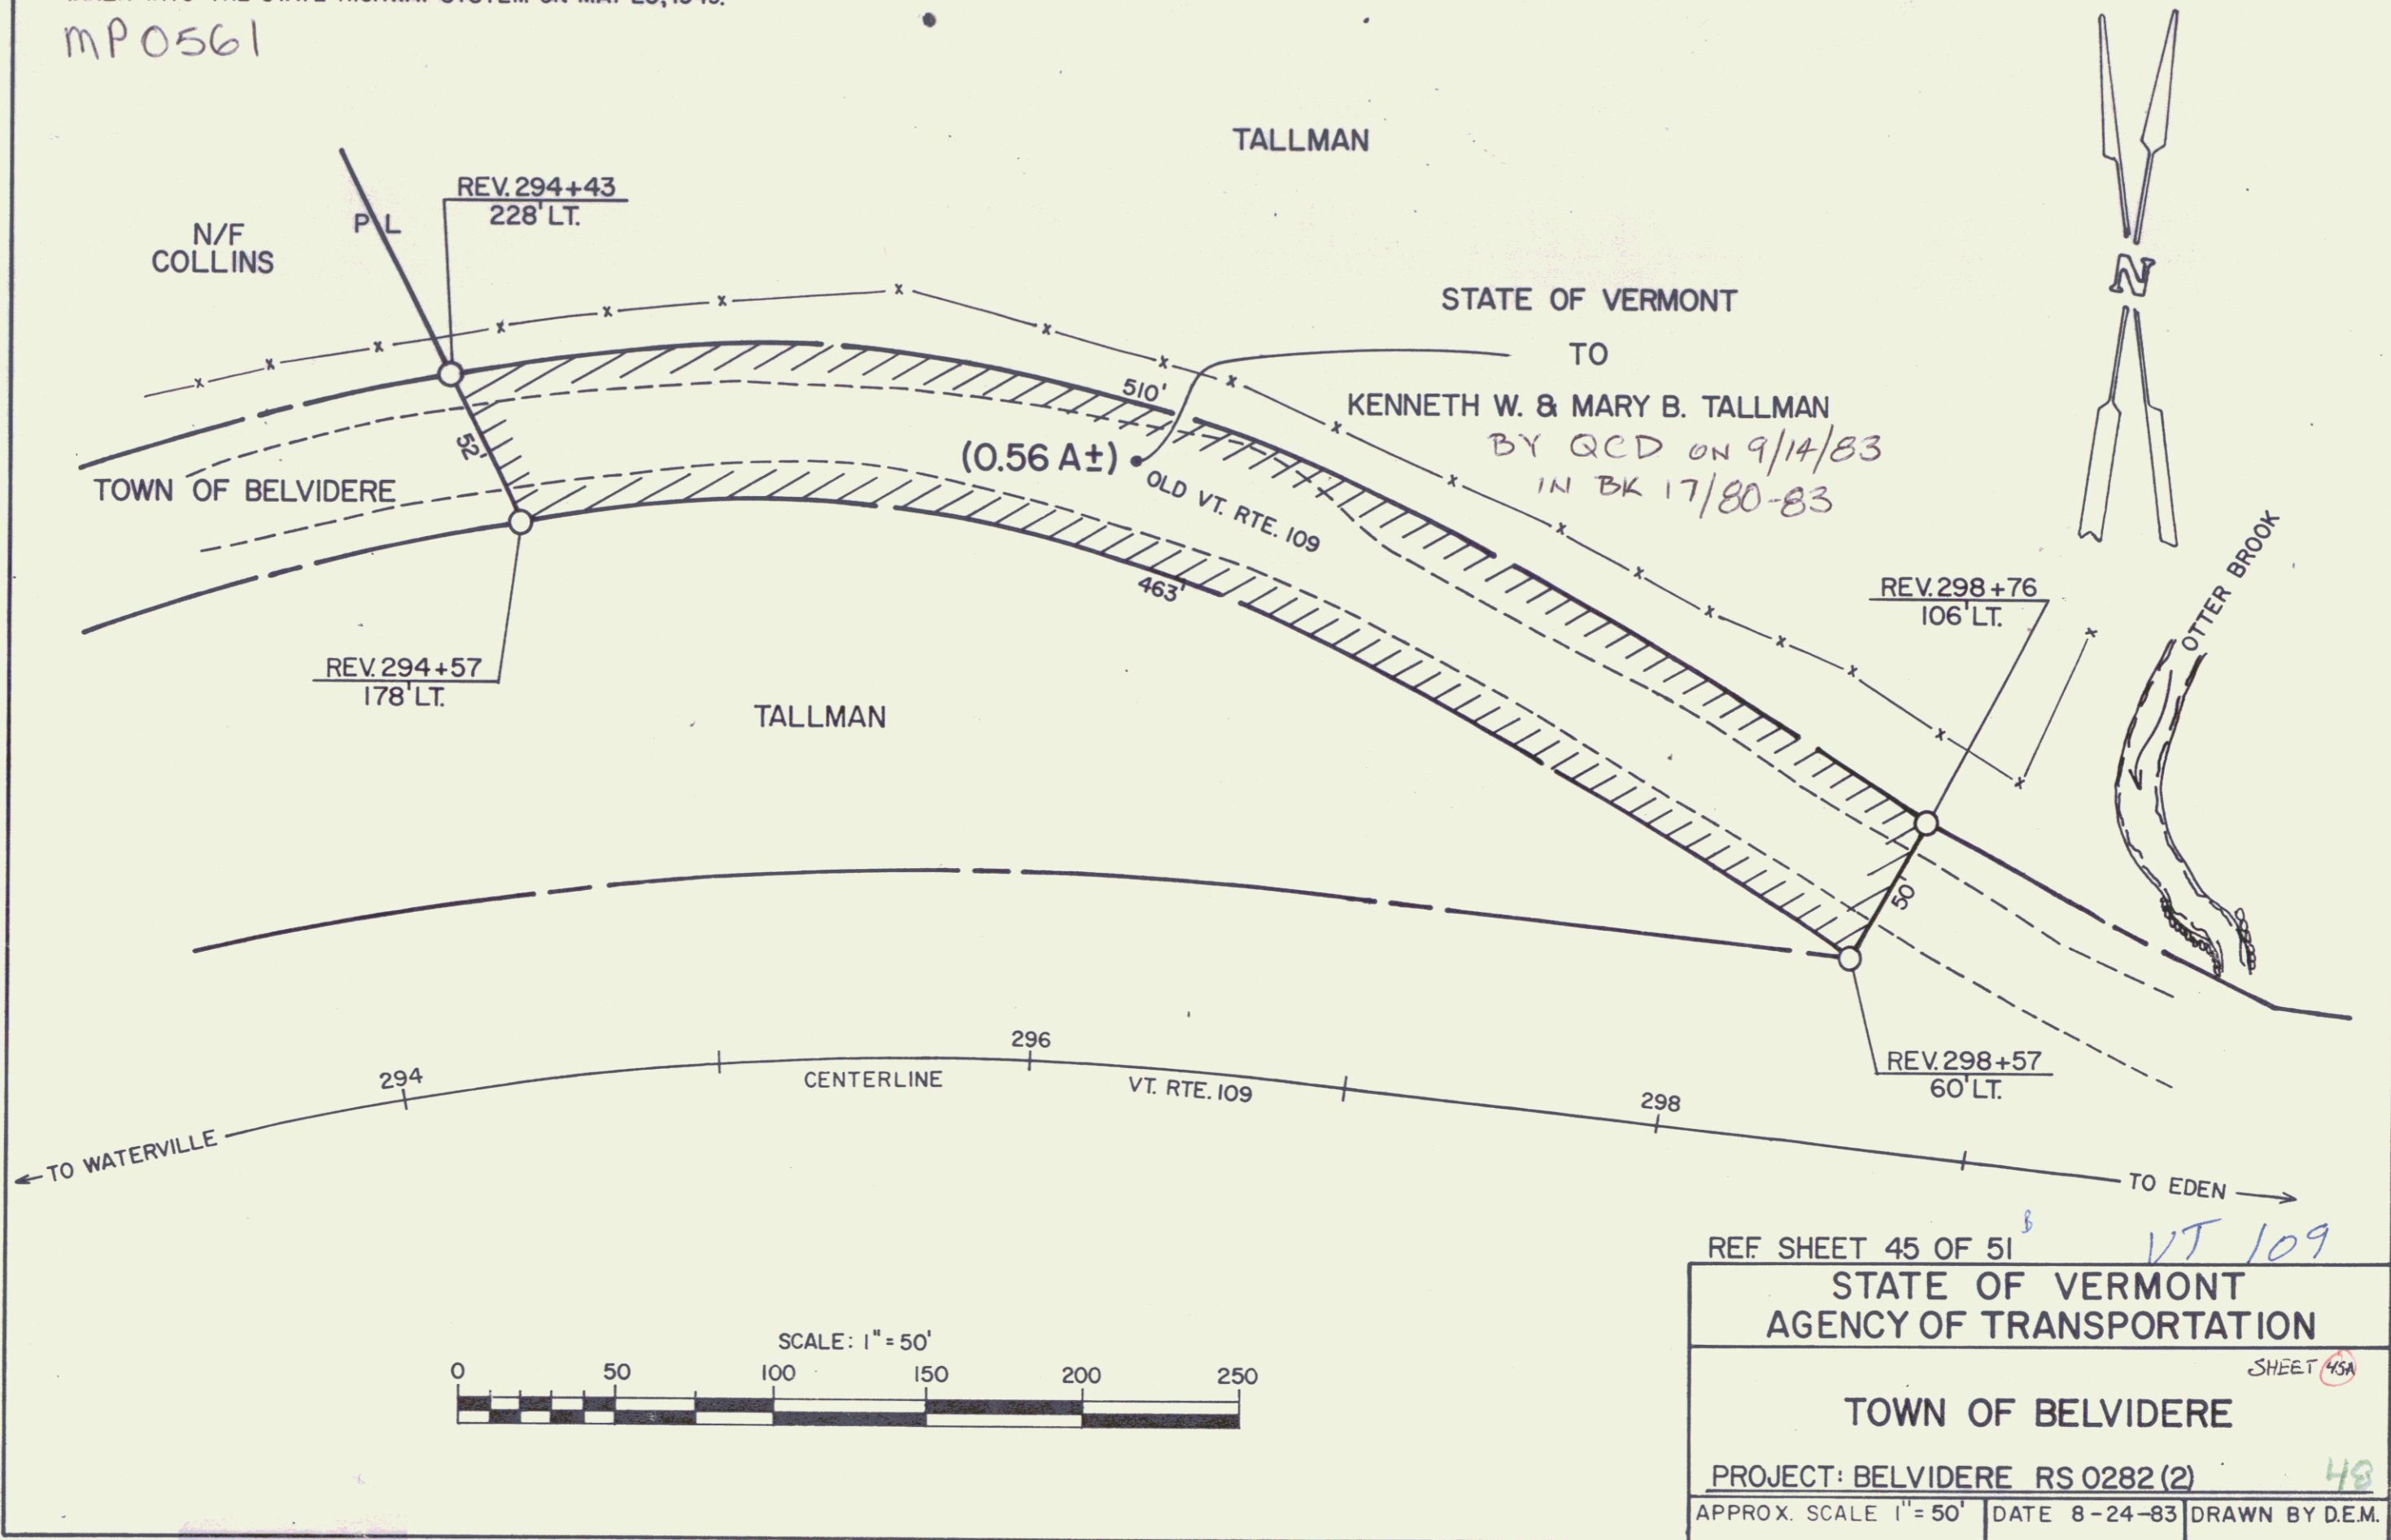

REF SHEET 45 OF 51^b VT 109

STATE OF VERMONT AGENCY OF TRANSPORTATION		
TOWN OF BELVIDERE		
PROJECT: BELVIDERE RS 0282 (2)		
APPROX. SCALE 1" = 50'	DATE 8-24-83	DRAWN BY D.E.M.

SHEET 45A
48