
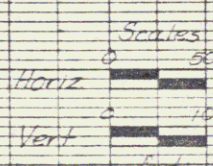
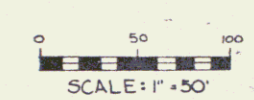
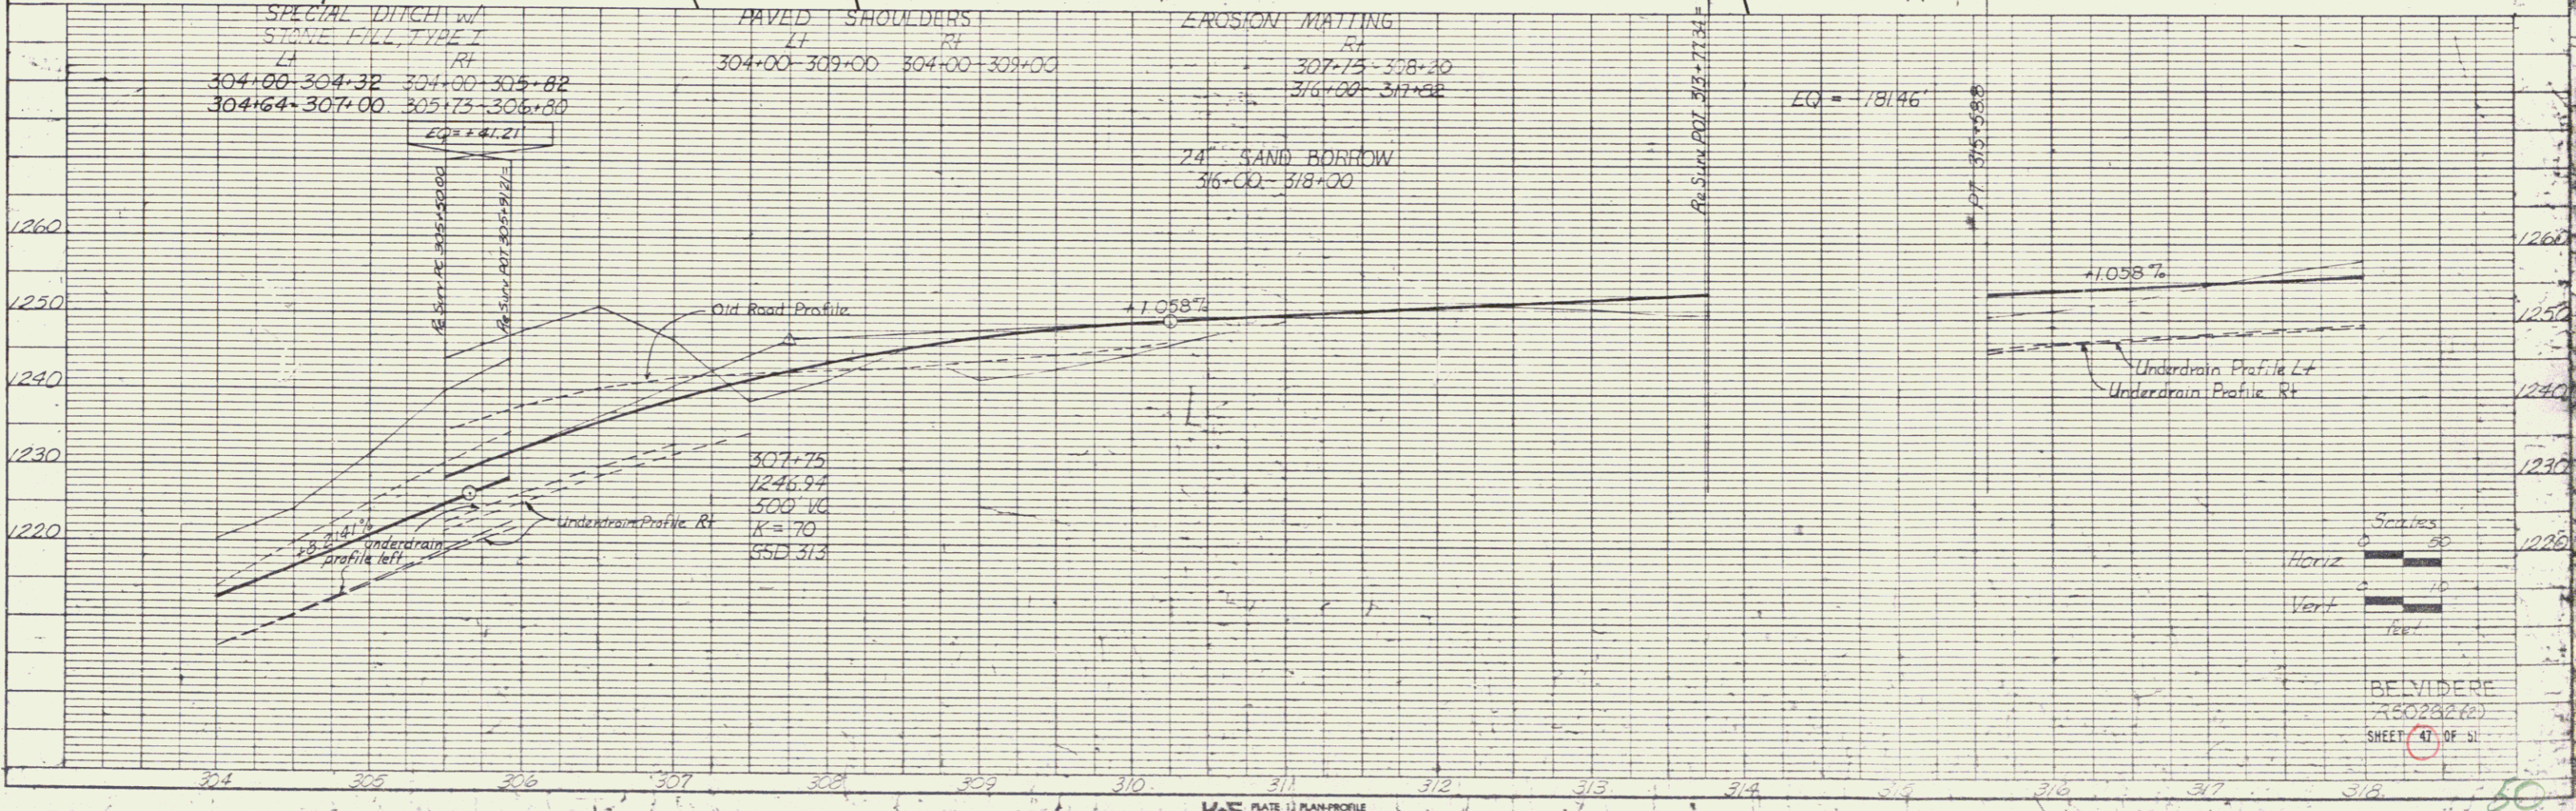


PLAN
 DATE: 5/12/15
 DRAWN BY: J. L. ...
 CHECKED BY: ...
 NO. ...

PROFILE
 DATE: 5/12/15
 DRAWN BY: J. L. ...
 CHECKED BY: ...
 NO. ...

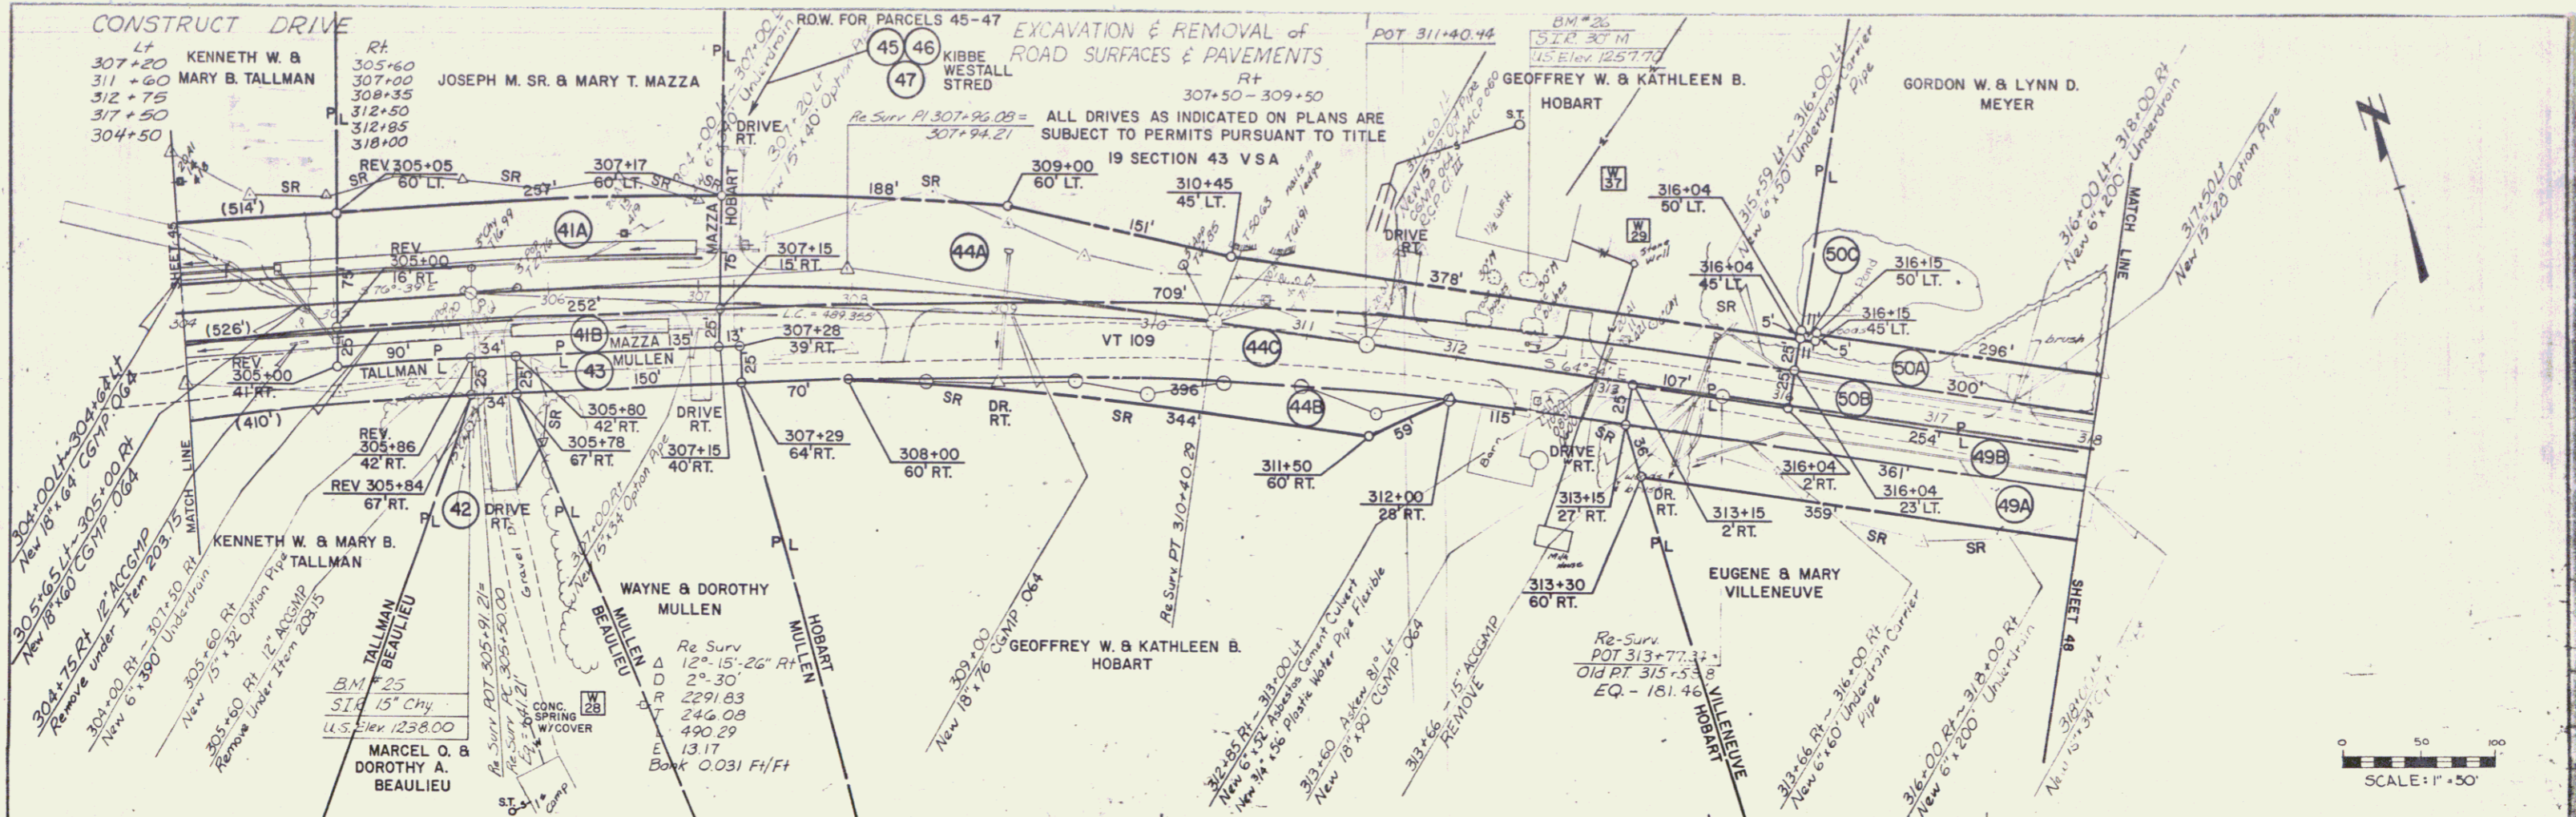

BELVIDERE
 20028200
 SHEET 47 OF 51