


TOWN OF LOWELL
COUNTY OF ORLEANS
VERMONT ROUTE # 58

LOWELL - IRASBURG ROAD

R.O.W. PLANS

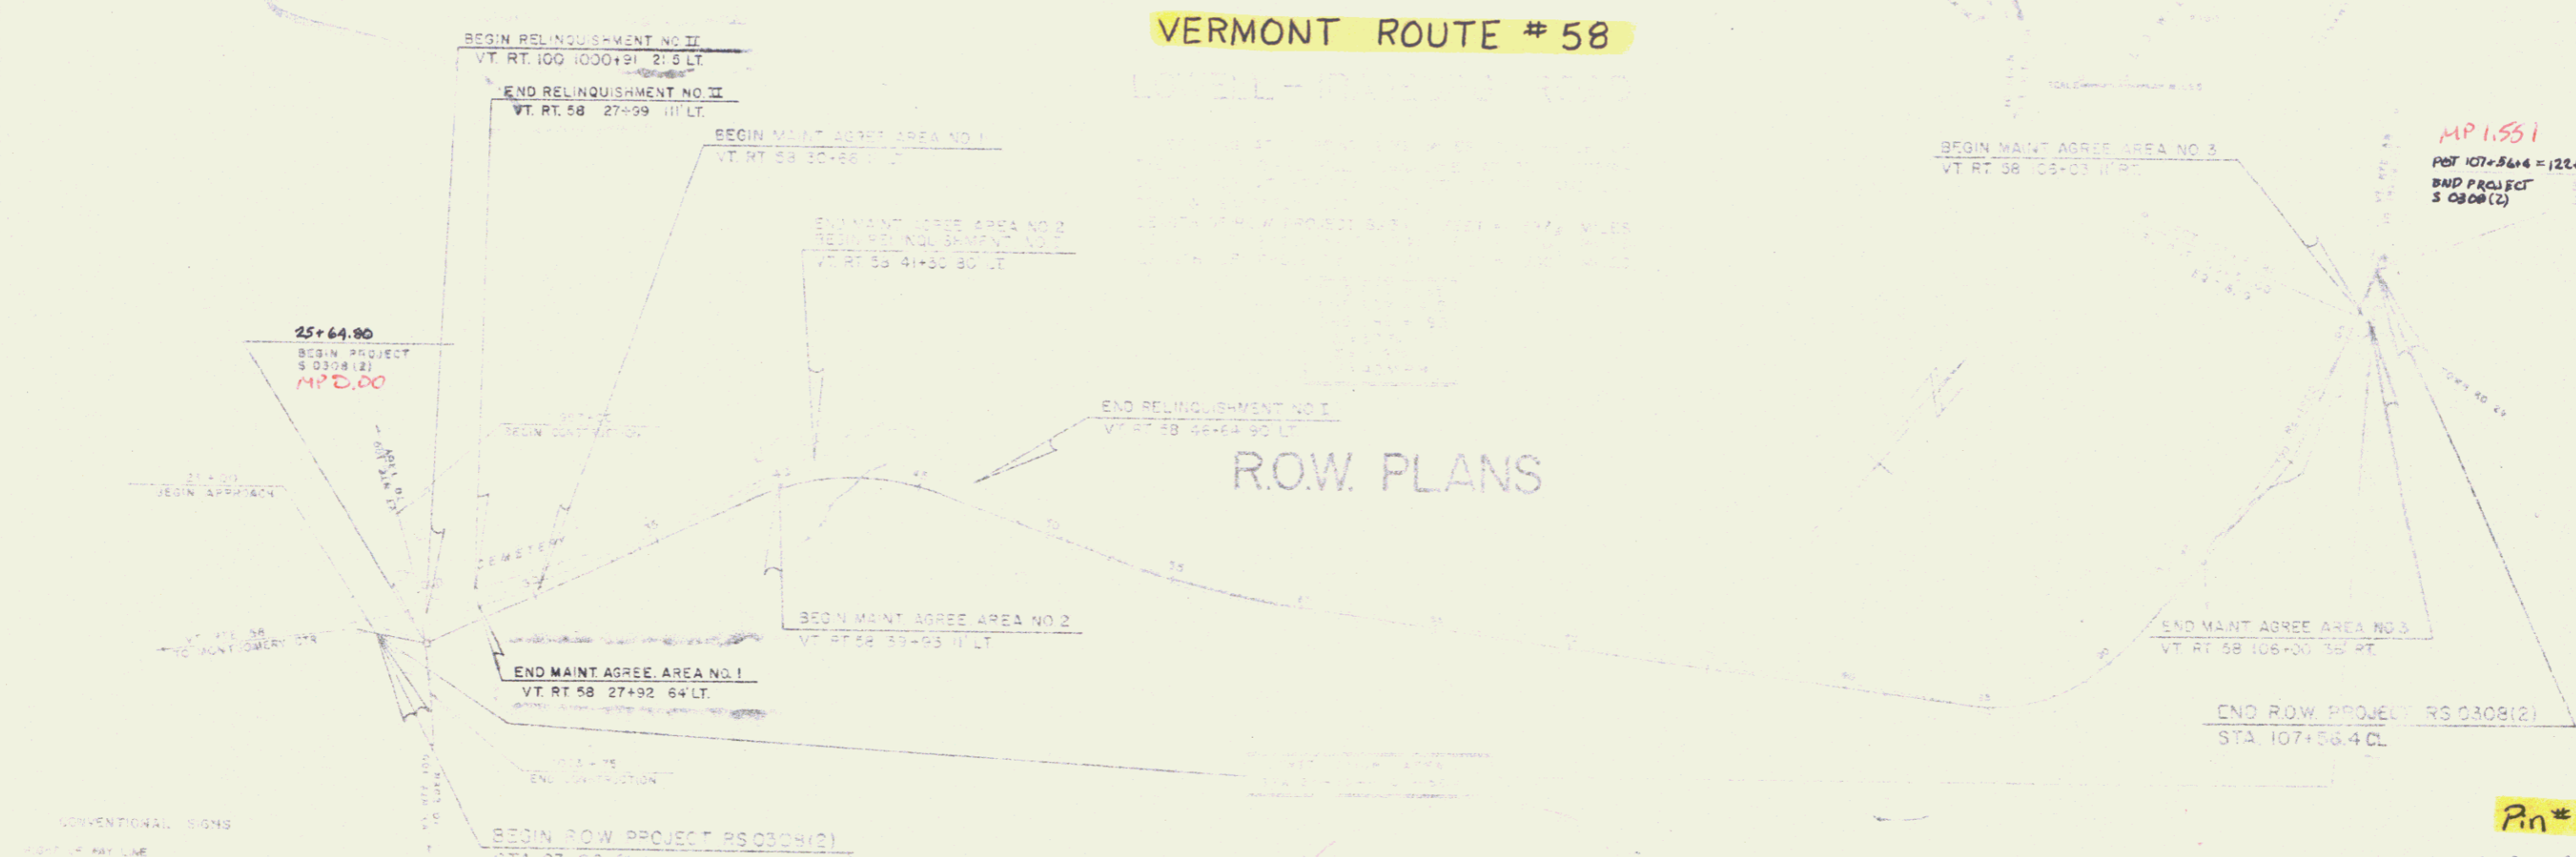

CONVENTIONAL SIGNS

RIGHT OF WAY LINE	---
STATE ROUTE	---
...	---

POOR ORIGINAL COPY

MP 1.551
POT 107+50.4 = 126+57.35
END PROJECT
S 0308(2)

Pin # 76C064

SEP 09 1988

APPROVED	<i>[Signature]</i>
DATE	7-15-75

RS 0308(2)