

1. 00 West  
270 28 17  
190 38 17  
446 38 6  
91 38 6  
5 0  
Bank Normal  
12 - 31 37  
11 - 23 47 31

1001+78  
(11) Pte 52 West

1001+78  
3 A. 2103 CL

BENWARE, JORDON R &  
CHARLOTTE L.


Rte 58 West  
Sta P1 24+18.55  
12476.75

P10 58 TRAIL  
PI 85+20.15  
Δ 56° 78' 13"

P10 100 POC 100+18.0  
P10 58 TRAIL P1 2301.2  
A 72° 51' 45.5" LT

STATIONING - ROUTE 100  
3100 100+00

EXISTING WAY LIMITS  
SEE PLAN SHEET 10

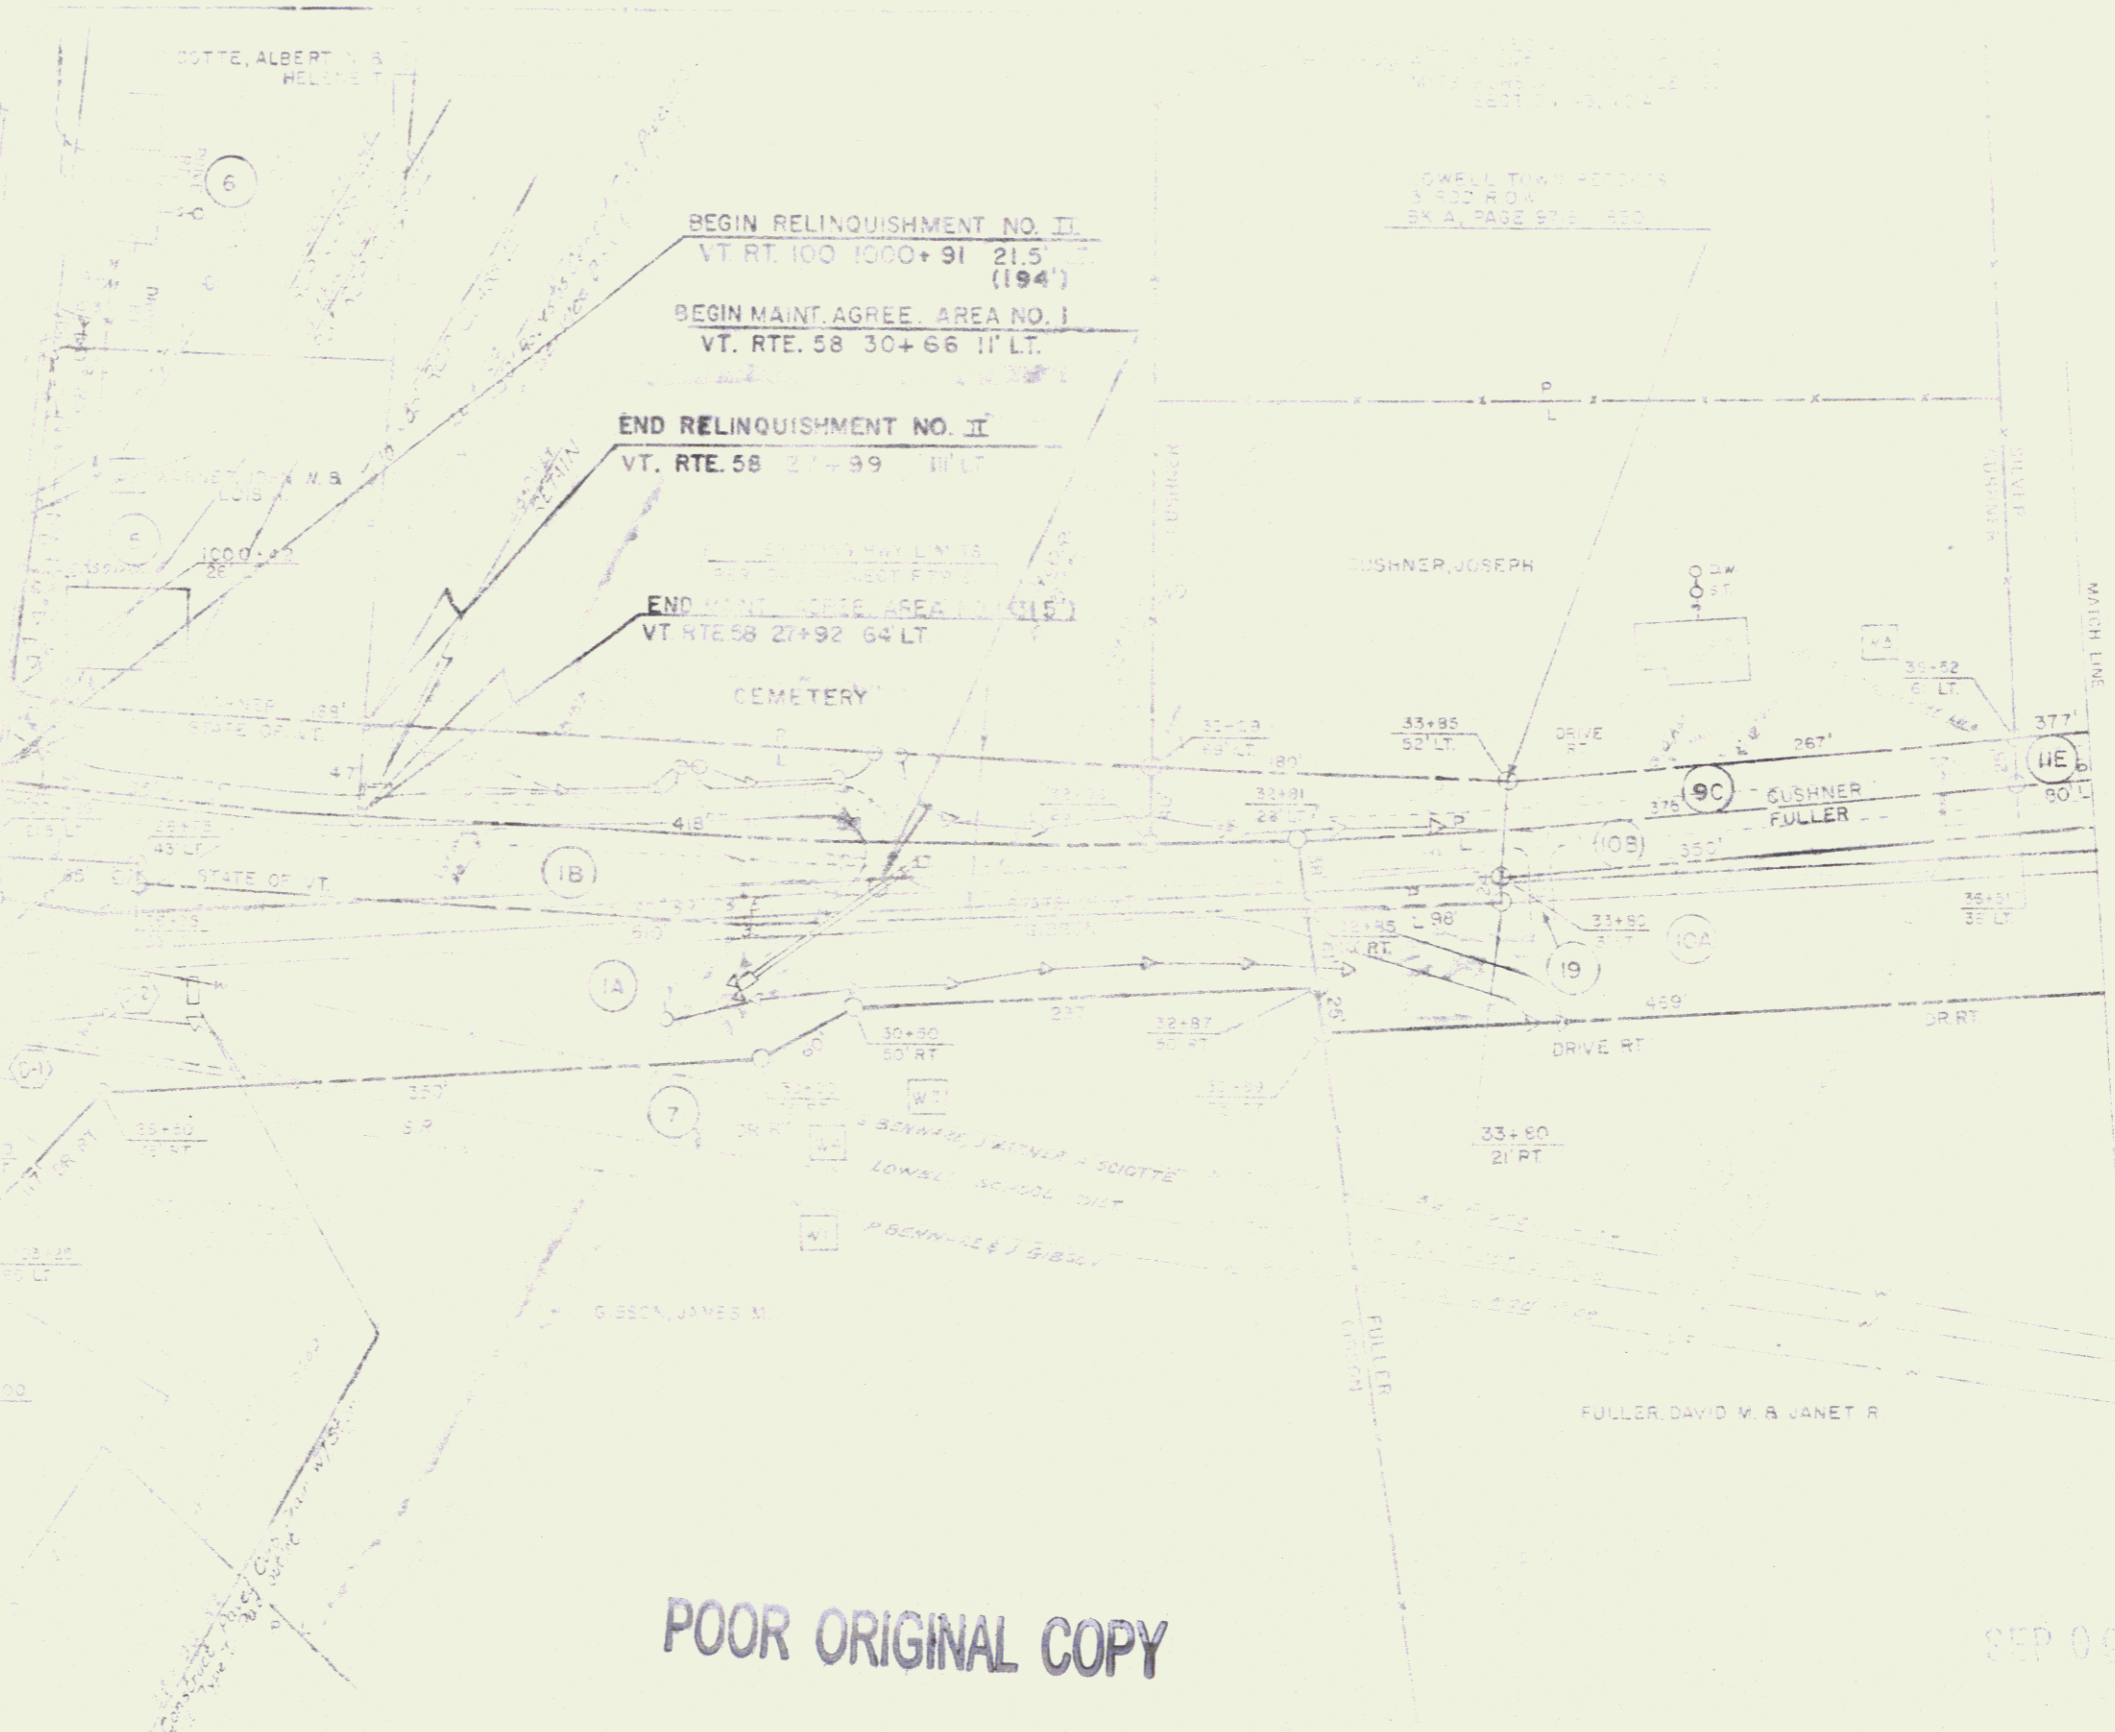

POOR ORIGINAL COPY

SEP 09 1988

SHEET 10

9