


Relinquished to Town of Lowell
9/12/79 BK 28 Pg 227 of Lowell Land Records

STATE CONTROL

42-34 - 64
43-30 - 45+75
44-30 - 55+75

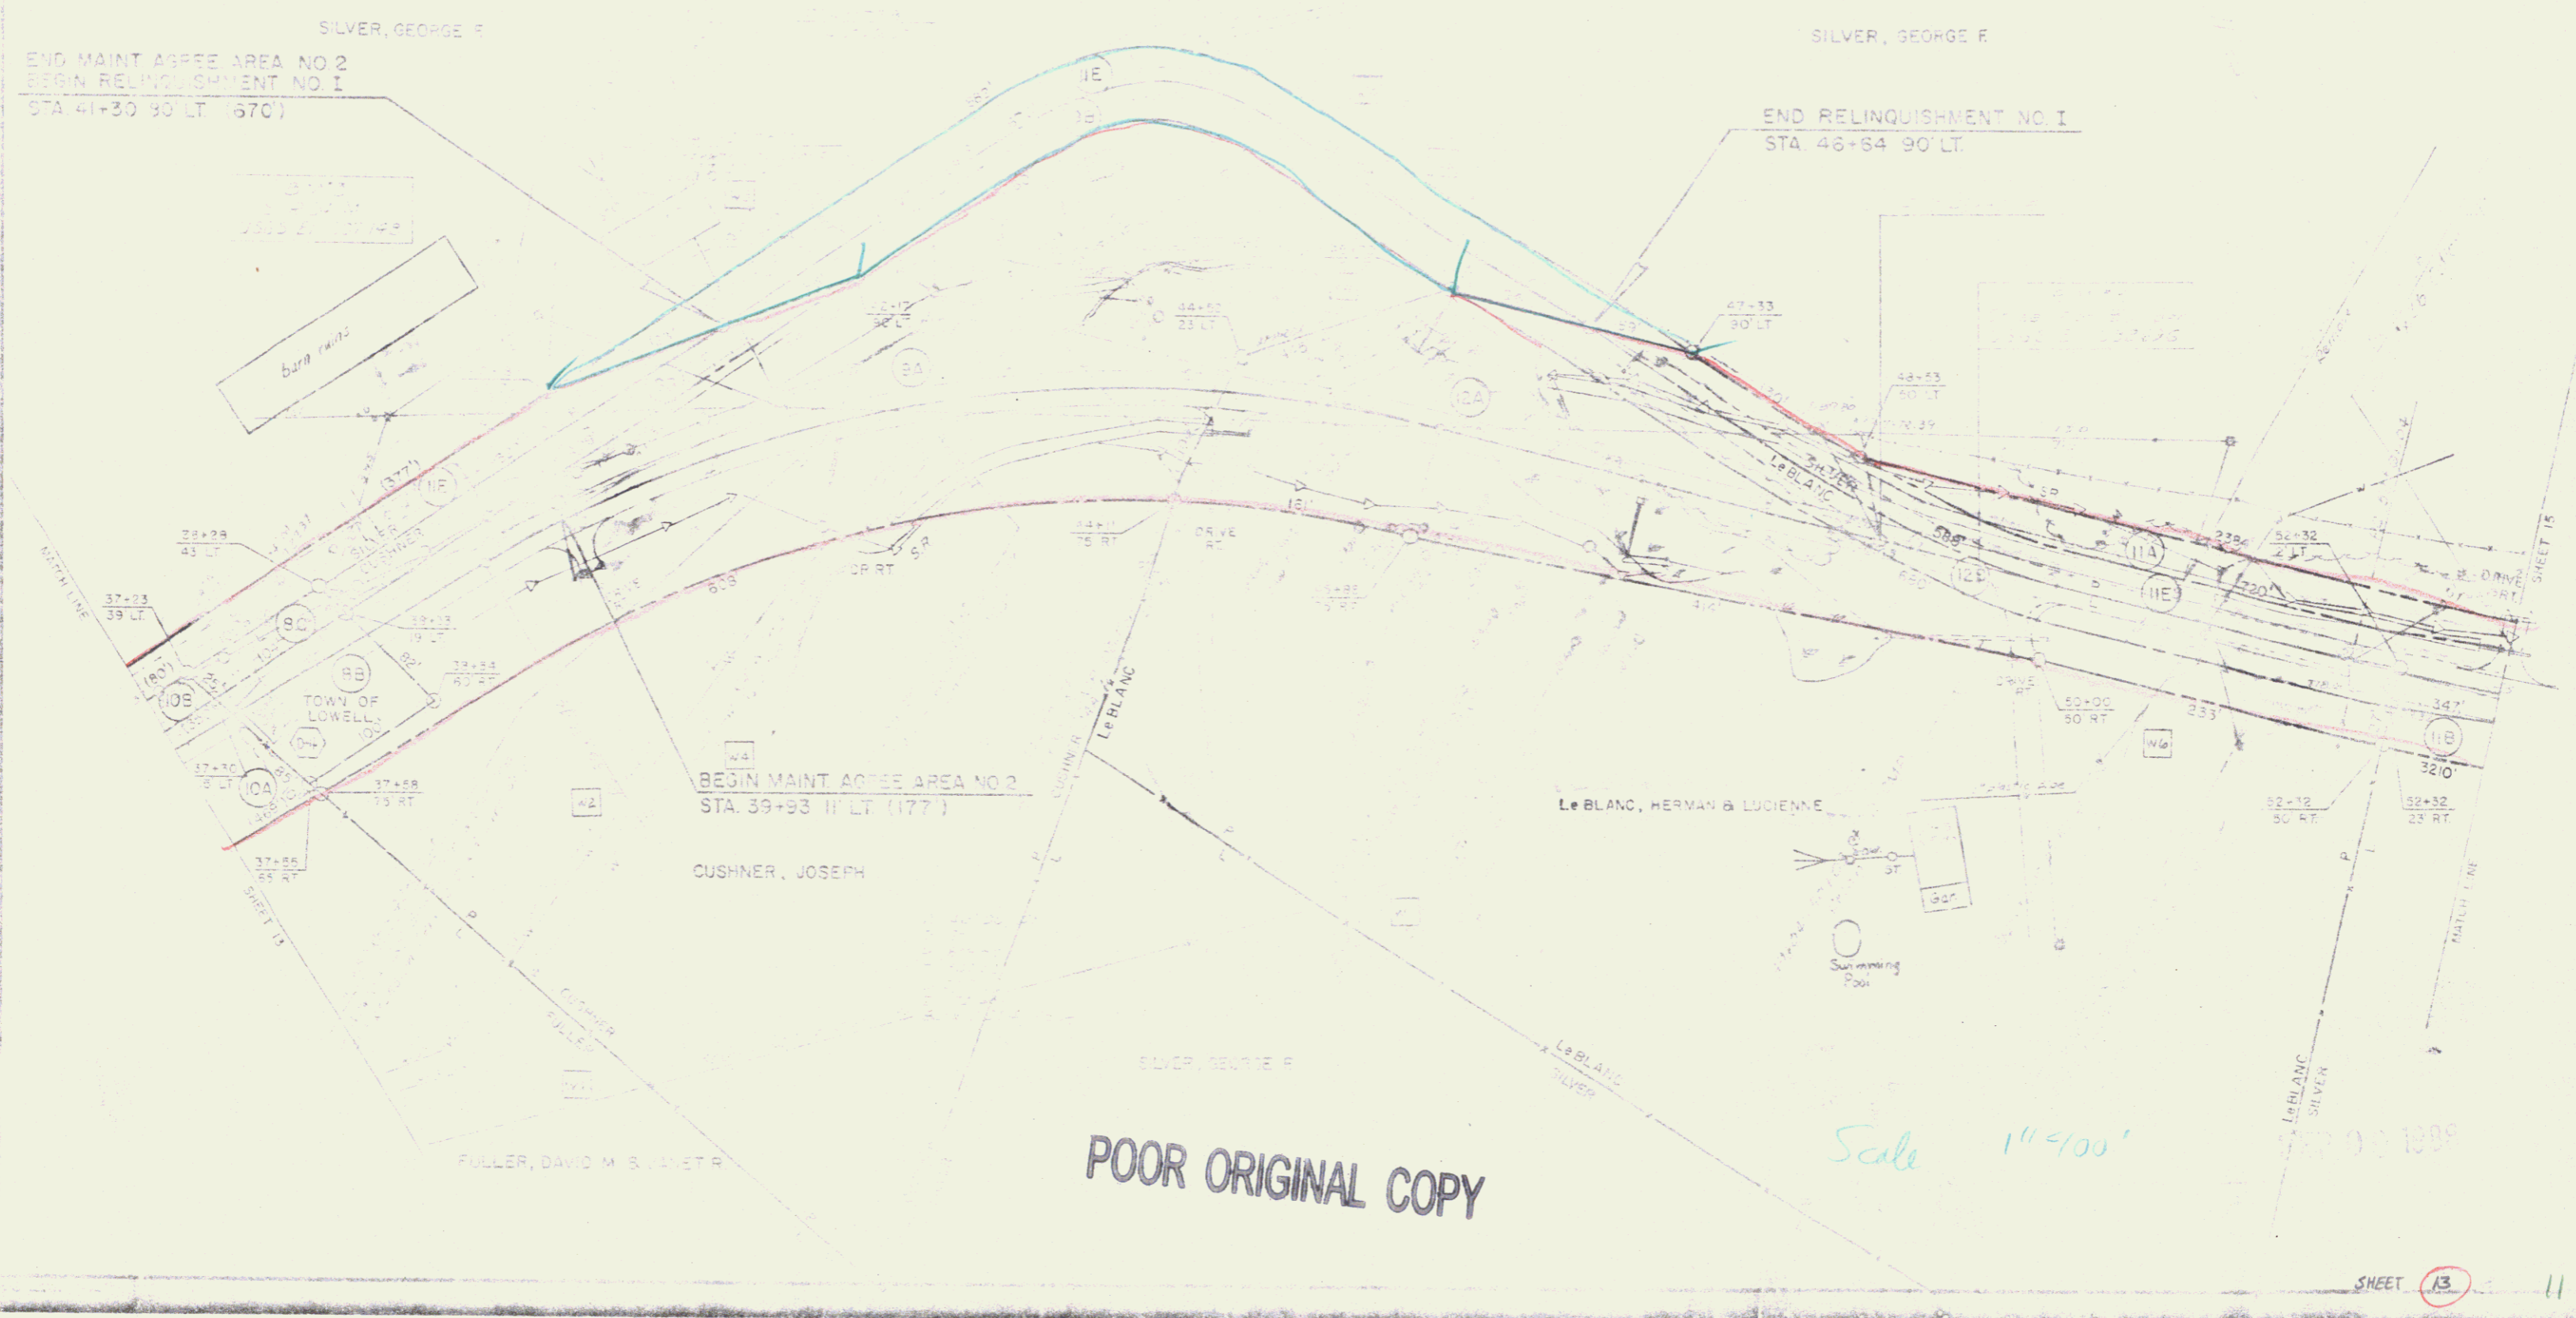

POOR ORIGINAL COPY

Scale 1" = 100'

SHEET 13