


POOR ORIGINAL COPY

SILVER, GEORGE F  
 ALL DRIVE AND DIT RIGHTS ON  
 PLANS ARE ISSUED TO THE  
 MITTS PLANT 10/15/88  
 SECTION 43.V.5.4

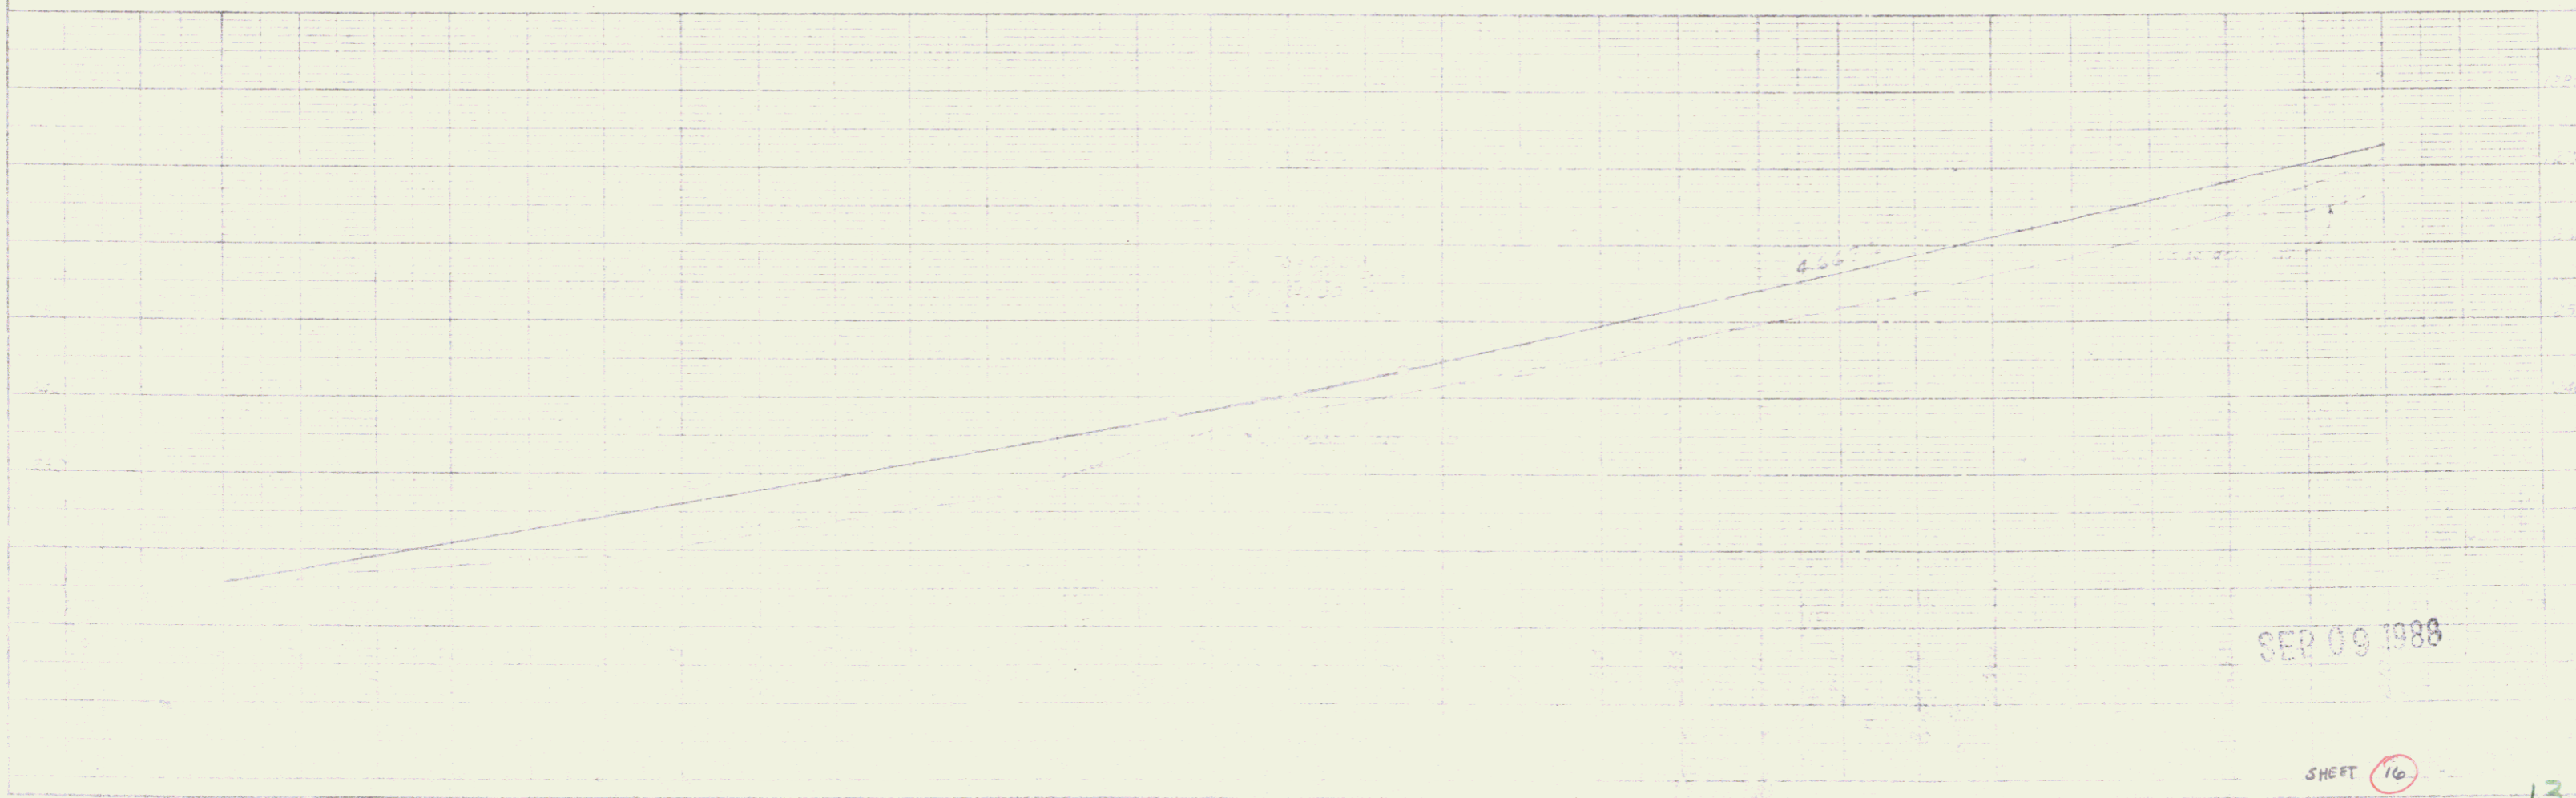

SEP 09 1988

SHEET 16

13