


POOR ORIGINAL COPY

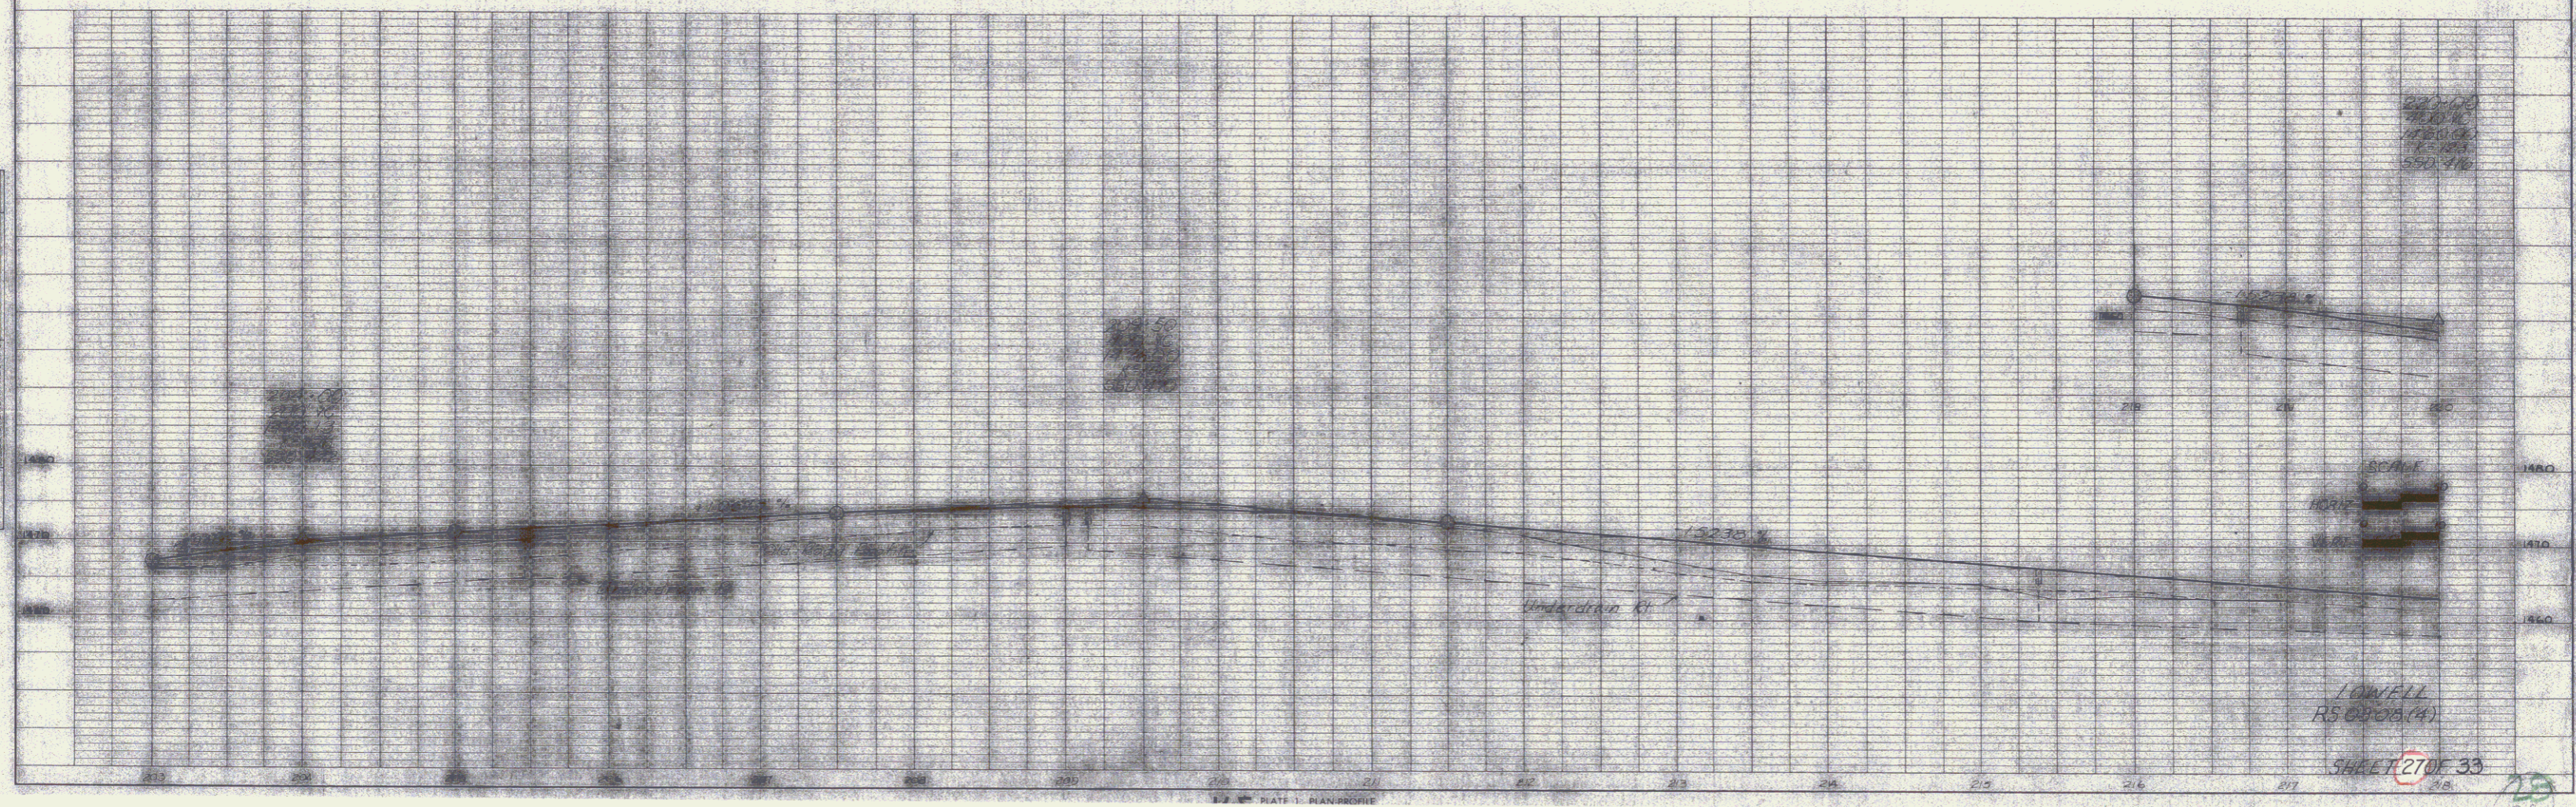

LONGELL  
RS 0308 (4)  
SHEET 27 OF 33

73