

CONSTRUCT DRIVE
ET 283+25


ALL DRIVES AS INDICATED ON
PLANS ARE SUBJECT TO PER-
MITS PURSUANT TO TITLE 19,
SECTION 43, V.S.A.

STONE FILL TYPE II
LT 279+20
RT 283+35
270+28




HENDERSON, WILLIAM

HENDERSON, WILLIAM

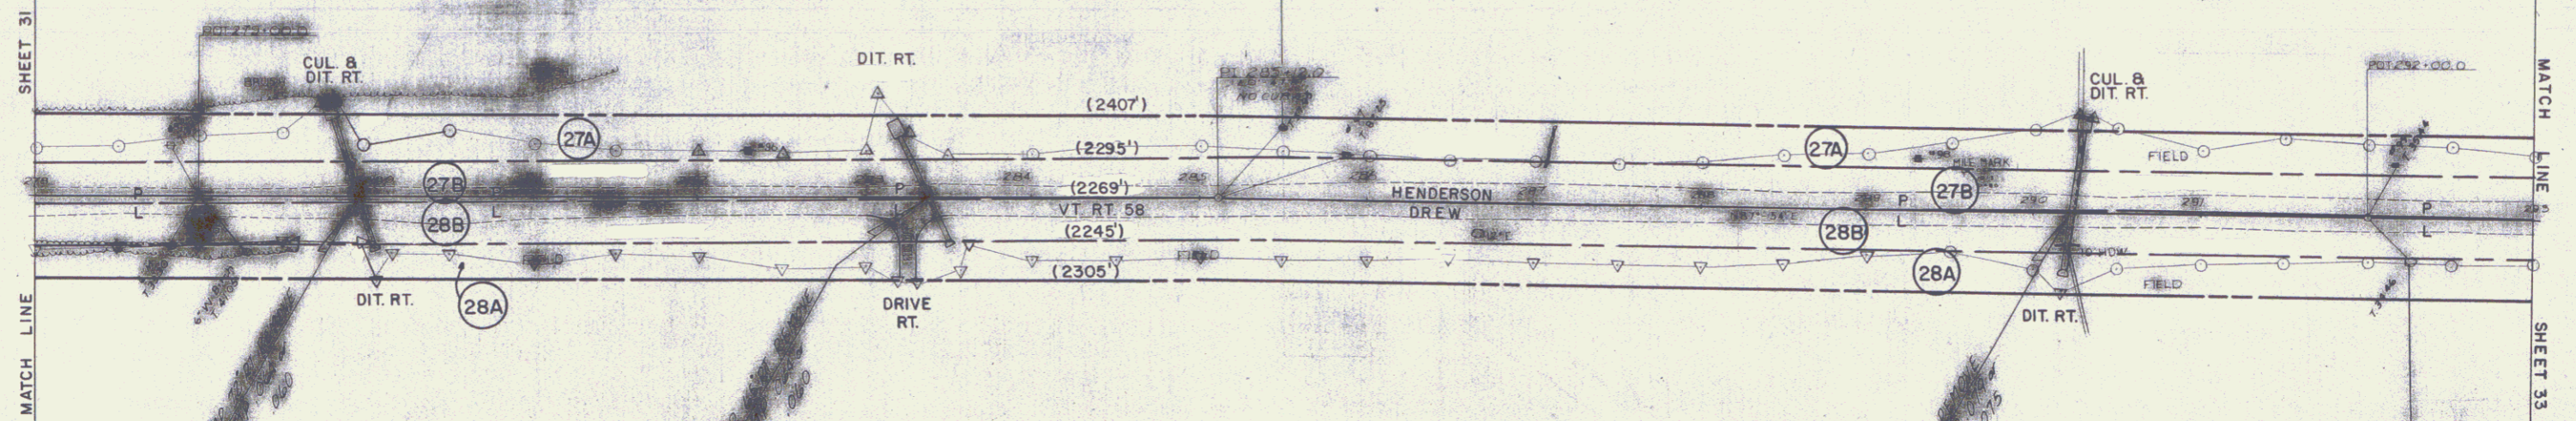

DREW, ALFRED G. & MILOR
POOR ORIGINAL COPY

SCALE

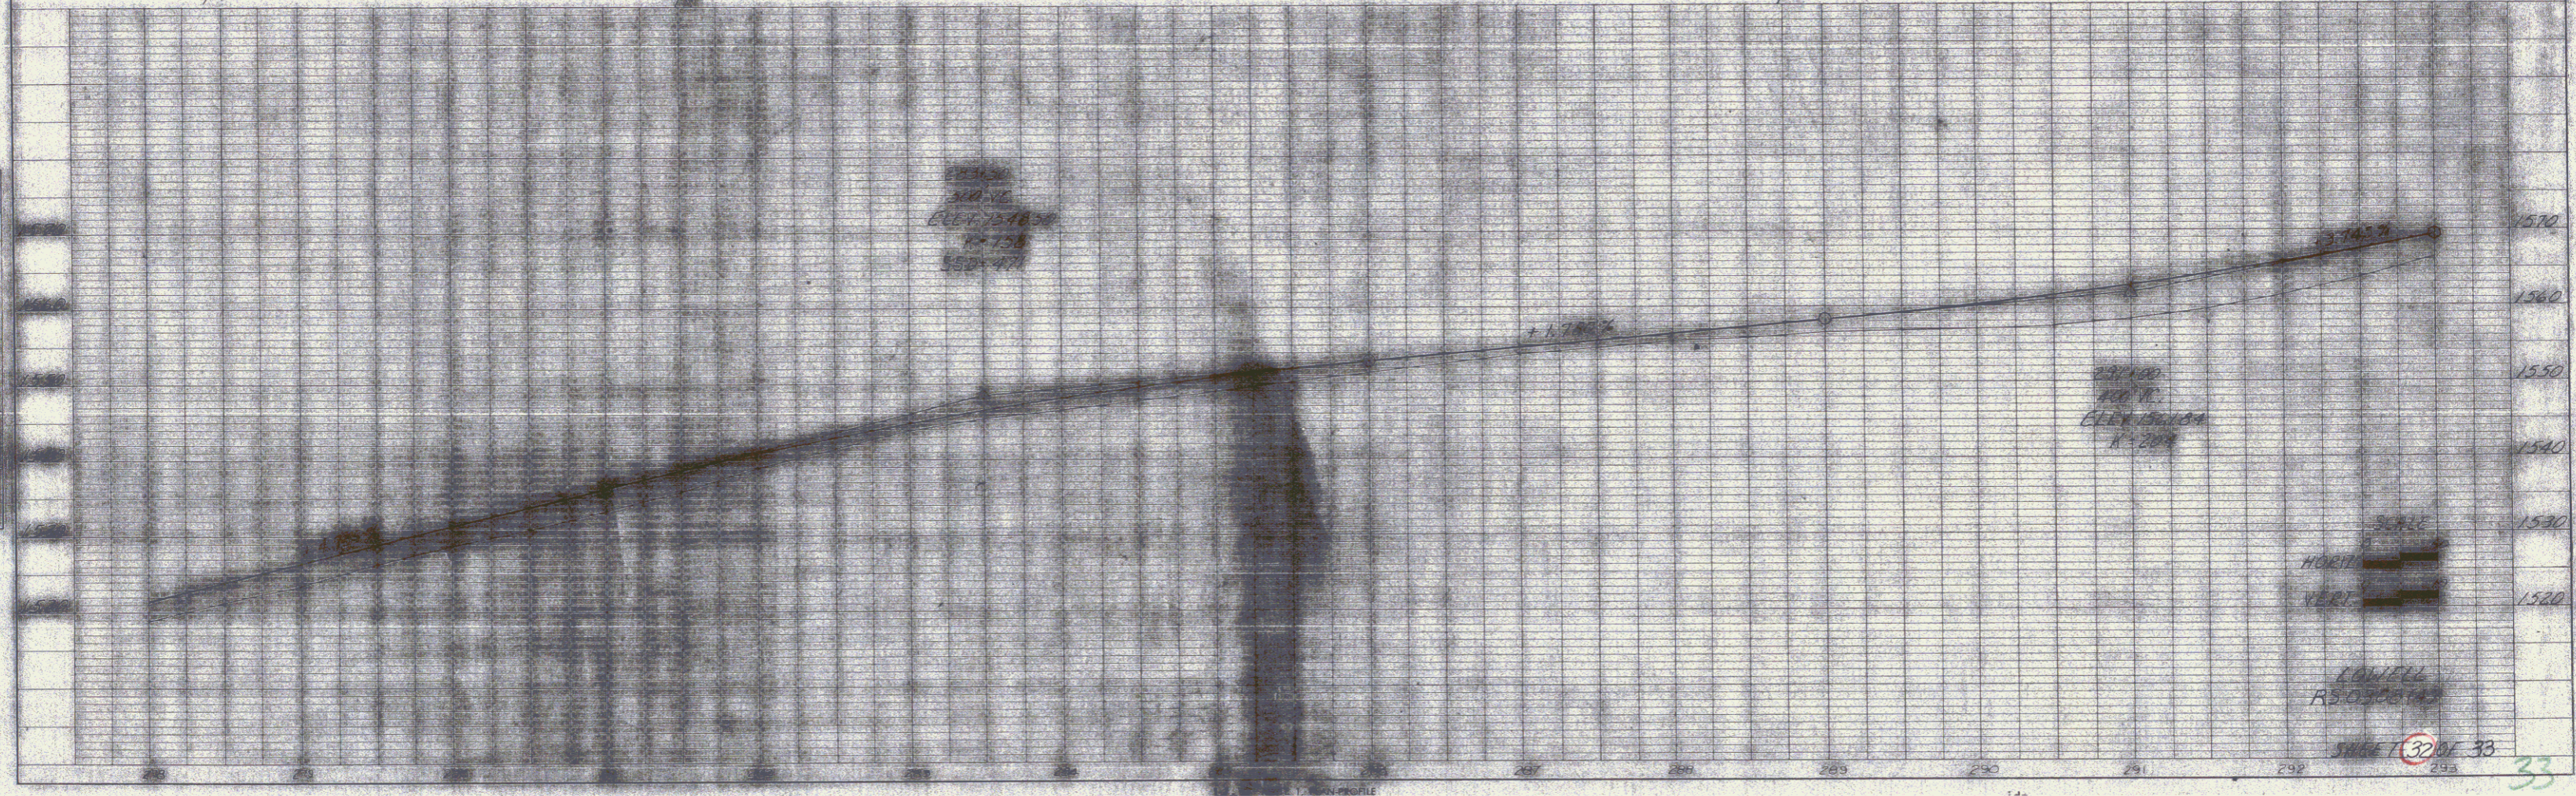

SCALE
HORIZ
VERT

DRAWN
R.S. GOSWAMI

SHEET 32 OF 33

33