


ALL DRIVES AS INDICATED ON PLANS ARE SUBJECT TO PERMITS PURSUANT TO TITLE 19, SECTION 43, V.S.A.

HENDERSON, WILLIAM

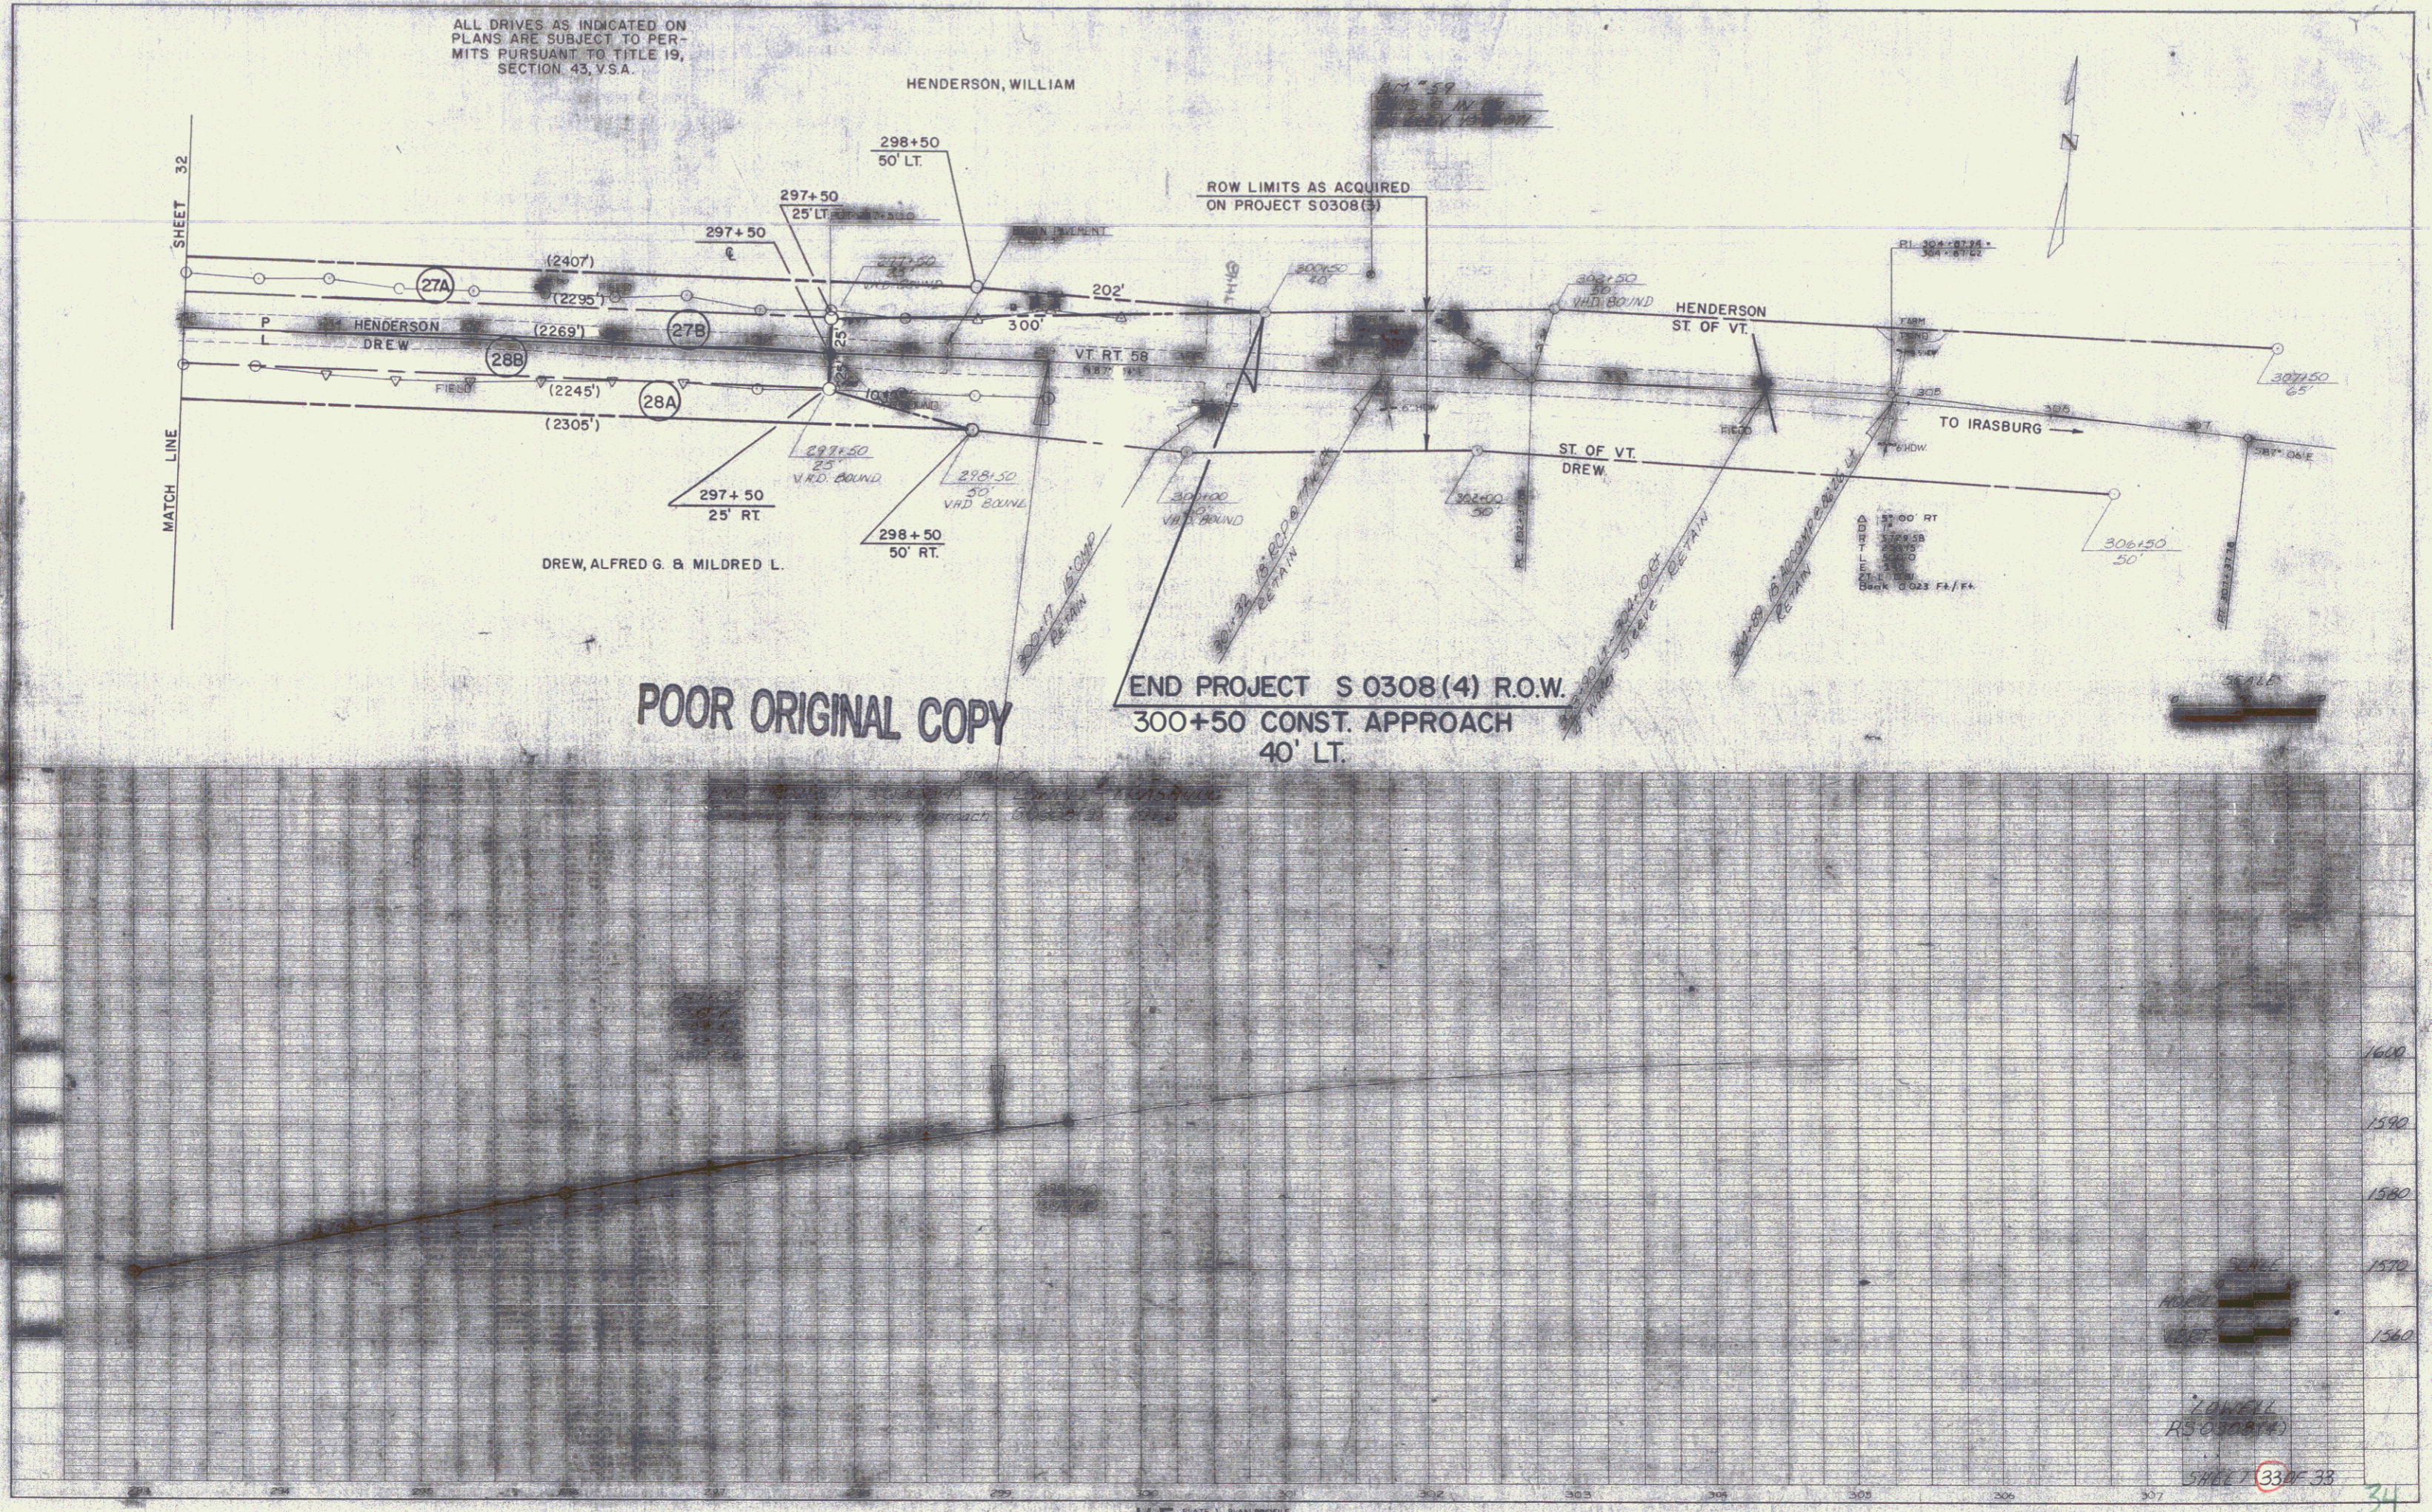

POOR ORIGINAL COPY

END PROJECT S 0308 (4) R.O.W.
300+50 CONST. APPROACH
40' LT.

LUNELL
RS 0308(4)
SHEET 33 OF 33

34