


PLAN
 DRAWN BY
 REVIEWED
 DATE

PLAN
 DRAWN BY
 REVIEWED
 DATE

ROW PLANS
 DRAWN BY
 REVIEWED
 DATE

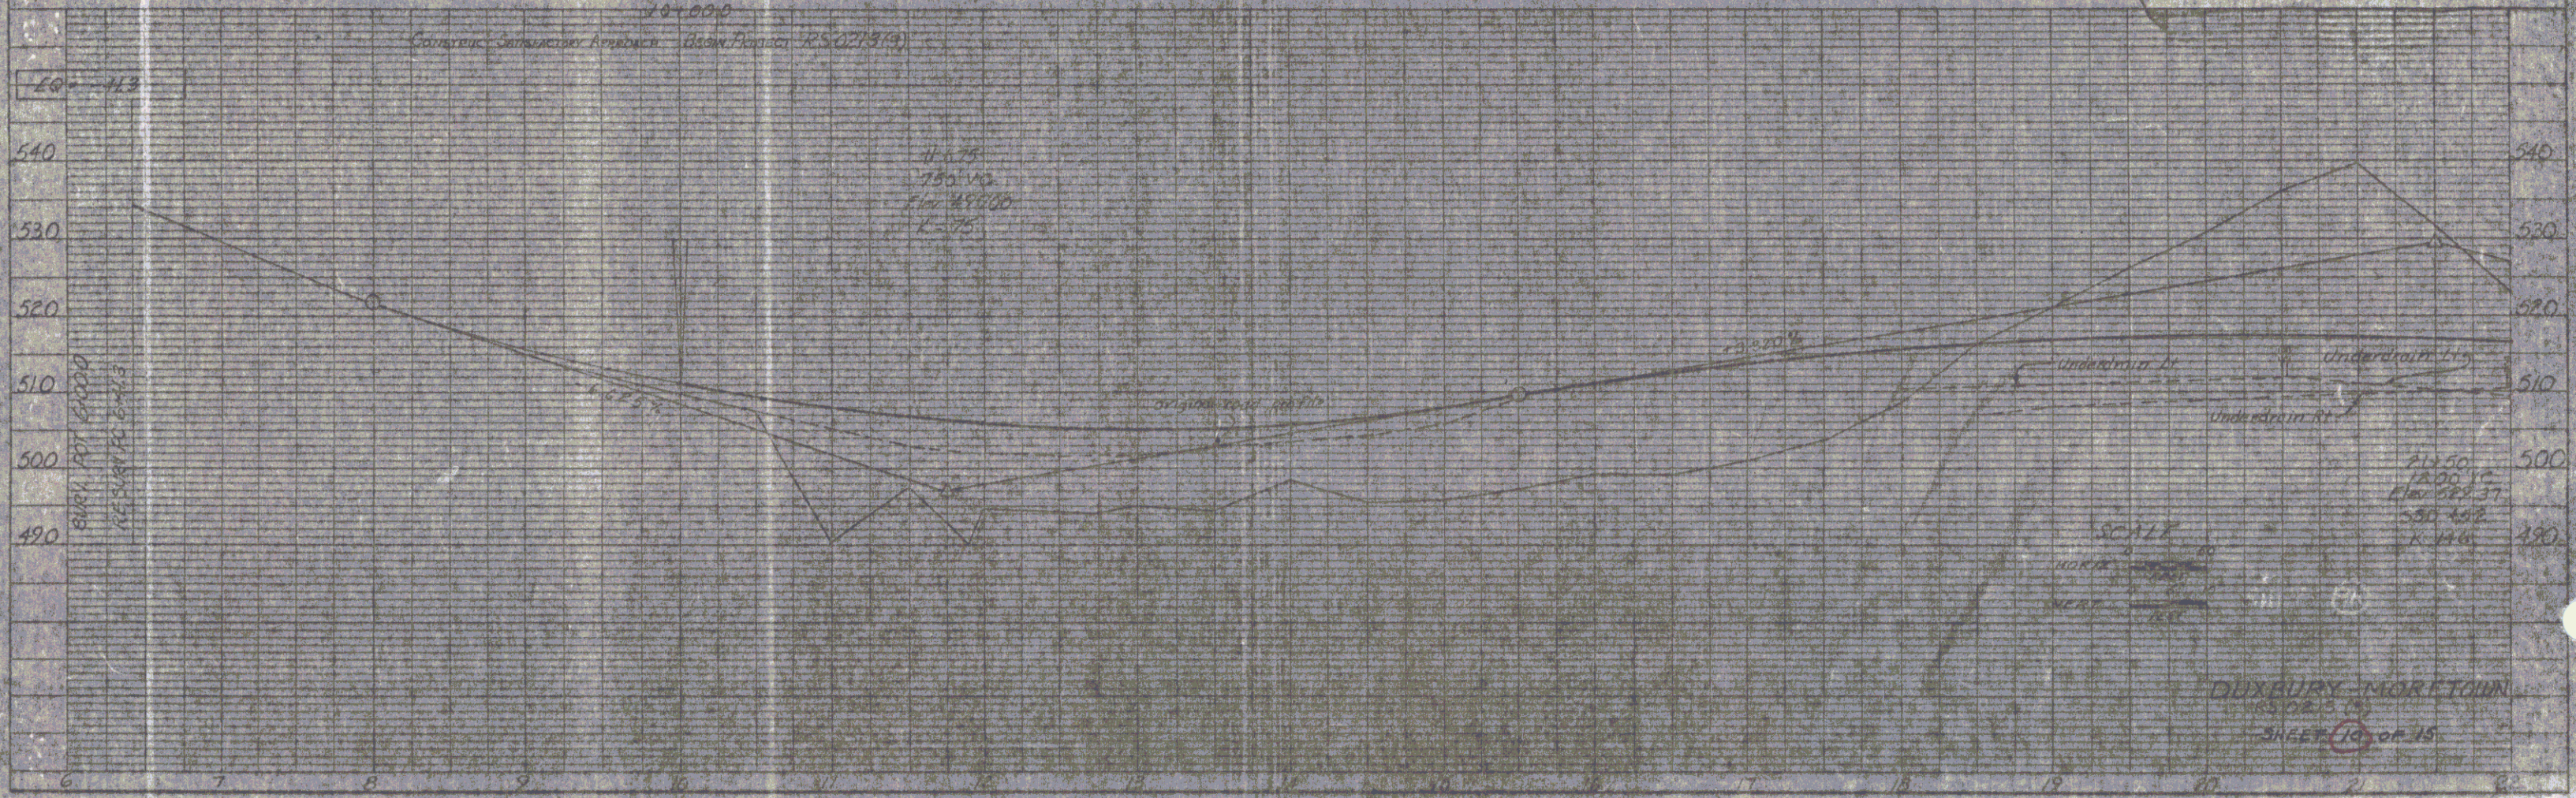

POOR ORIGINAL COPY