


RUTH M. & WAYNE M. LEWIS TO ST. OF VT DATED 10/3/74
PARCEL 1A 0.10A± IN BR 45/438

STA. 43+88 LT. - STA. 44+68 LT.

PARCEL 1B HWY. EASE. 0.05A±

STA. 43+77 RT. - STA. 44+64 RT.

MP 0620

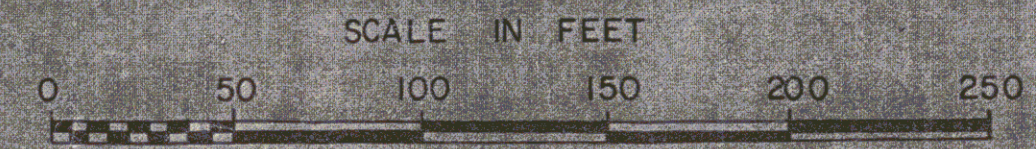

SHEET 13C		
STATE OF VERMONT DEPT. OF HIGHWAYS		
TOWN OF DUXBURY 18		
PROJECT DUXBURY-MORETOWN RS0213 (3)		
APPROX. SCALE 1"=50'	DATE 9-23-74	DRAWN BY KDP