


ML POC 224+70.00
 SL 4 POC 41+51.25
 ML POC 225+34.00
 CH Line 3 POC 5+00.00
 CH Line 3 POC 6+00.00
 ML POC 228+51.42
 Trv POC 229+00.50
 ML POC 230+05.82

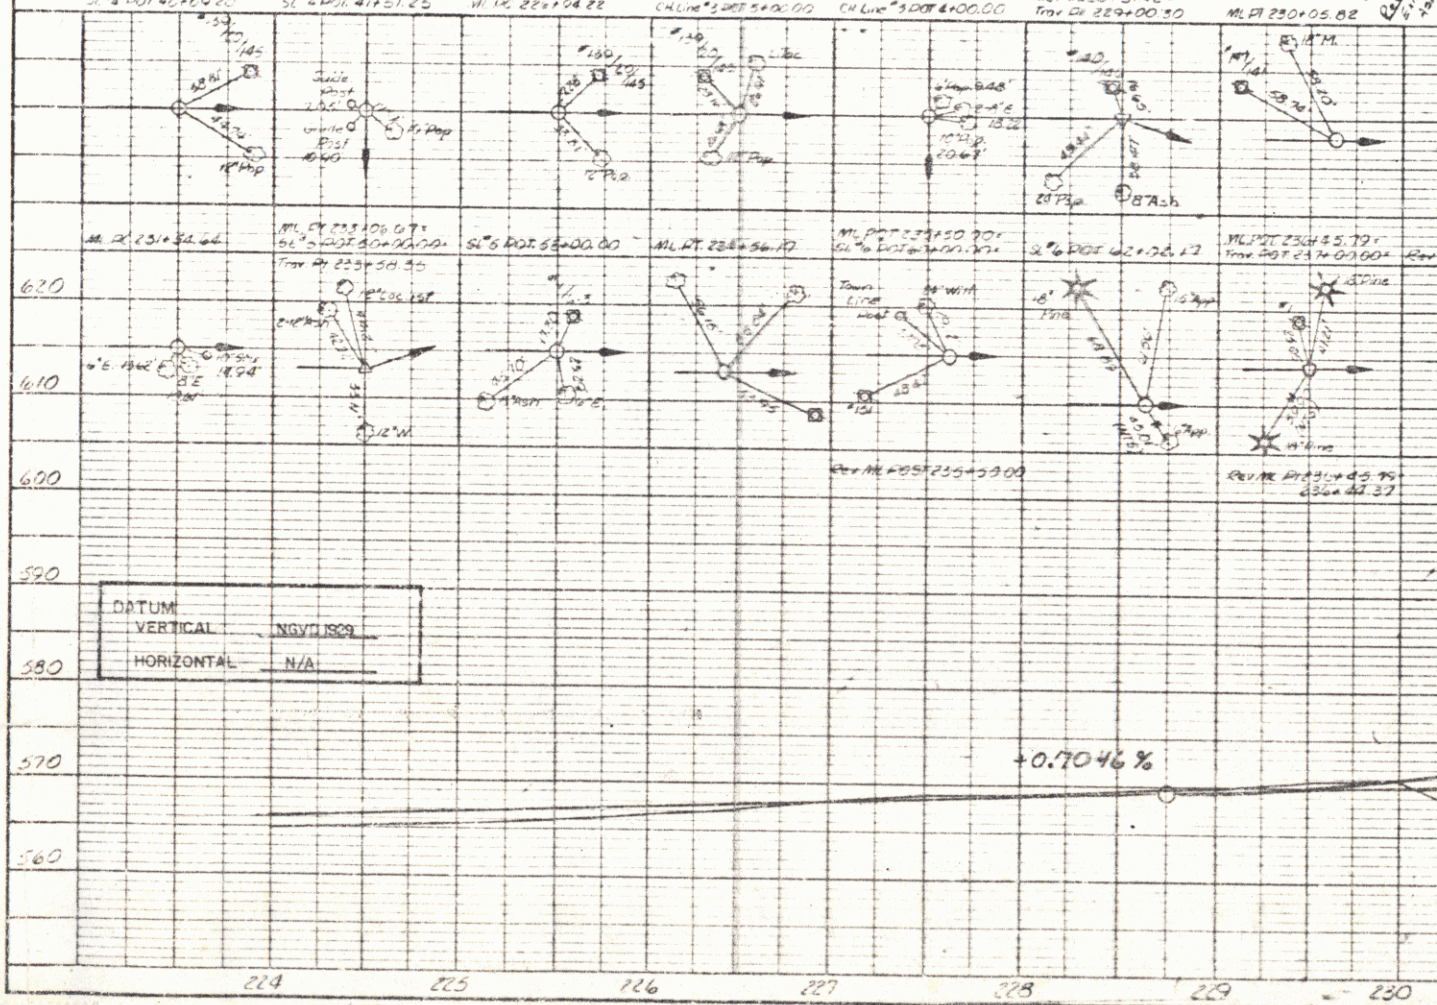

DATE	
BY	
PROJECT	
NOTE BOOK	
NO.	

DATUM
 VERTICAL NGVD 1989
 HORIZONTAL N/A

Rev 2/23/00
 5/19
 B.K. 0.055 FHFT