


Info. Existing TH 40 from 1632+75 (1632+75) to
TH 41 Rebe 35+50 AT to be graded and sanded.

DANVILLE BOSTON RR SIDEWALK
1631+0 - 1681+0

SPECIAL PATCH W/
ST. ONE MULTIPLE
1641+5 - 1644+0

GUARD RAIL STANDARD STEEL BEAM
W/ WOOD POSTS, TYPE II
RT
1631+0 - 1631+50
1647+12.5 - 1647+0

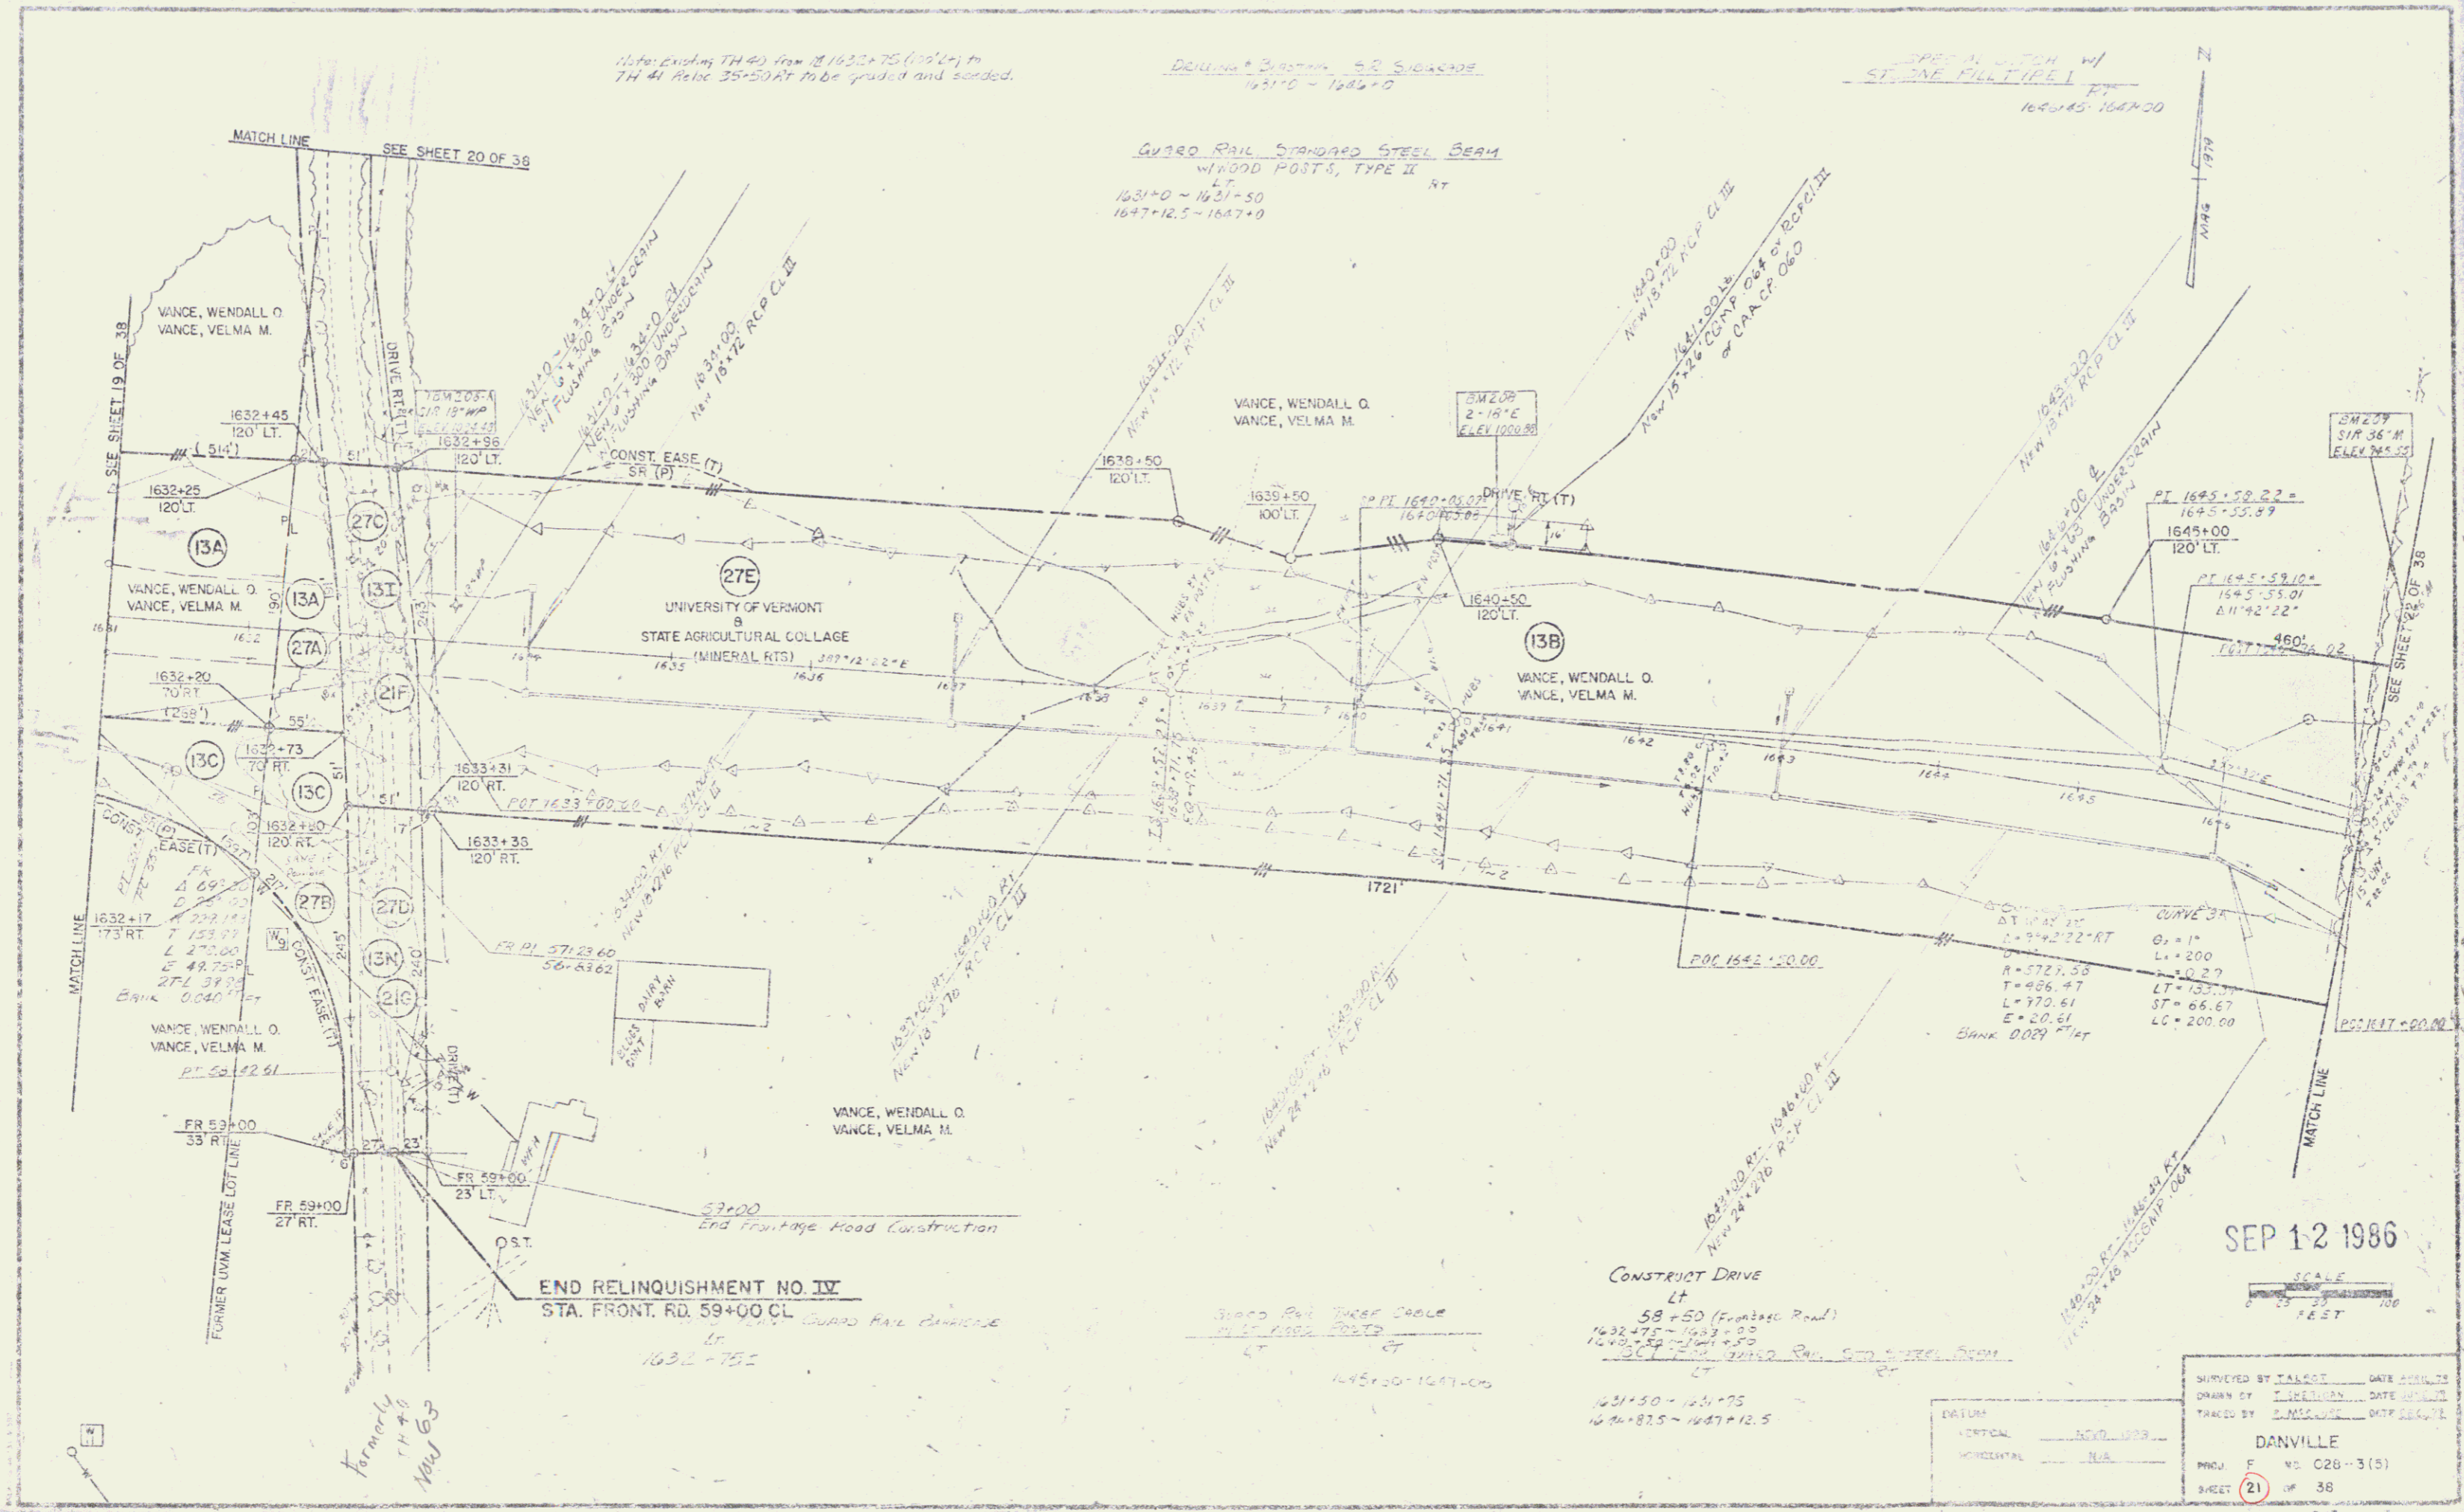

SEP 12 1986

SCALE
1" = 40'

END RELINQUISHMENT NO. IV
STA. FRONT RD. 59+00 CL
1632 - 752

CONSTRUCT DRIVE
LT
58+50 (Frontage Road)
1632+75 - 1633+50
1640+50 - 1641+50
1647+12.5 - 1647+0

DATUM
VERTICAL - NAVD 83
HORIZONTAL - NAD 83

DESIGNED BY JALCOT DATE 08/12/86
DRAWN BY JALCOT DATE 08/12/86
CHECKED BY JALCOT DATE 08/12/86
DANVILLE
PROJ. F VS C26-3(5)
SHEET 21 OF 38