


SPECIAL DITCH W/  
STONE FILL TYPE I  
LT RT  
1647+00 - 1651+00

3' BULK FILL  
1643+75 - 1650+25  
1650+25 - 1660+17  
1660+17 - 1663+00


TREATED TAPER  
1658+25 - 1661+60 1661+60 - 1665+00

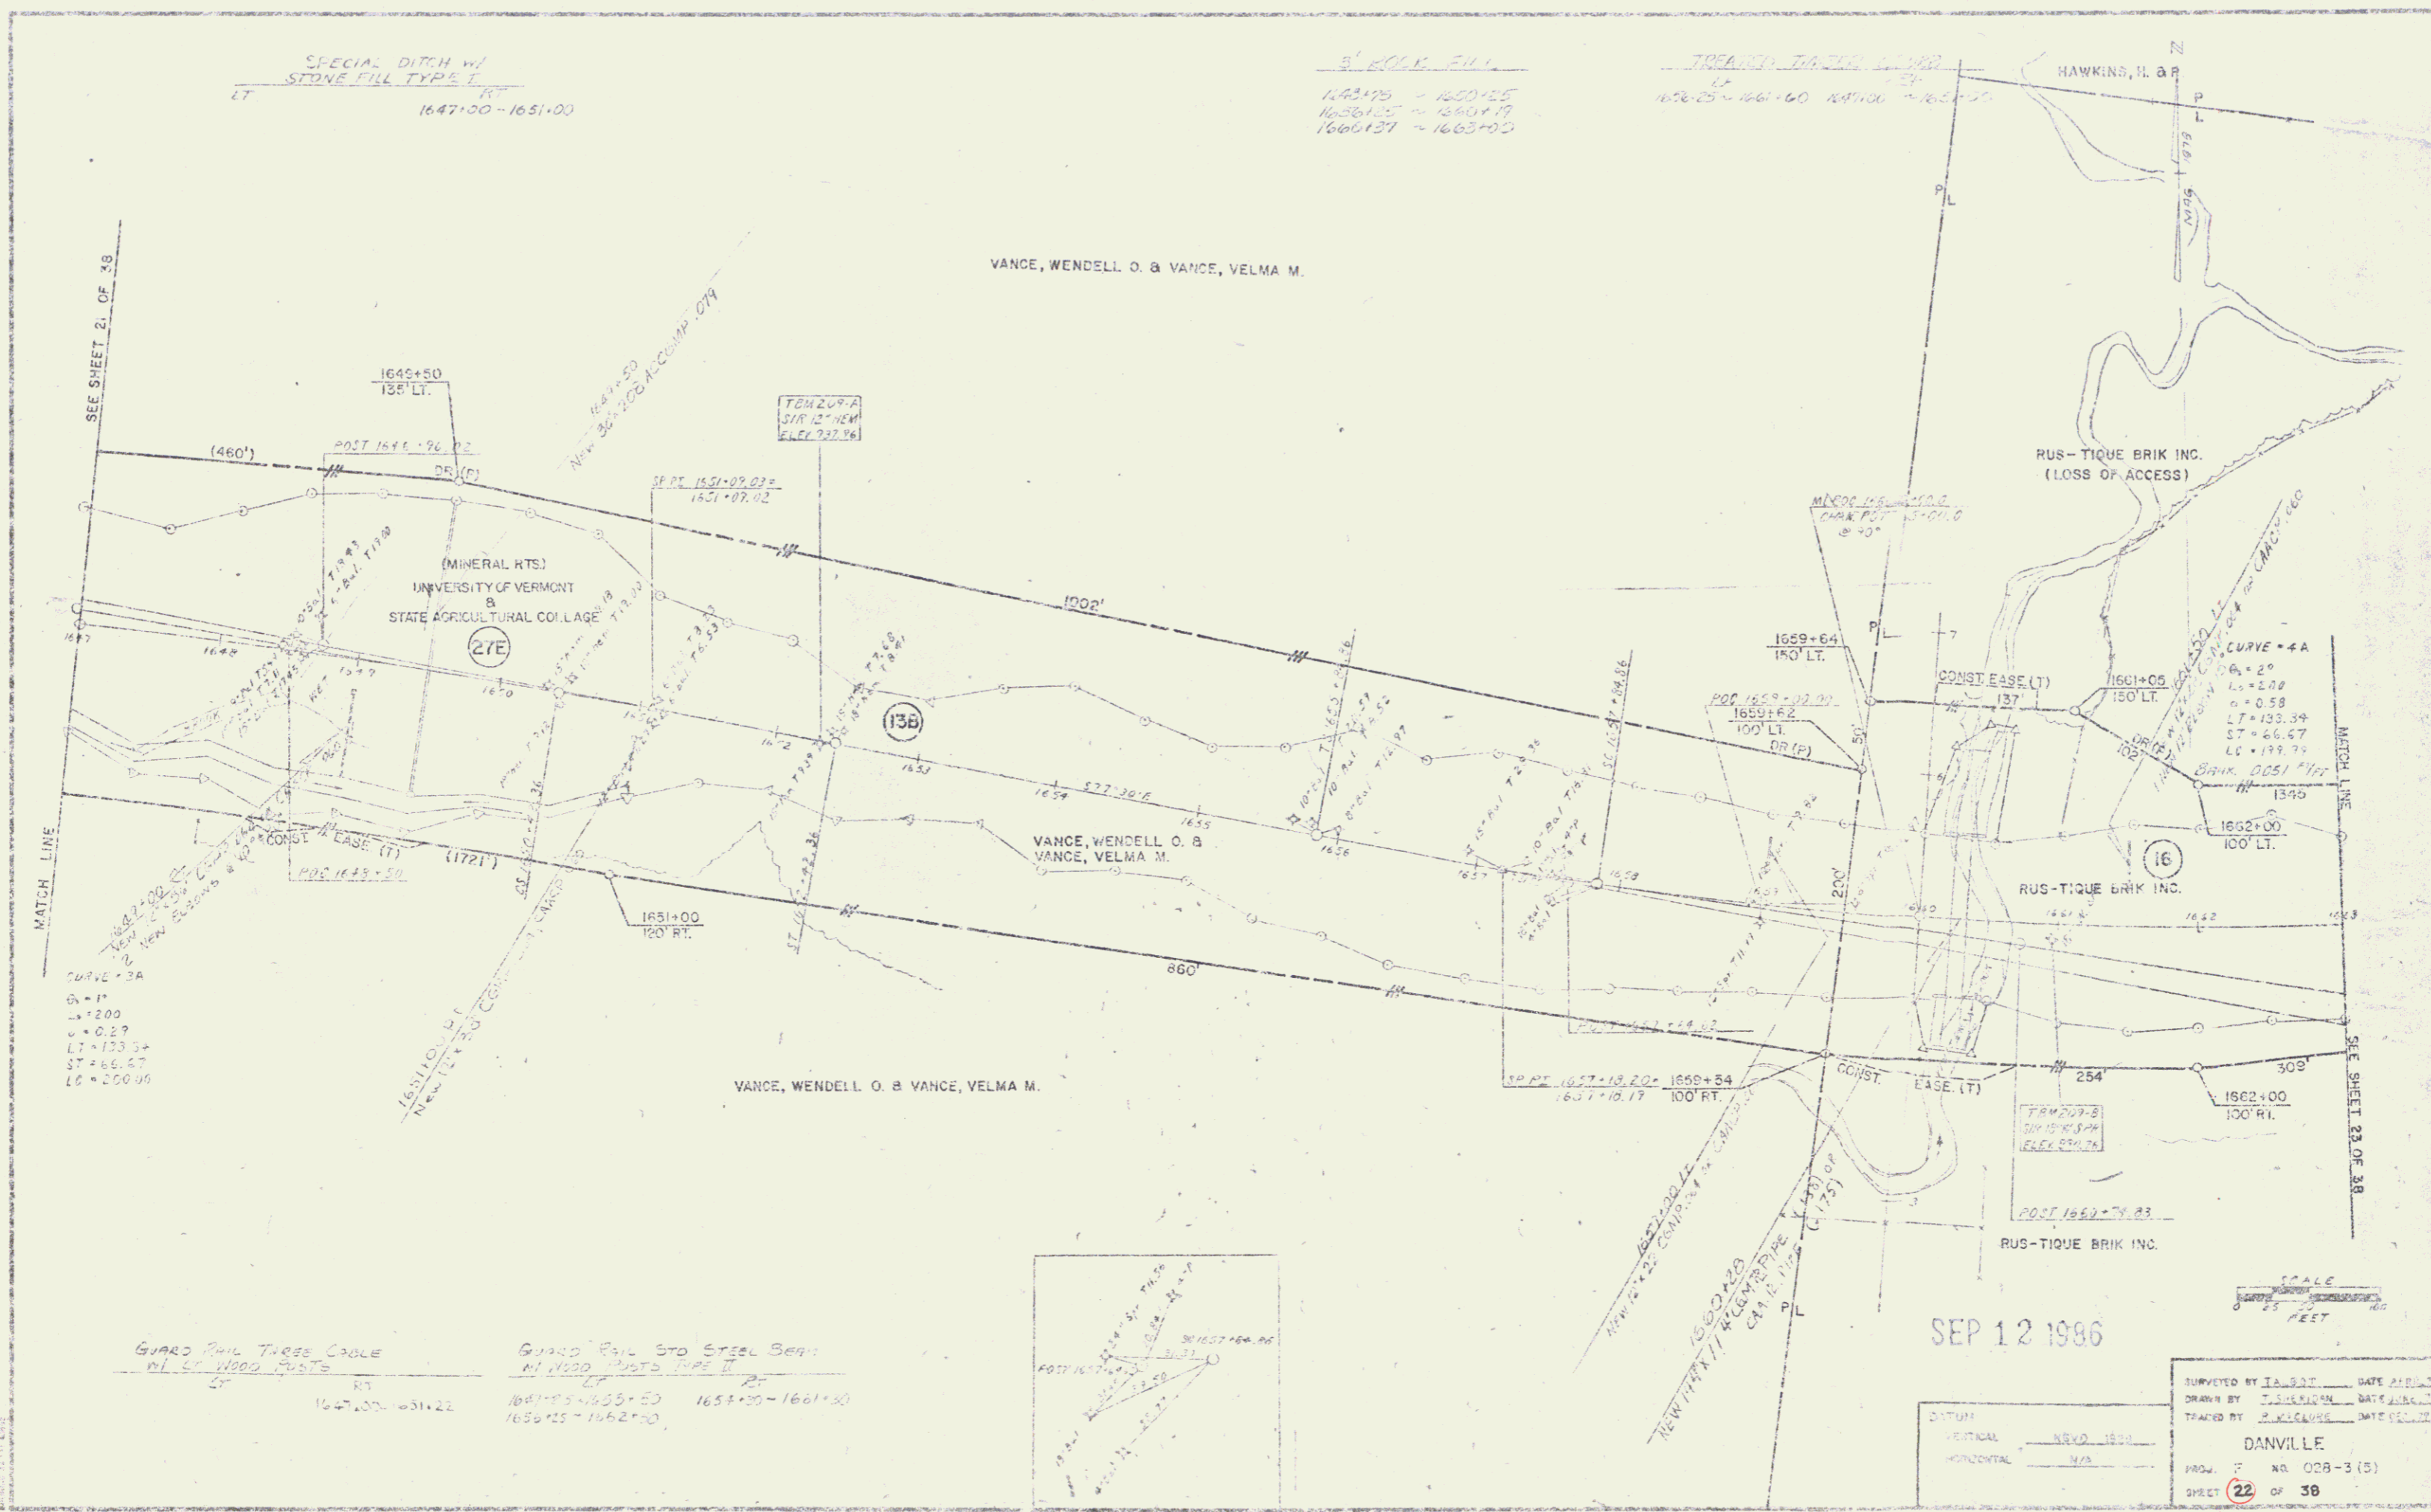

CURVE 2A  
D = 11  
L = 200  
C = 0.29  
LT = 133.3+  
ST = 66.67  
LB = 200.06

GUARD RAIL THREE CABLE  
W/ 4" WOOD POSTS  
RT  
1647+00 - 1651+22

GUARD RAIL STD STEEL BEAM  
W/ 4" WOOD POSTS TYPE II  
RT  
1647+00 - 1651+22  
1651+22 - 1661+00  
1661+00 - 1662+00

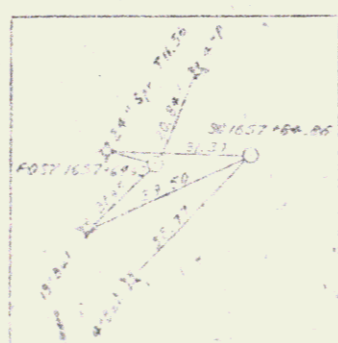

SEP 12 1986

SCALE  
1" = 25 FEET

DISTION  
VERTICAL 1/2" = 10'  
HORIZONTAL 1/4" = 10'

SURVEYED BY J. B. S. T. DATE 8/11/86  
DRAWN BY J. B. S. T. DATE 8/11/86  
TRACKED BY J. B. S. T. DATE 8/11/86  
DANVILLE  
PROJ. NO. 028-3(5)  
SHEET 22 OF 38