



U.S. ROUTE 7

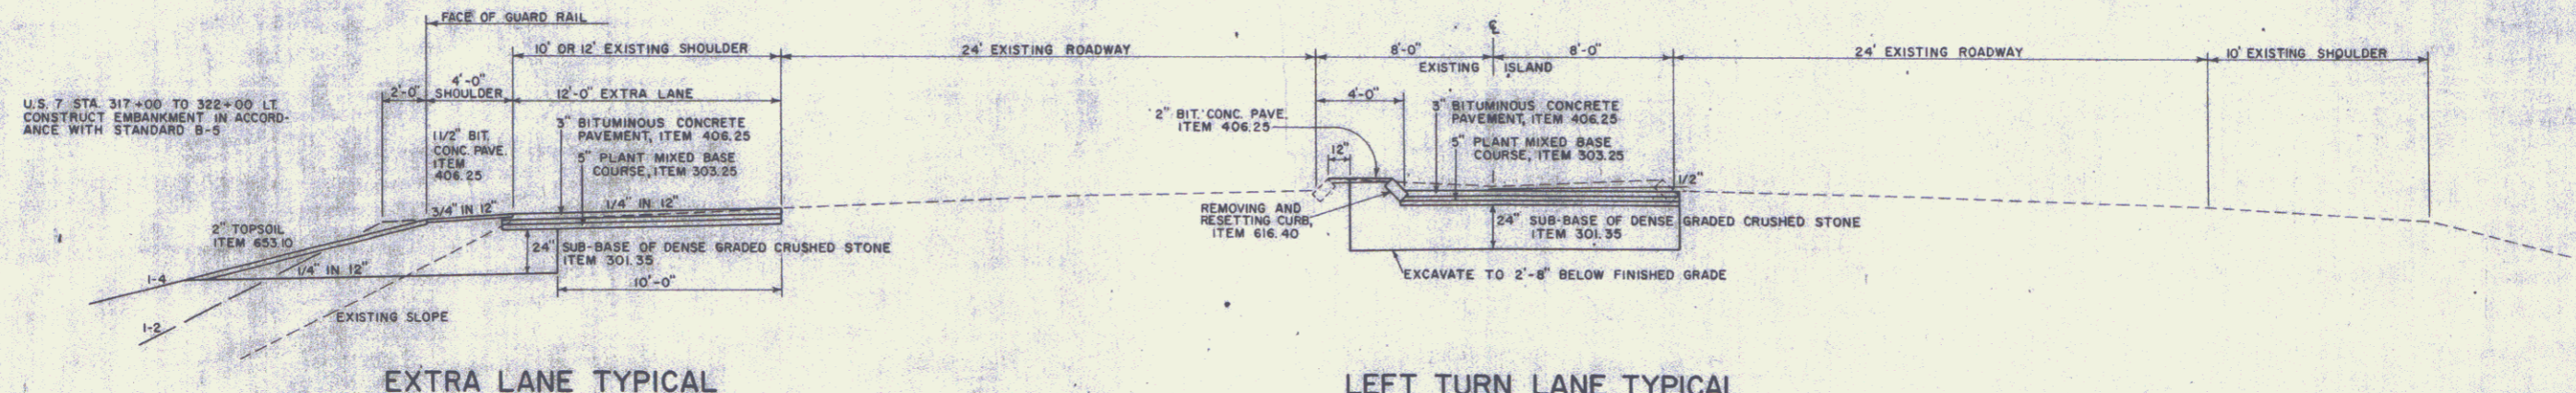


EXTRA LANE TYPICAL


LEFT TURN LANE TYPICAL

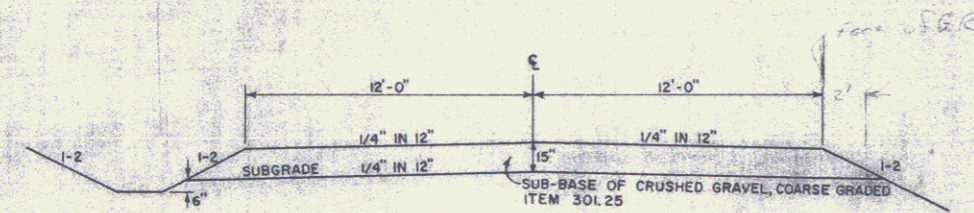


T. H. 5 & FAIRVIEW ST.  
TYPICAL SECTION

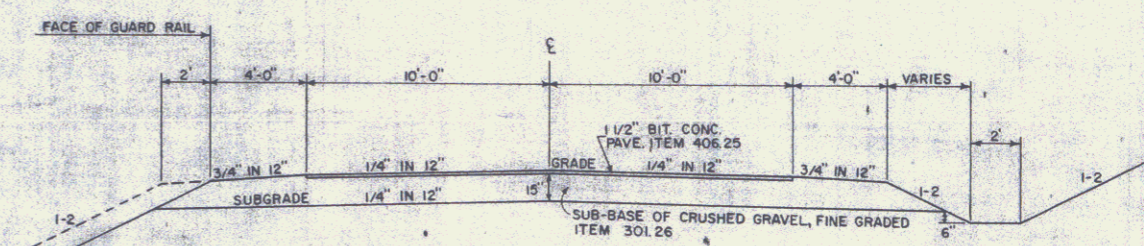

T. H. 22 TYPICAL SECTION

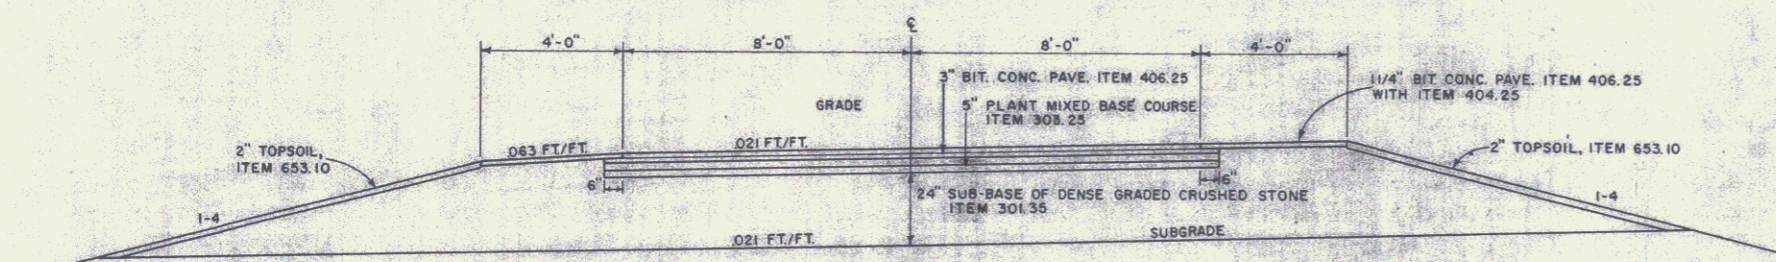

RAMP C & D SPUR  
TYPICAL SECTION

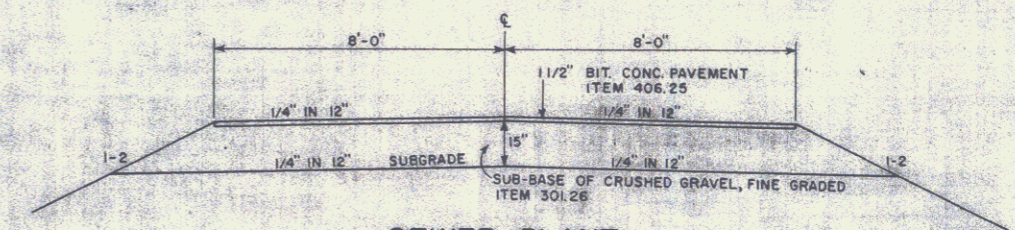

SEWER PLANT  
ACCESS ROAD

WEST RUTLAND - RUTLAND	
DRAWN BY 026	DATE 7/75
TRACED BY 026	DATE 7/75
STAGE 1 CONSTRUCTION	
PROJ. F NO. 020-1(11)	
SHEET 8 OF 72	