
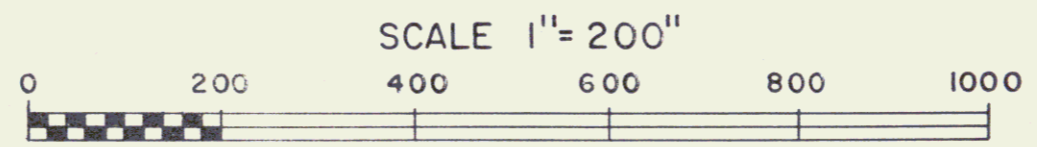
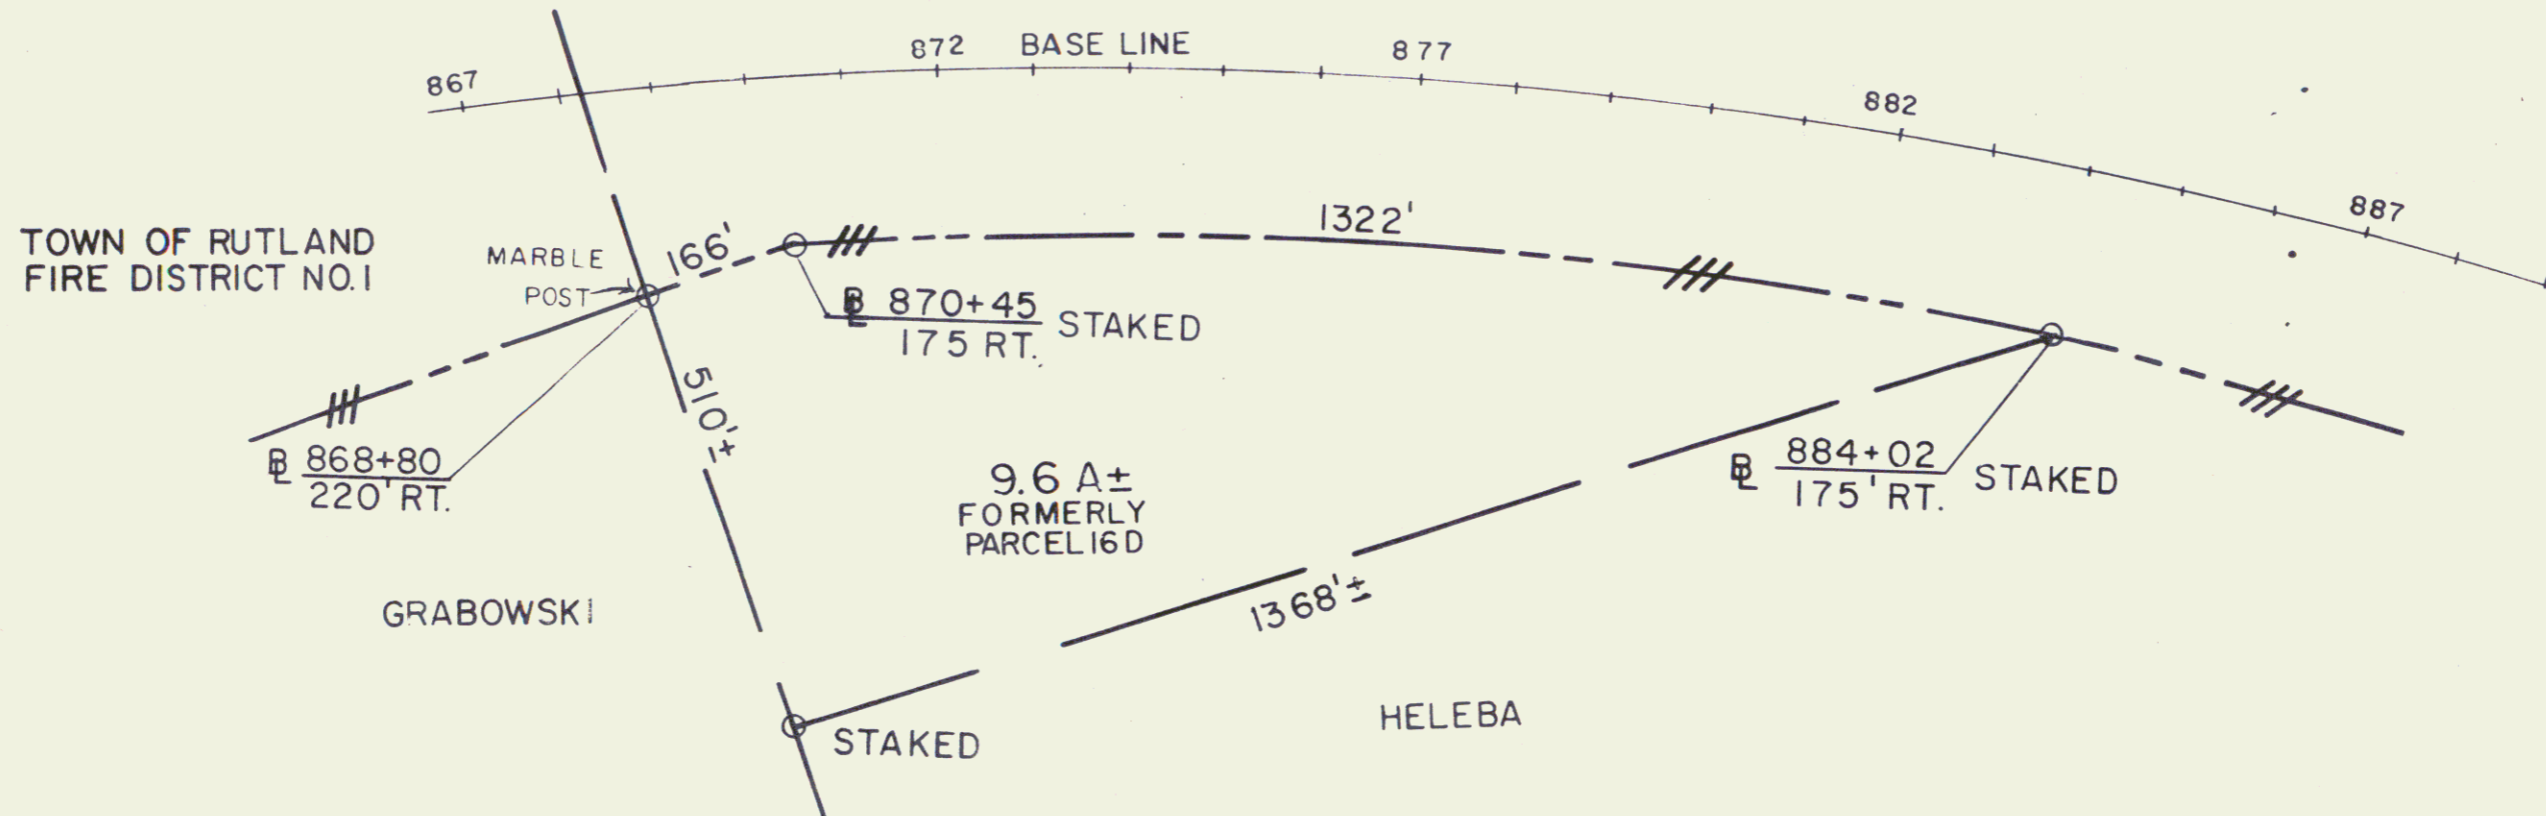


ACQUIRED FROM WILLIAM E. SHARP, ROBERT A. SHARP SR. & MARY A. SHARP BY CONDEMNATION DATED DEC. 15, 1976 & RECORDED DEC. 20, 1976 IN BK. 24 PGS. 526-532 AND AMENDMENT NO. 1 RECORDED APRIL 9, 1977 IN BK. 25 PGS. 82-84

MP 0043

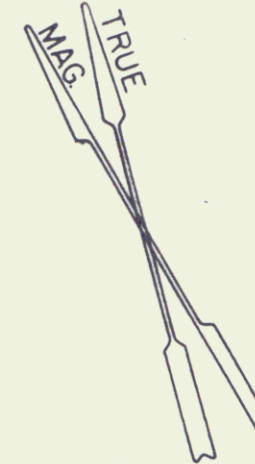

U.S. 4
REF SHEETS 35,36 35B

STATE OF VERMONT
DEPT. OF HIGHWAYS

TOWN OF RUTLAND 38

PROJECT WEST RUTLAND-RUTLAND F020-1(11)
APPROX. SCALE 1"=200' DATE 12/22/77 DRAWN BY FJM