


CONSTRUCT COMMERCIAL DRIVE
U.S. 7 326+00 RT.

REMOVING & RESETTING CURB
U.S. 7 319+50 TO 328+40 (ISLAND)

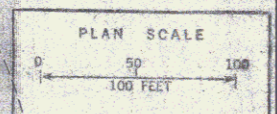

WEST RUTLAND - RUTLAND

SURVEYED BY	FALL	DATE	JUNE '75
DRAWN BY	DZG	DATE	JULY '75
TRACED BY	DZG	DATE	JULY '75

PRD. F. No. 020-1(11)
SHEET 44 OF 72