


DATE	
PROJECT	
SCALE	
BY	
CHECKED	
DATE	



DATE	
PROJECT	
SCALE	
BY	
CHECKED	
DATE	

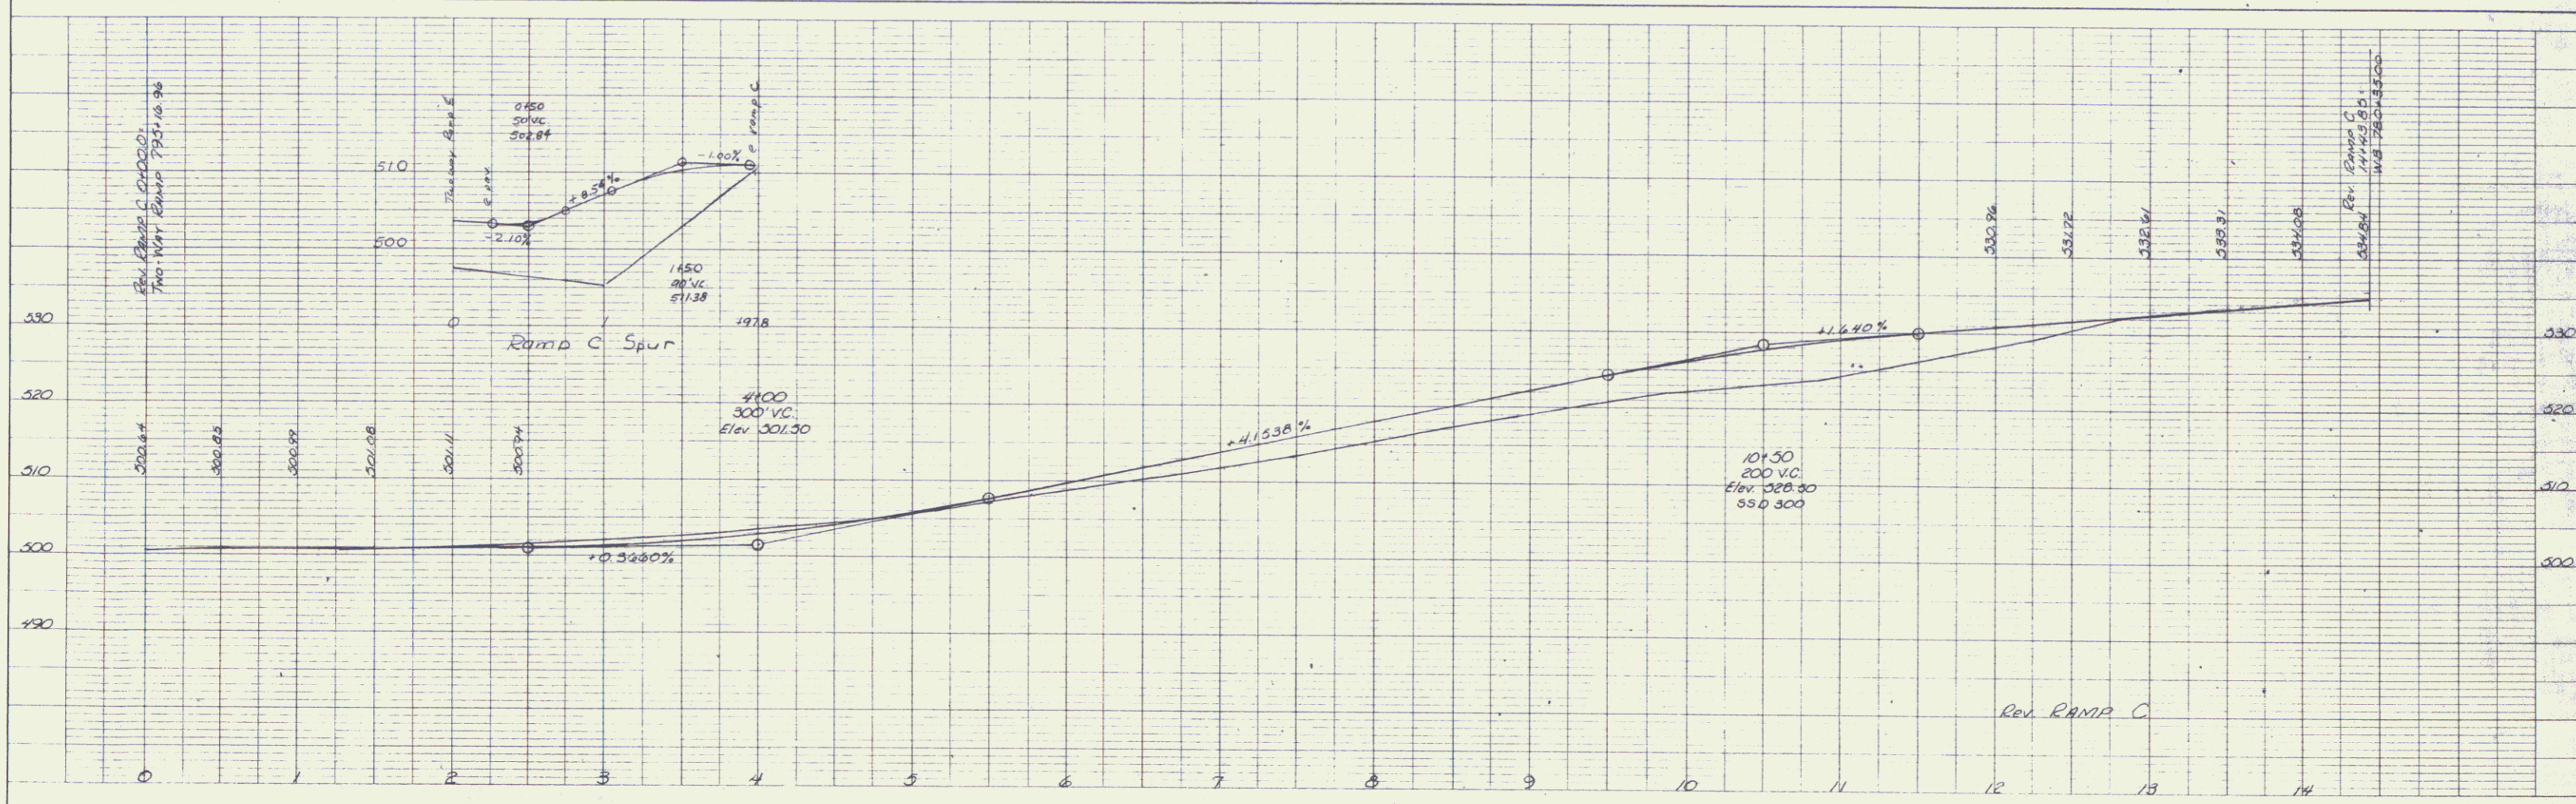