


PLAN	DATE	
	BY	
NOTE BOOK NO.	DESIGNED	
	ALIGNED CHECKED	
	BY	

PROFILE	DATE	
	BY	
NOTE BOOK NO.	DESIGNED	
	ALIGNED CHECKED	
	BY	

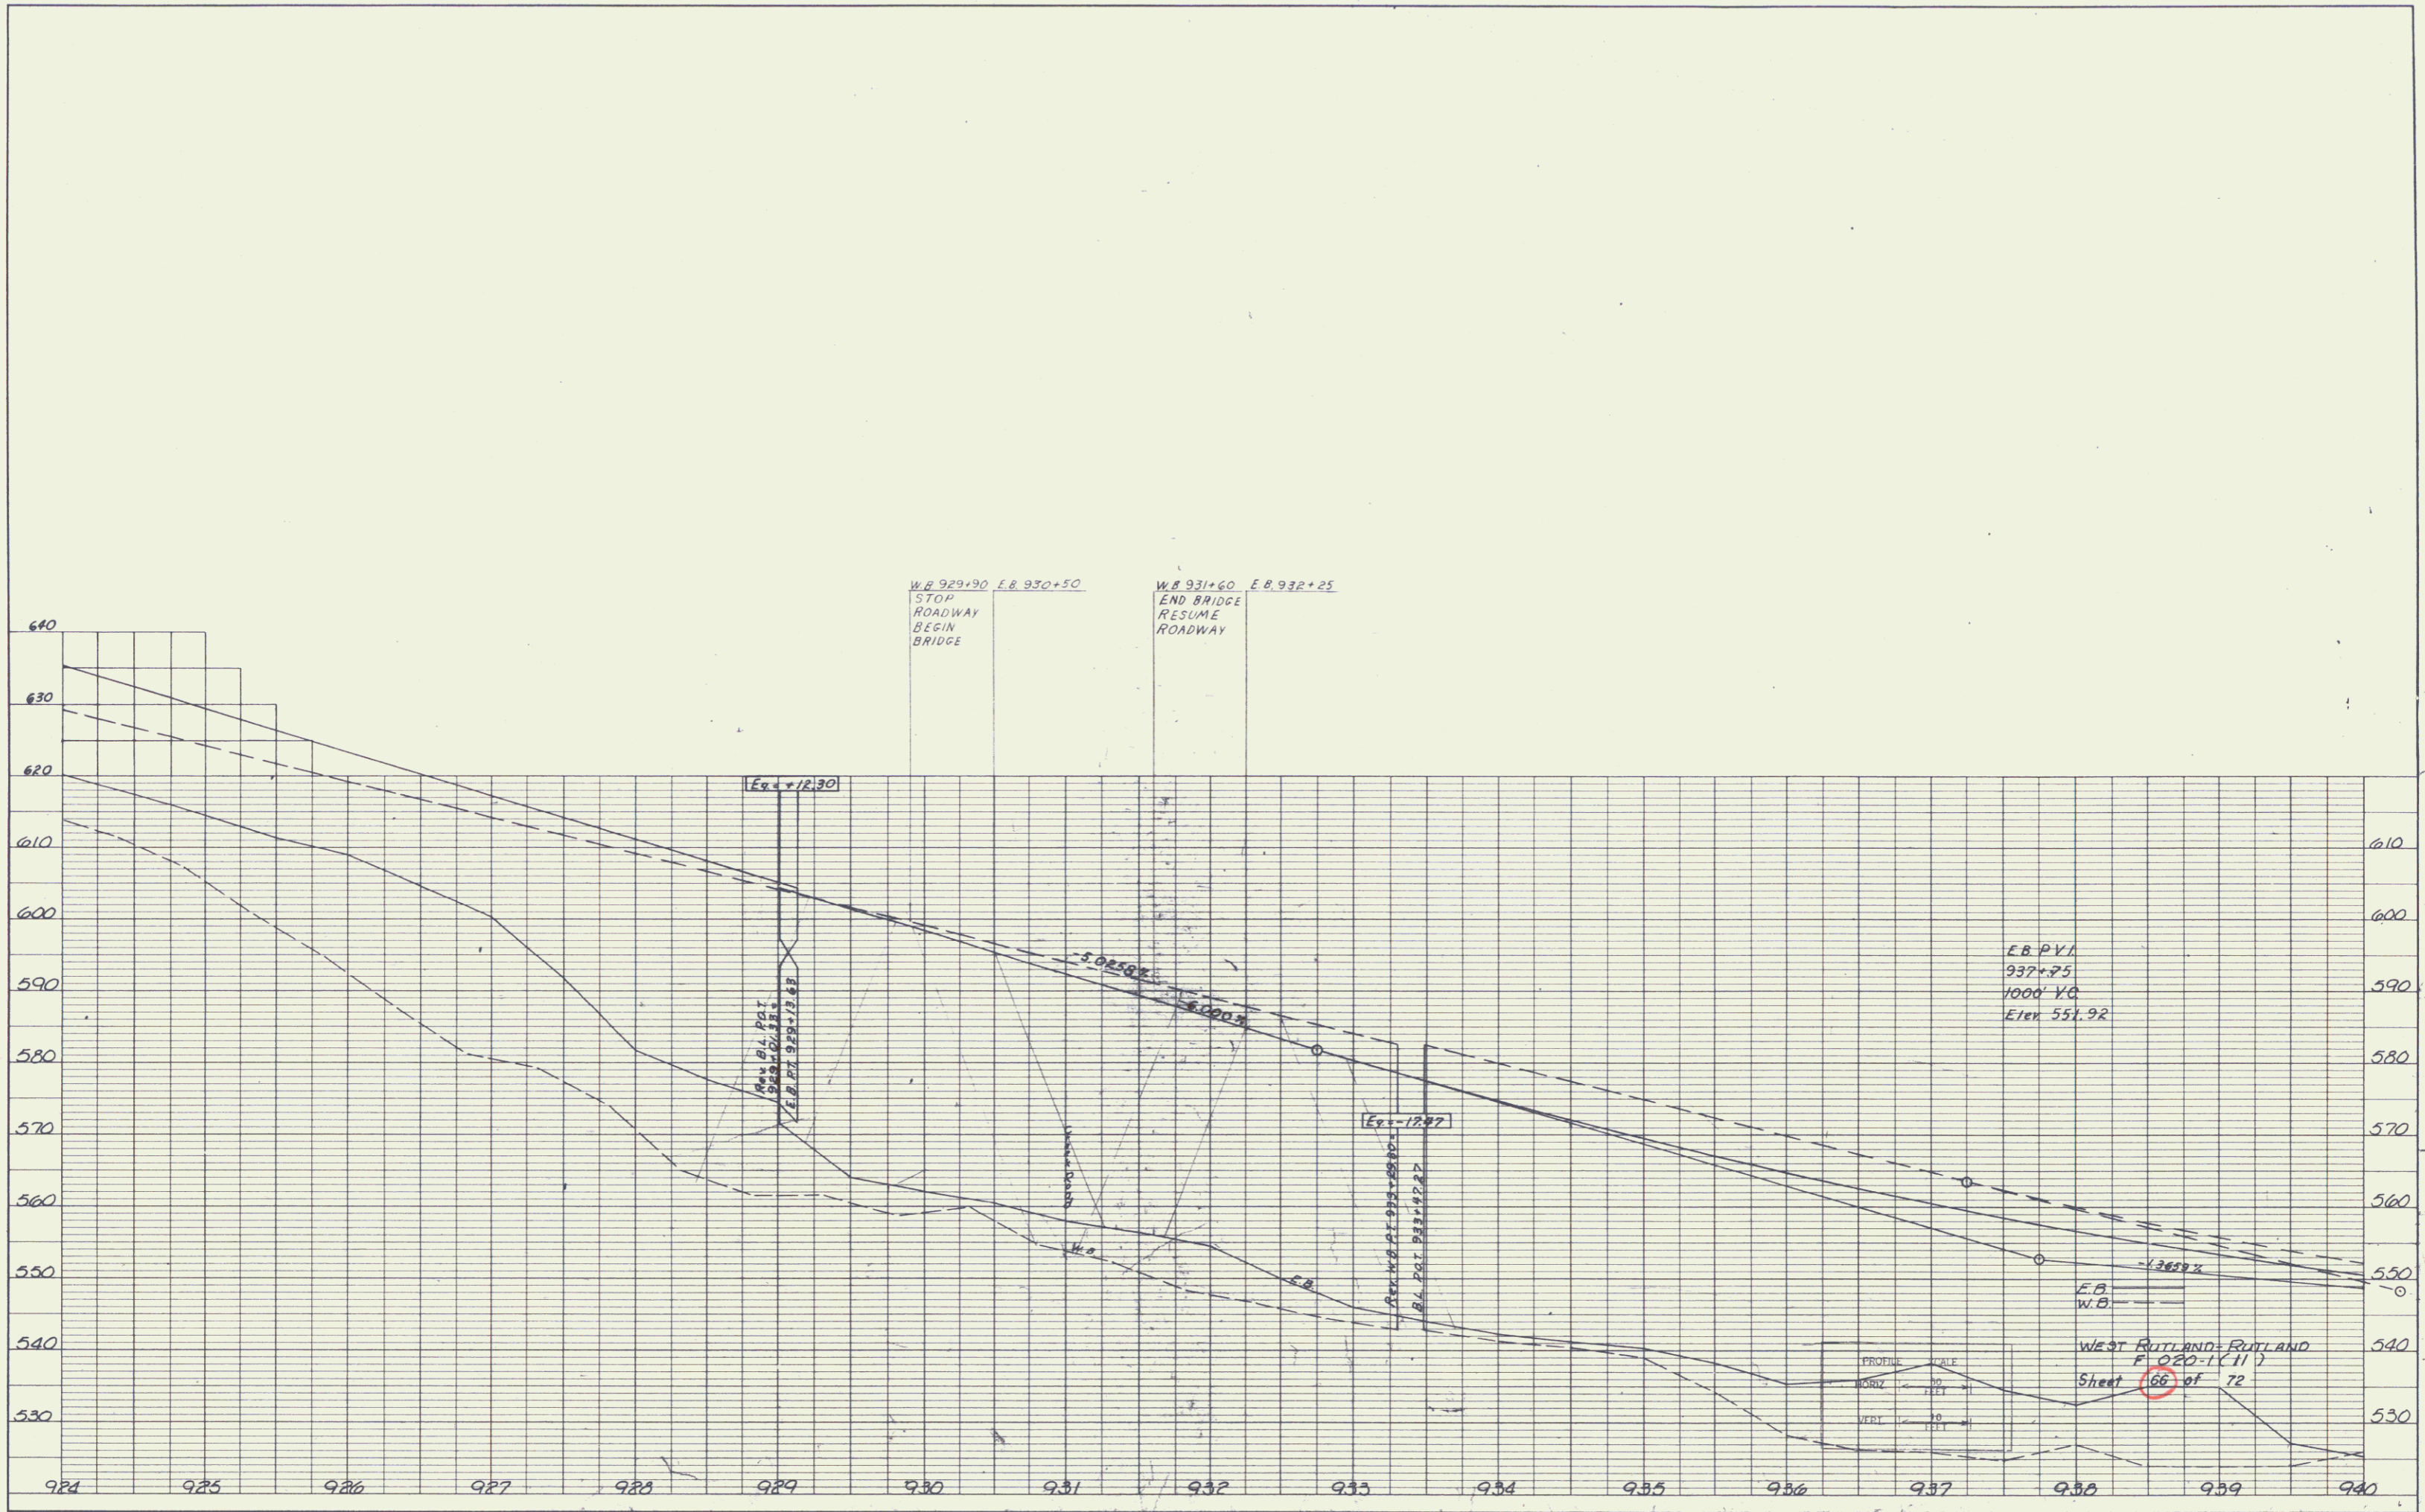

K&E PLATE 1, PLAN-PROFILE
KIMBLE & HERR CO.