
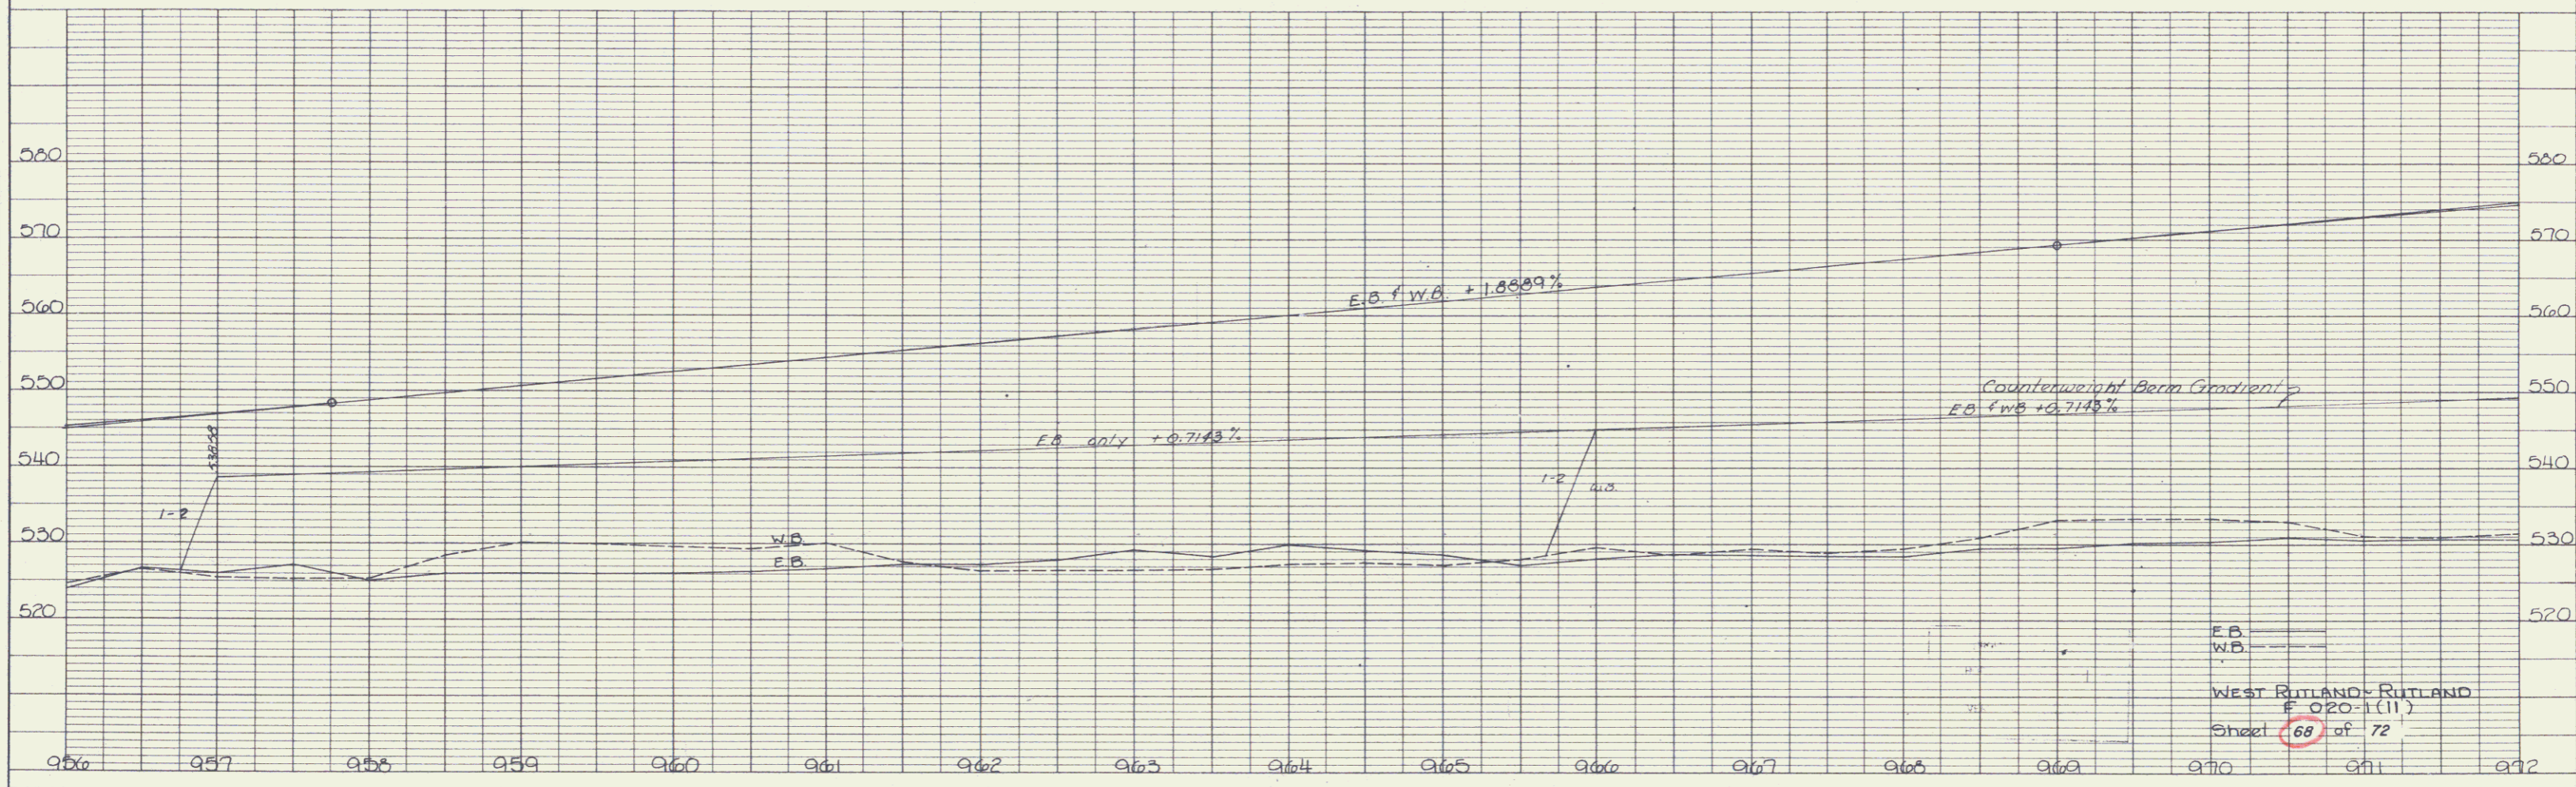


PLAN	DATE	
	BY	
NO. _____	APPROVED:	
	NOTE BOOK NO. _____	DATE CHECKED: _____

PROFILE	DATE	4/73
	BY	W. J. Farnham
NO. _____	APPROVED:	
	NOTE BOOK NO. _____	DATE CHECKED: _____

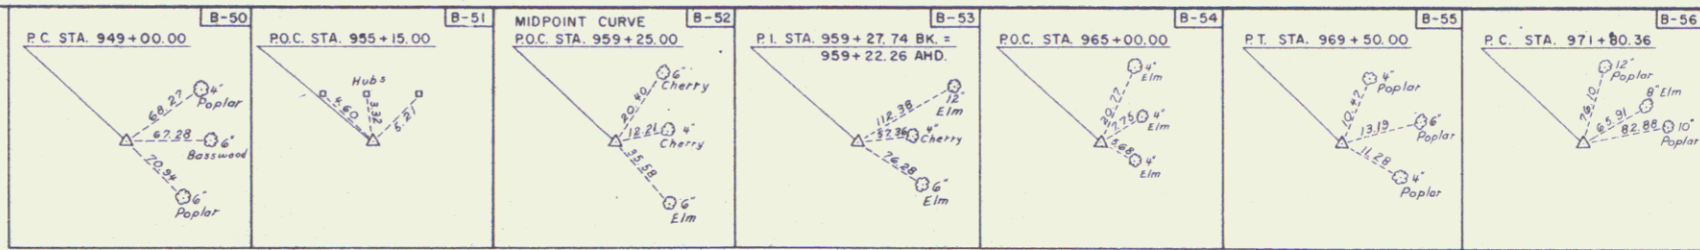

K-E PLATE 1, PLAN-PROFILE
KEUFEL & ESSEX CO.

WEST RUTLAND - RUTLAND
P. 020-1(11)
Sheet 68 of 72