
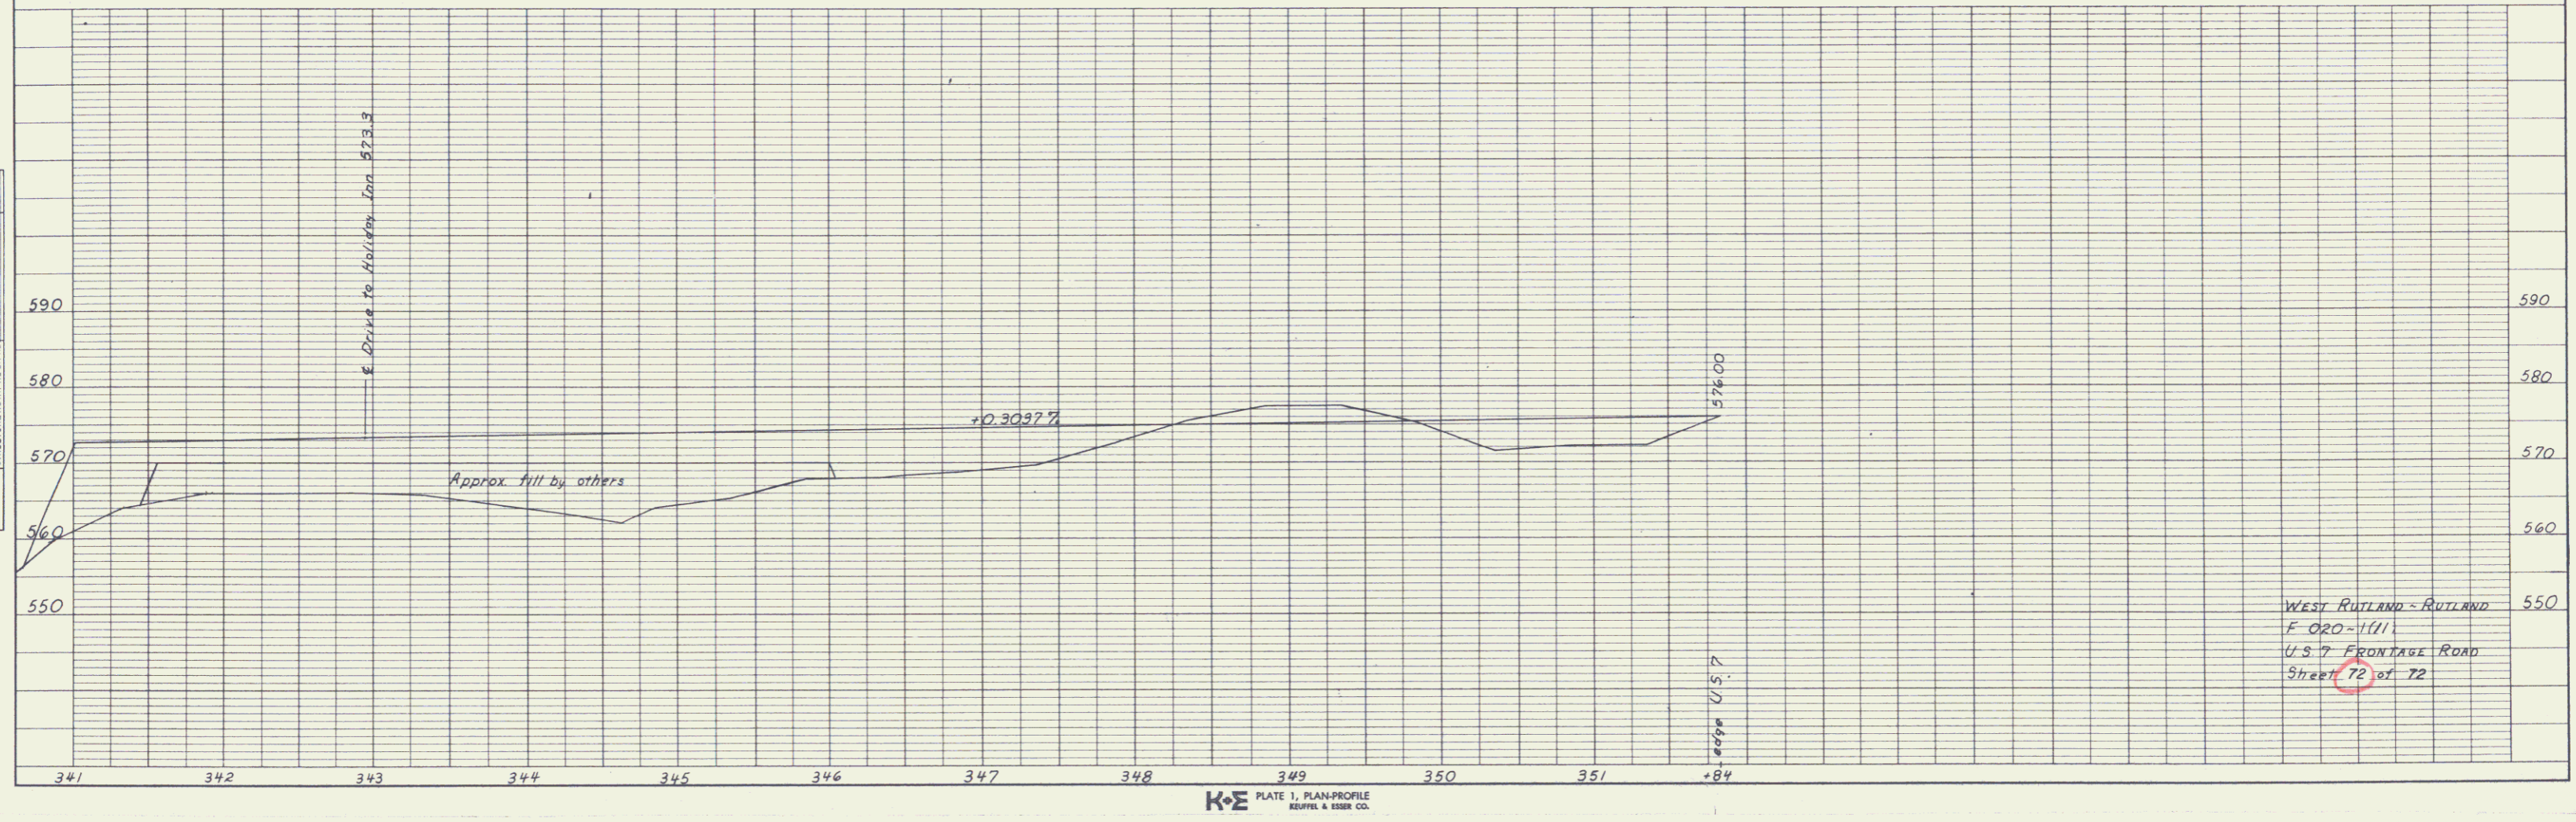
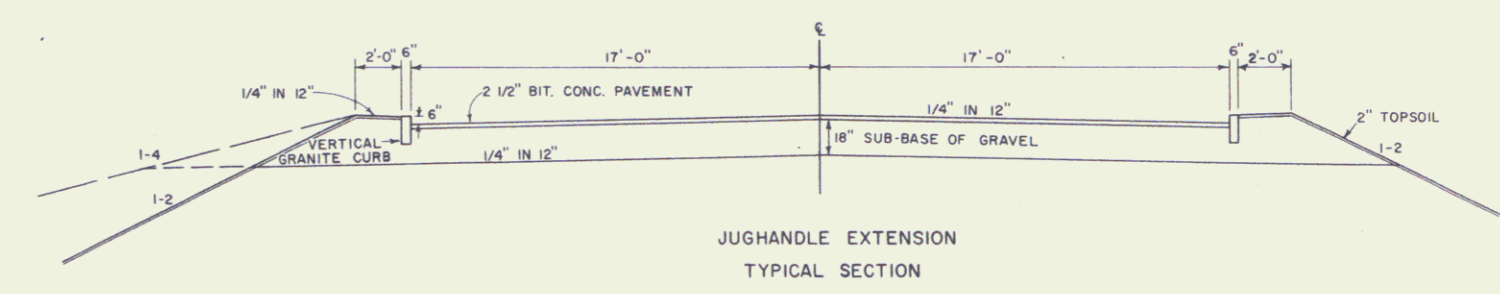


DATE	
BY	
DESIGNED	
CHECKED	
IN CHARGE	
NO.	
PLAN	
NOTE BOOK	
NO.	

DATE	
BY	
DESIGNED	
CHECKED	
IN CHARGE	
NO.	
PROFILE	
NOTE BOOK	
NO.	

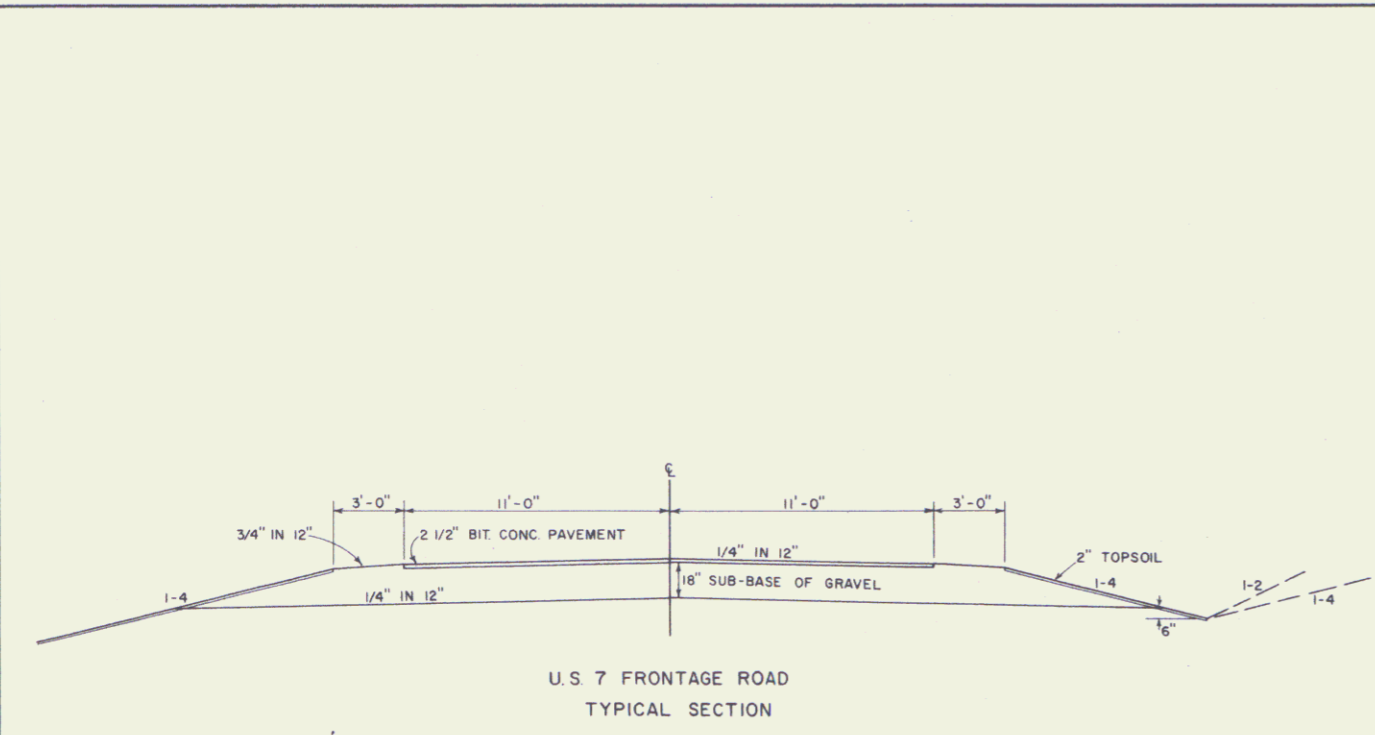

WEST RUTLAND - RUTLAND  
 F 020 - 1111  
 U.S. 7 FRONTAGE ROAD  
 Sheet 72 of 72