

INDEX OF SHEETS

SHEET NO.	TITLE PAGE
2	TYPICAL CROSS-SECTIONS OF IMPROVEMENT (BITUMINOUS CONCRETE PAVEMENT, ITEM 361-B MOD)
3-4	ITEM QUANTITY SHEETS
5-6	ITEM DRAINAGE SHEETS
7-10	EARTHWORK SHEETS
11	CHANNEL EARTHWORK SHEET, INCL. STRUCTURE AND STONE FILL
12-14	PLAN AND PROFILE SHEETS
15	GRADING PLAN, APPROACH, VT. RTE. NO. 125
16	CULVERT PLAN SHEET
17-18	CULVERT DETAIL SHEETS
19	CULVERT REINFORCING STEEL SCHEDULE
20	BRIDGE STANDARD SHEET SB 20-60, CONSTRUCTION JOINT DETAILS
21	BRIDGE STANDARD SHEET SB 21-56, EXPANSION JOINT DETAILS
22-31	PLAN AND PROFILE SHEETS
32	ROADWAY STANDARD SHEET B-1 BANKING TABLES
33	ROADWAY STANDARD SHEET B-5 TYPICAL SLOPE GRADING
34	ROADWAY STANDARD SHEET B-16 DIVISION ISLAND DESIGN
35	ROADWAY STANDARD SHEET C-1 CURBING
36	ROADWAY STANDARD SHEET D-1 PRECAST REINFORCED CONCRETE DROP INLETS
37	ROADWAY STANDARD SHEET D-2 CEMENT RUBBLE MASONRY
38	ROADWAY STANDARD SHEET D-3 GUTTERS
39	ROADWAY STANDARD SHEET D-4 FLUSHING BASINS
40	ROADWAY STANDARD SHEET E-1 BARRICADES, SIGNS AND LIGHTS (ROADWAY)
41	ROADWAY STANDARD SHEET G-3 THREE CABLE GUARD RAIL WITH STEEL POSTS
42	ROADWAY STANDARD SHEET G-4 MARKERS (WOOD AND STEEL)
43	ROADWAY STANDARD SHEET J-1 MARKERS (PROJECT AND BOUNDARY)
43-A	ROADWAY STANDARD SHEET A-61 DRILLING AND BLASTING OF SOLID ROCK SUBGRADE
44-49	CROSS SECTIONS
50-56	CHANNEL SECTIONS
57-182	CROSS SECTIONS (NOTE: SHEET NO. 106 HAS BEEN CANCELLED.)
43B-43-C	MACP 5-62 STA 1440+50
43D-43-E	MACP 5-62 STA 1557+00
39A	ROADWAY STANDARD SHEET D-8 REINFORCED CONCRETE DROP INLETS
39B	ROADWAY STANDARD SHEET D-9 REINFORCED CONCRETE DROP INLET TOPS WITH GRANITE CURB
39C	ROADWAY STANDARD SHEET D-11 DETAILS OF GRATES & COVERS FOR DROP INLETS
11A-E	FINAL EARTHWORK SHEETS
169A-B	T.R. 20 APPROACH SECTIONS
19	DRAINAGE SHEETS

STATE OF VERMONT
DEPARTMENT OF HIGHWAYS

PROPOSED IMPROVEMENT

FEDERAL AID PROJECT

TOWN OF MIDDLEBURY
COUNTY OF ADDISON
U.S. ROUTE 7
BRANDON - MIDDLEBURY ROAD

BEGINNING AT A POINT IN THE TOWN OF MIDDLEBURY 1.071 MILES NORTHERLY OF THE SALISBURY-MIDDLEBURY TOWN LINE AND EXTENDING NORTHERLY 3.182 MILES.


LENGTH OF PROJECT = 16,800.70 FEET = 3.182 MILES

DESIGNATION	ADT (1955)	ADT (1975)	DHV (1975)	D	T	V
ADT (1955)	2400					
ADT (1975)		3550				
DHV (1975)			720			
D				55 %		
T					8 %	
V						60 MPH


PROJECT NAME & NUMBER
MIDDLEBURY F 019-3 (11)

TYPE PAVEMENT
BIT. CONCRETE, 3"

AREA
50,000 S.Y.

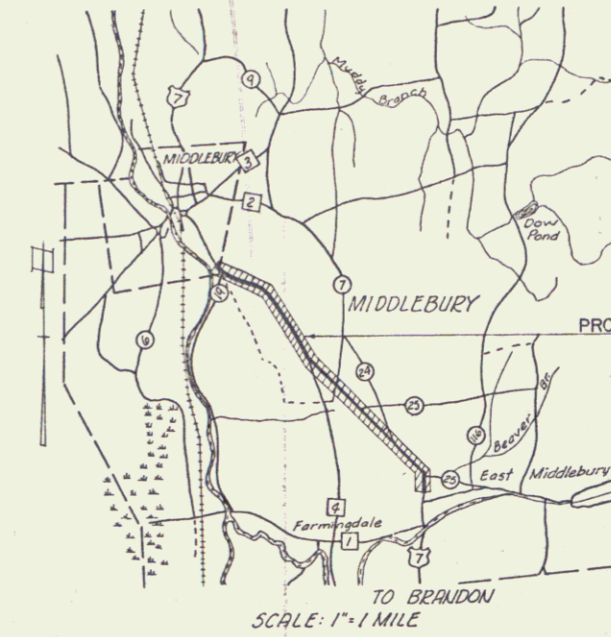

FED. ROAD DISTRICT	STATE	PROJECT NO.	YEAR	SHEET NO.	TOTAL SHEETS
1	VT	F019-3(11)	WAR	1	182

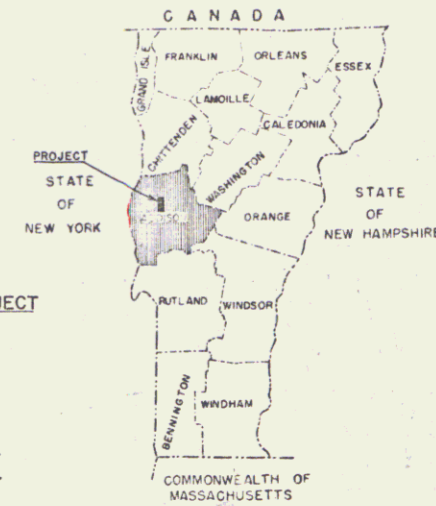


MATERIALS

SUB-BASE OF GRAVEL - FOSTER PIT, EAST MIDDLEBURY, VT.
SUB-BASE OF SAND - JOHNSON PIT, EAST MIDDLEBURY, VT.
GRAVEL SHOULDERS - CHAMPLAIN PIT, MIDDLEBURY, VT.
PEA STONE, CONCRETE CLASS "B" - J. R. CARRARA & SONS, EAST MIDDLEBURY, VT.
GRITS - VERMONT MARBLE CO. FLORENCE, VT.
REFINED TAR - WITCO CHEMICAL CO. WORCESTER, MASS.
ASPHALT - MOBIL OIL CO. PROVIDENCE, R. I.
CRUSHED GRAVEL PLANT MIXED BASE COURSE & BIT. CONCRETE - L. M. PIKE, FLORENCE, VT.
REINFORCING STEEL - REPUBLIC STEEL CORP., SO. BOSTON, MASS.
A.C.C.G.M.P., C.G.M.P.PARCH, C.G.M.P.PE & ALUM. UNDERDRAIN - NORTHEASTERN CULVERT CORP., WESTMINSTER, VT.

R.C.P., R.C.D.I., 3 CABLE GUARD RAIL & ANCHORS, MARKER POSTS & GUIDE POSTS - S.T. GRISWOLD, CO. WILLISTON, VT.
GRATES FOR DROP INLETS - VERMONT STRUCTURAL STEEL CO. BURLINGTON, VT.

CONTRACTOR - OLSON CONST. CORP., MONTPELIER, VT.
RESIDENT ENGINEER - ROBERT W. BUTLER
ASST. RES. ENG. - L.B. FRASER
INSPECTOR - R.E. BRADY
RECORD PLANS - L.B. FRASER
CONTRACT DATED DEC. 4, 1962
STARTED APRIL 15, 1963
COMPLETED AUG. 14, 1964
ACCEPTED AUG. 14, 1964

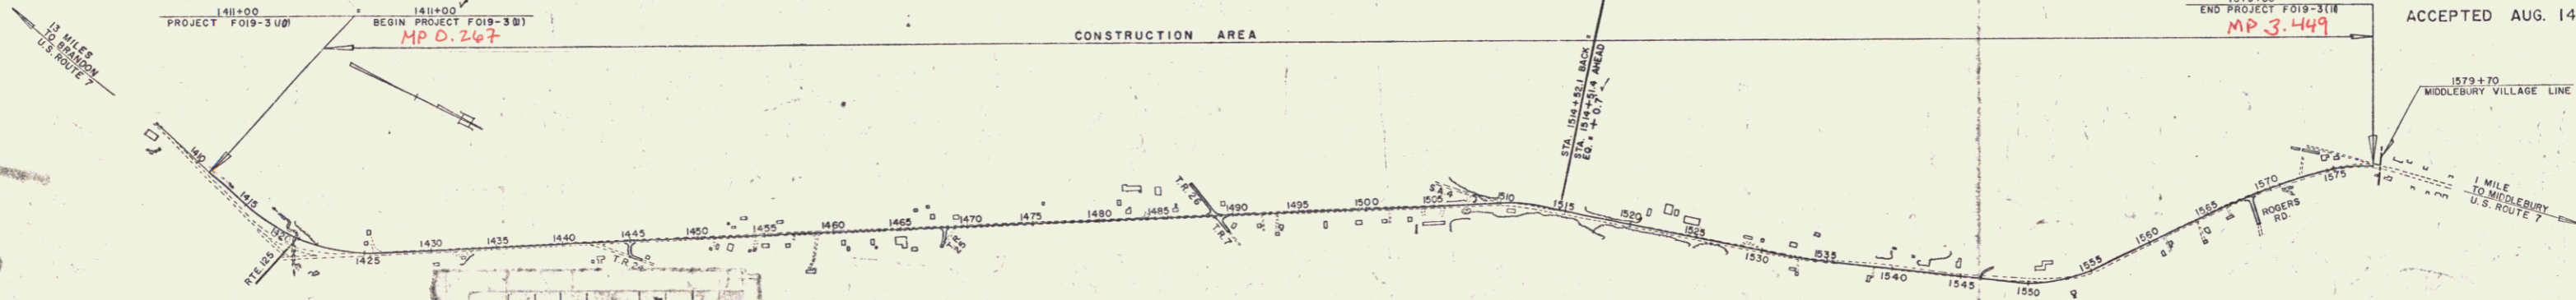

CONVENTIONAL SIGNS

ROW FENCE	ROW
COUNTY LINE	
TOWN LINE	
FENCE LINE	
STONE WALL	
UNFENCED PROPERTY	
GUARD RAIL	
TRAVELED WAY	
RAILROAD	
RETAINING WALL	
CENTER LINE	
SURVEY LINE	
CULVERT	
DROP INLET	
TROLLEY POLE	
POWER POLE	
TELEPHONE POLE	
TREES	
HEDGE	

MIDDLEBURY, VT.
CONTRACTOR - OLSON CONST. CORP., MONTPELIER, VT.
RECORD PLANS - L.B. FRASER
COMPLETED AUGUST 14, 1964

PROJECT MIDDLEBURY
BRIDGE F 019-3 (11)
TYPE BITUMINOUS CONCRETE PAVEMENT
CONTRACTOR OLSON CONST. CORP., MONTPELIER, VT.

Location Beginning at a point in the Town of Middlebury 1.071 miles northerly of the Salisbury-Middlebury Town Line and extending northerly 3.182 miles.

SCALES

GENERAL	1" = 60'
VERTICAL	AS NOTED
HORIZONTAL	1" = 50'
VERTICAL	1" = 10'
SECTIONS	1" = 5'

APPROVED DATE 8-29-59	APPROVED DATE 8-14-59	APPROVED DATE 8-14-59	APPROVED DATE 1-9-59	APPROVED DATE 1-16-1957	APPROVED DATE May 16, 1962
--------------------------	--------------------------	--------------------------	-------------------------	----------------------------	-------------------------------

THESE PLANS ARE SUBJECT TO SUCH REVISIONS AS MAY BE REQUIRED BY THE BUREAU OF PUBLIC ROADS OR THE COMMISSIONER OF HIGHWAYS.
CONSTRUCTION IS TO BE CARRIED ON IN ACCORDANCE WITH THE PLANS AND THE STANDARD SPECIFICATIONS FOR HIGHWAY AND BRIDGE CONSTRUCTION OF JANUARY 1956 SUBMITTED TO THE BUREAU OF PUBLIC ROADS AS APPROVED JULY 5, 1956, INCLUDING ALL SUBSEQUENT APPROVED REVISIONS AND SUCH REVISED SPECIFICATIONS AND SPECIAL PROVISIONS AS ARE SUBMITTED WITH THE PLANS.

Pin # 76D070

DEPARTMENT OF COMMERCE BUREAU OF PUBLIC ROADS
APPROVED
DIVISION ENGINEER
DATE
PROJECT MIDDLEBURY NO. F 019-3(11)
SHEET 1 OF 182 SHEETS

APR 25 1977