


PLAN
 DRAWN BY: [Signature]
 CHECKED BY: [Signature]
 DATE: 12/77

PROFILE
 DRAWN BY: [Signature]
 CHECKED BY: [Signature]
 DATE: 12/77

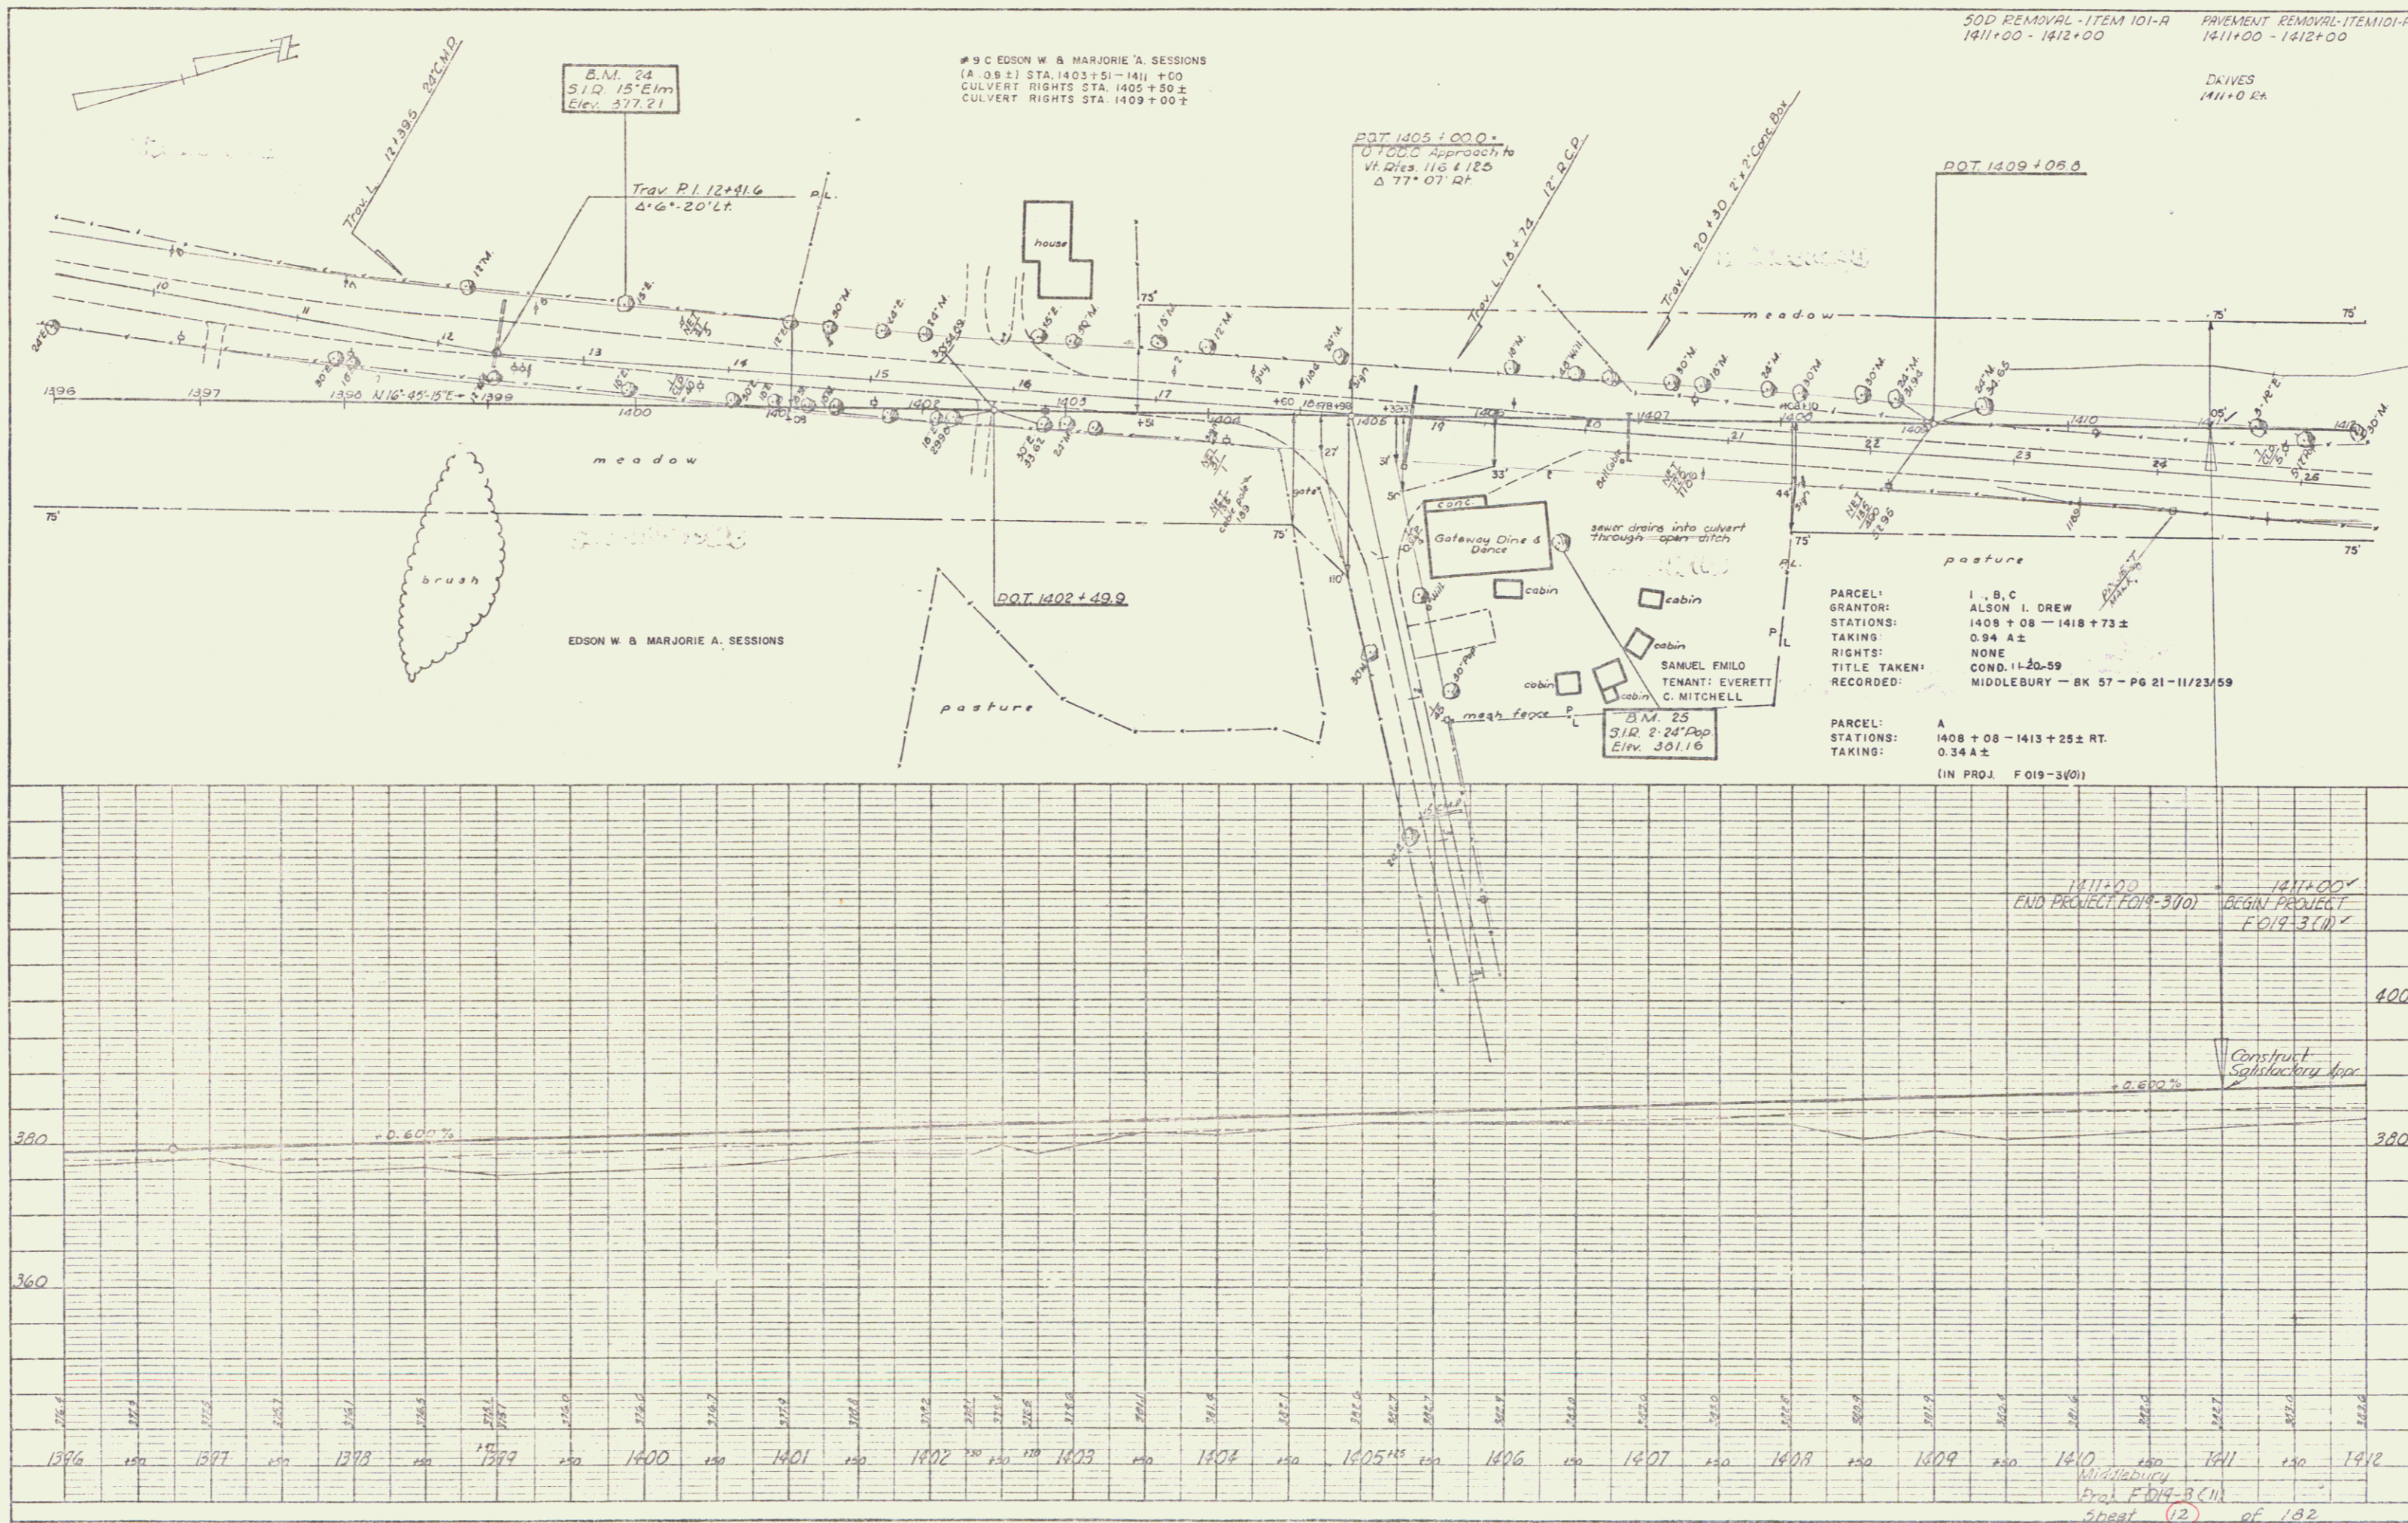

#9 CEDSON W & MARJORIE A. SESSIONS
 (A. 0.9 ±) STA. 1403+51 - 1411+00
 CULVERT RIGHTS STA. 1405+50 ±
 CULVERT RIGHTS STA. 1409+00 ±

50D REMOVAL - ITEM 101-R
 1411+00 - 1412+00
 PAVEMENT REMOVAL - ITEM 101-R
 1411+00 - 1412+00

DRIVES
 1411+00 EX

PARCEL:
 GRANTOR: I. B. C
 ALSON L. DREW
 STATIONS: 1408+08 - 1418+73 ±
 TAKING: 0.94 A ±
 RIGHTS: NONE
 TITLE TAKEN: COND. 11-20-59
 RECORDED: MIDDLEBURY - BK 57 - PG 21 - 11/23/59

PARCEL:
 STATIONS: A
 1408+08 - 1413+25 ± RT.
 TAKING: 0.34 A ±
 (IN PROJ. F 019-3(01))

1411+00
 END PROJECT F019-3(01)
 1411+00
 BEGIN PROJECT F019-3(01)

Construct Substructure for

PLATE 11 - PLAN-PROFILE - 11' X 17' - 1/2" SCALE
 MIDDLEBURY COLLEGE, VTS. VT.
 11' X 17' - 1/2" SCALE

APR 25 1977 2