
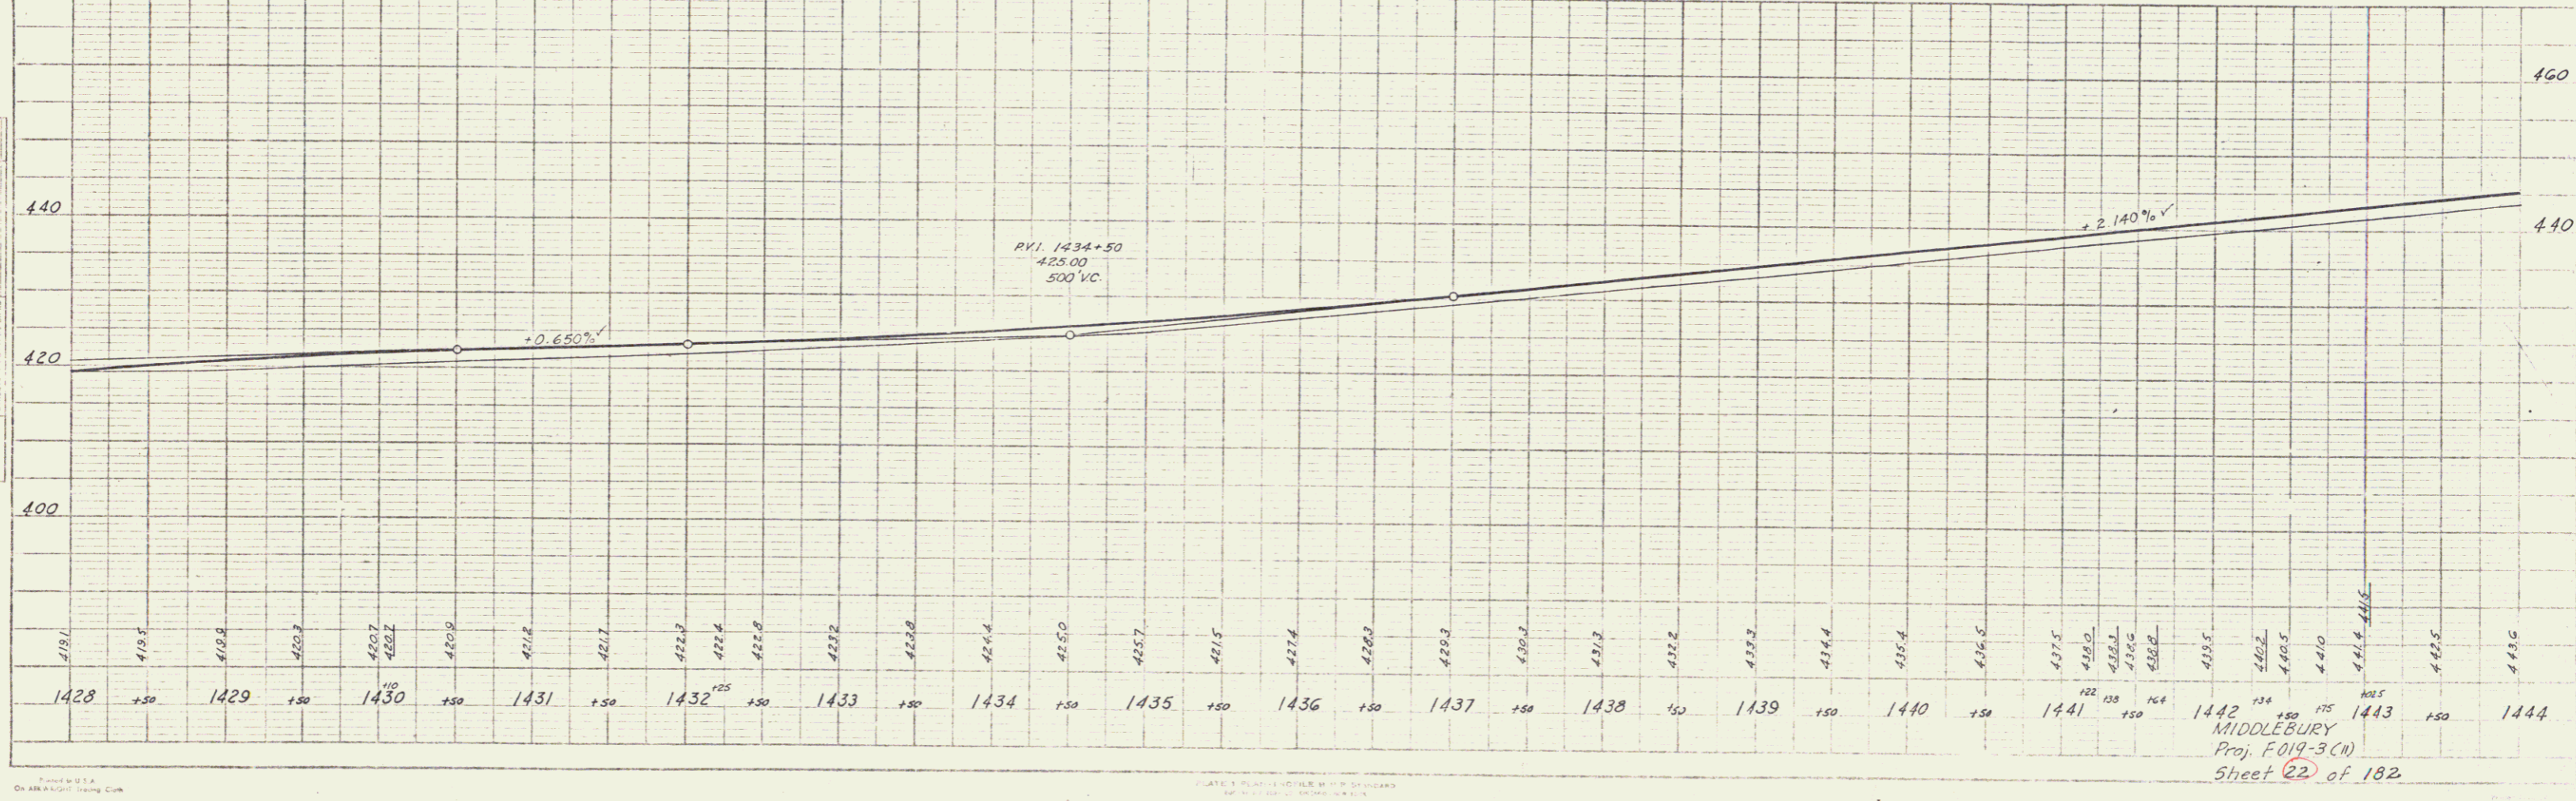


PLAN
 DRAWN BY: [Name]
 CHECKED BY: [Name]
 DATE: [Date]

PROFILE
 SCALE: [Scale]
 DATE: [Date]

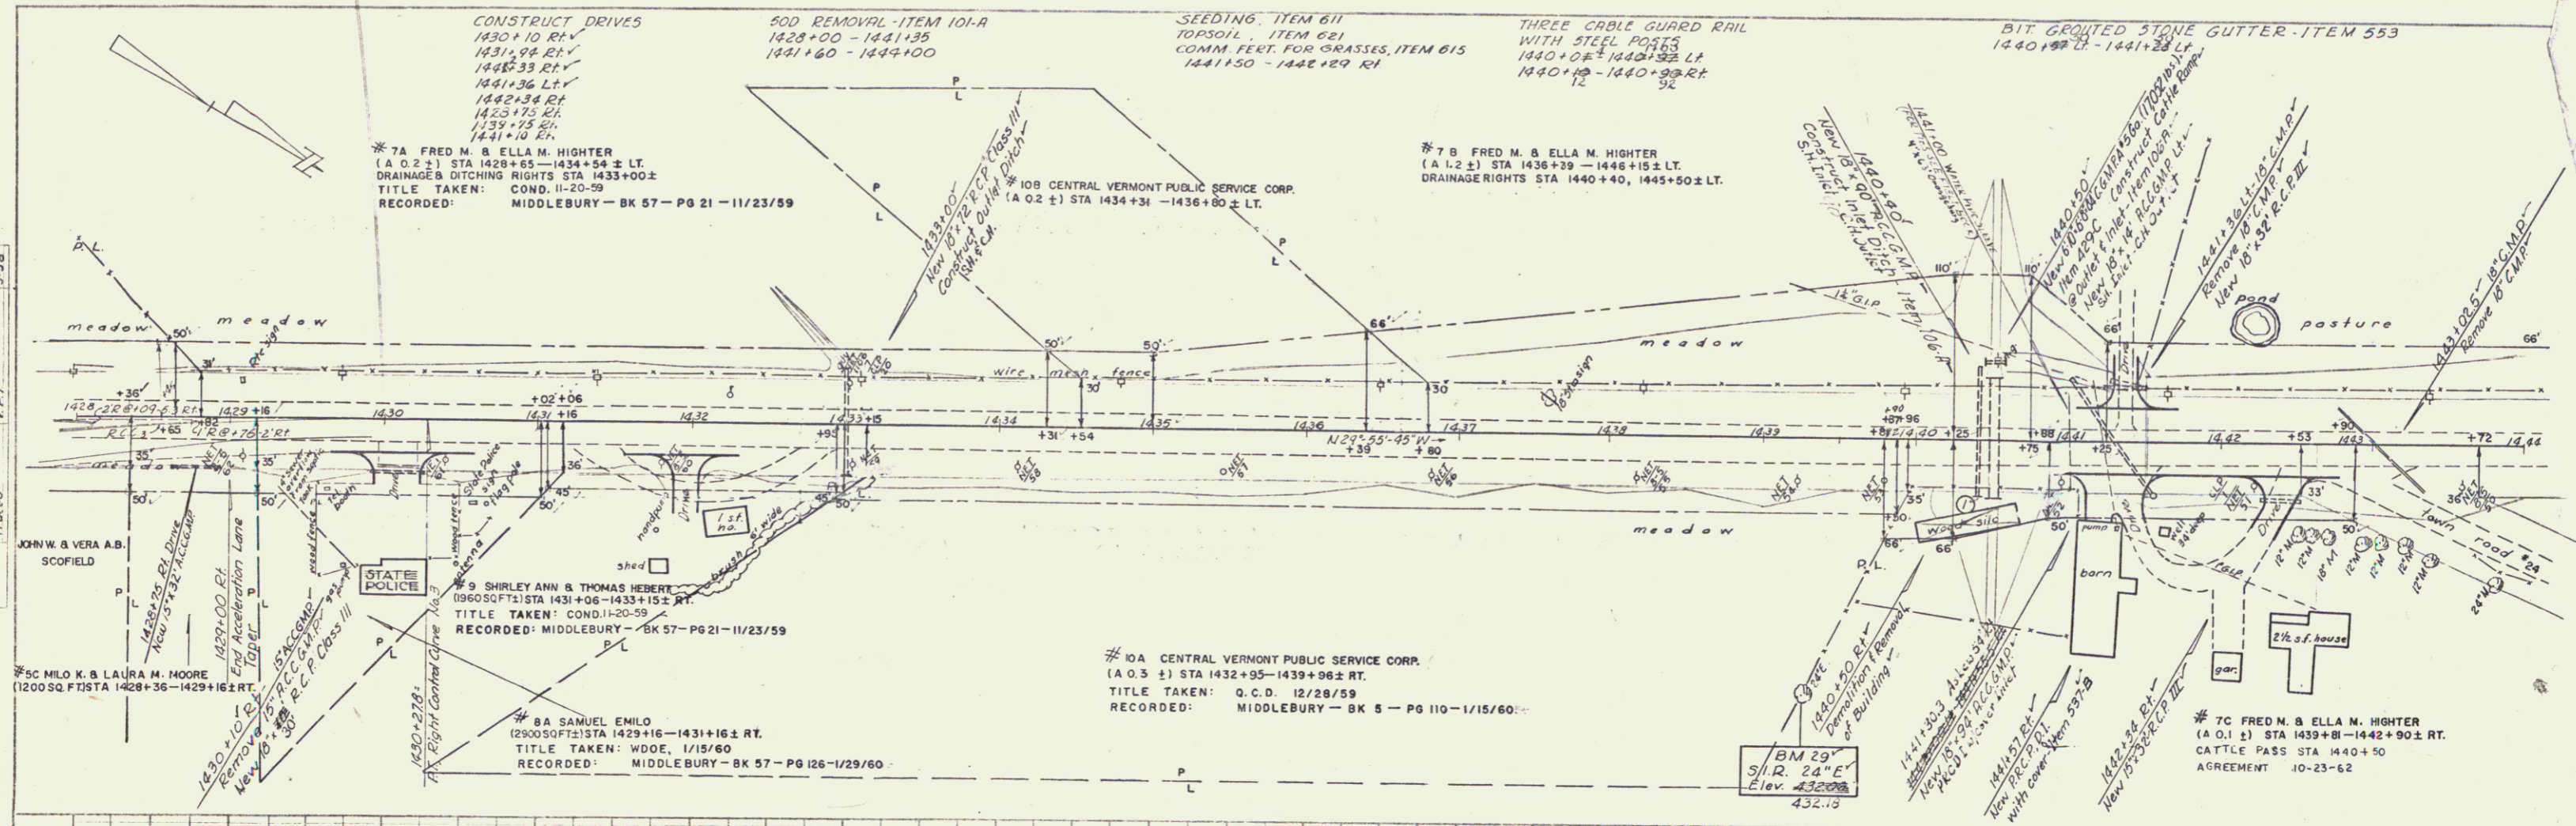

MIDDLEBURY
 Proj. F019-3(1)
 Sheet 22 of 182

APR 25 1977