
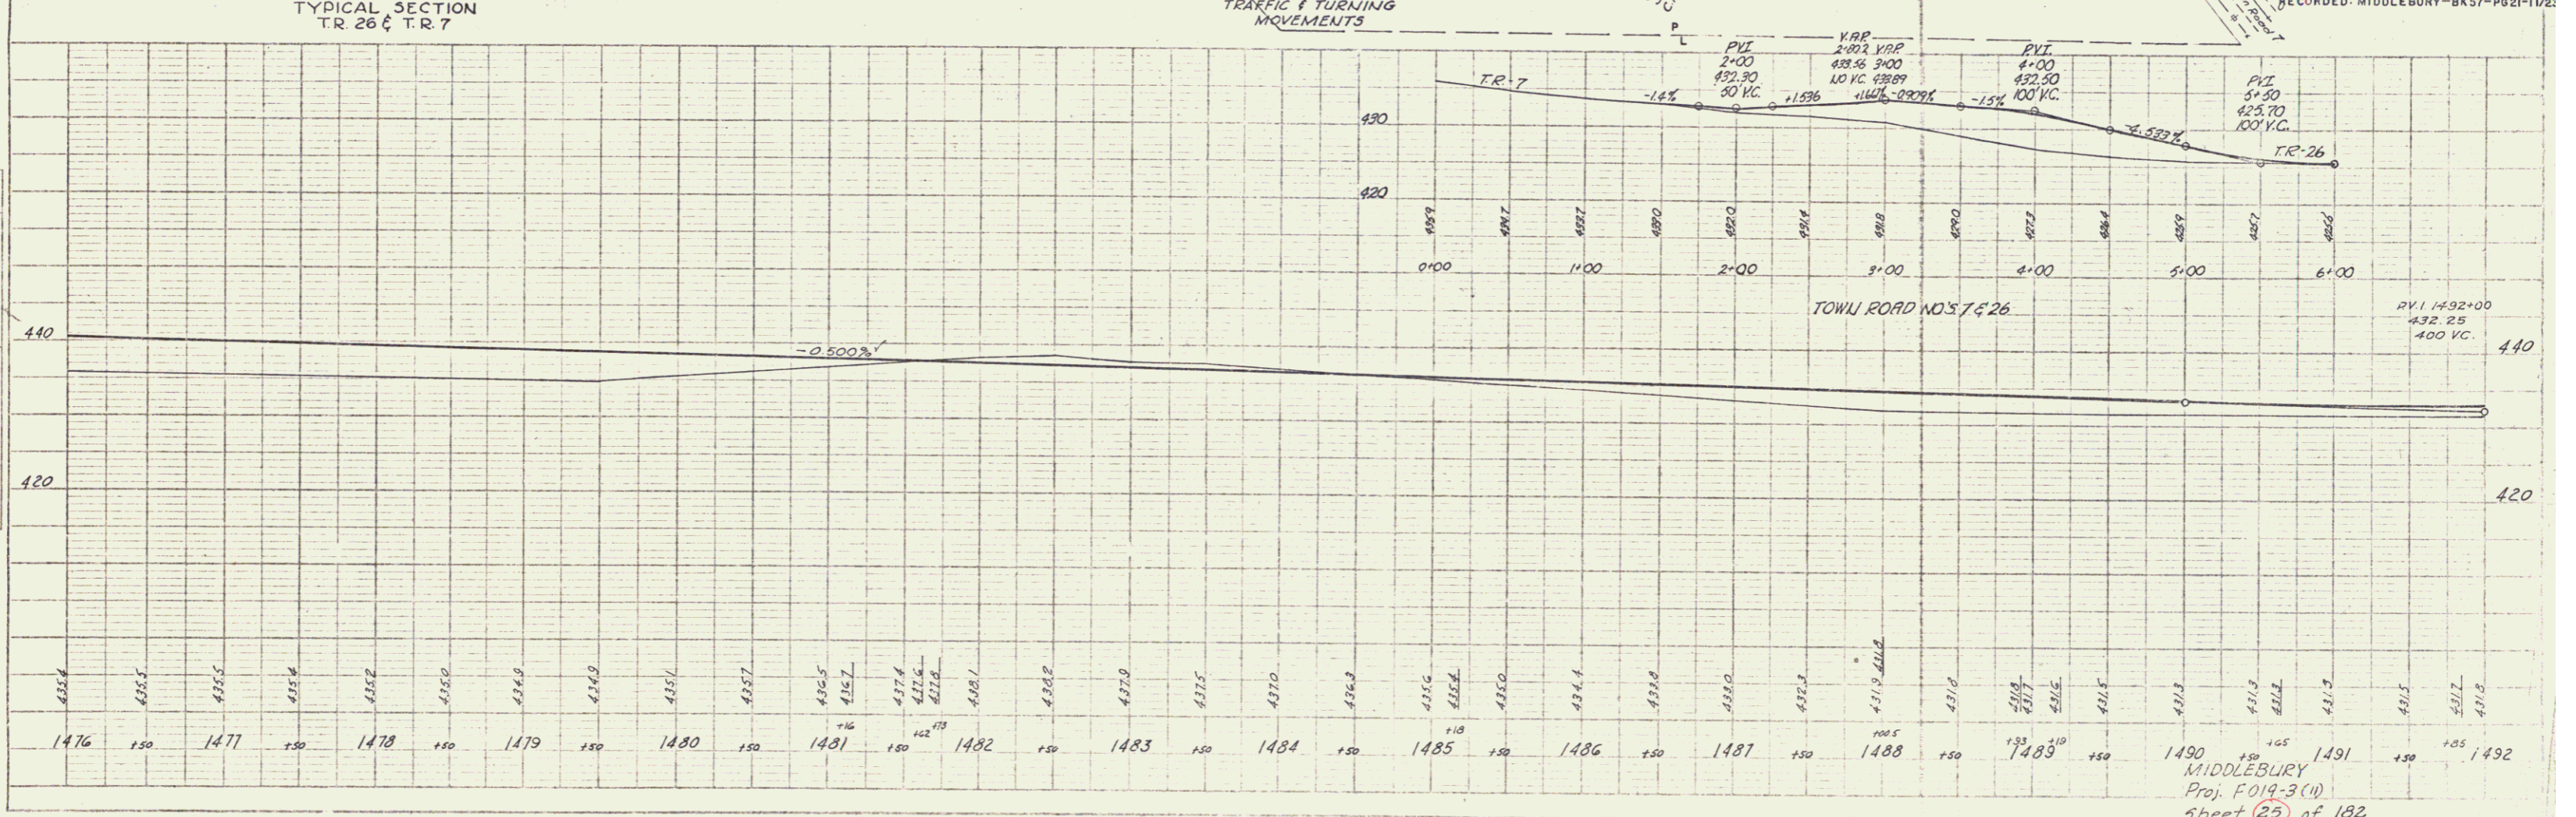


DATE	5/2/78
BY	V.P.T.
CHECKED	
APPROVED	
DESIGNED	
PLANNED	
FILED	

PROJECT	ROADWAY IMPROVEMENTS
DATE	5/2/78
BY	V.P.T.
CHECKED	
APPROVED	
DESIGNED	
PLANNED	
FILED	

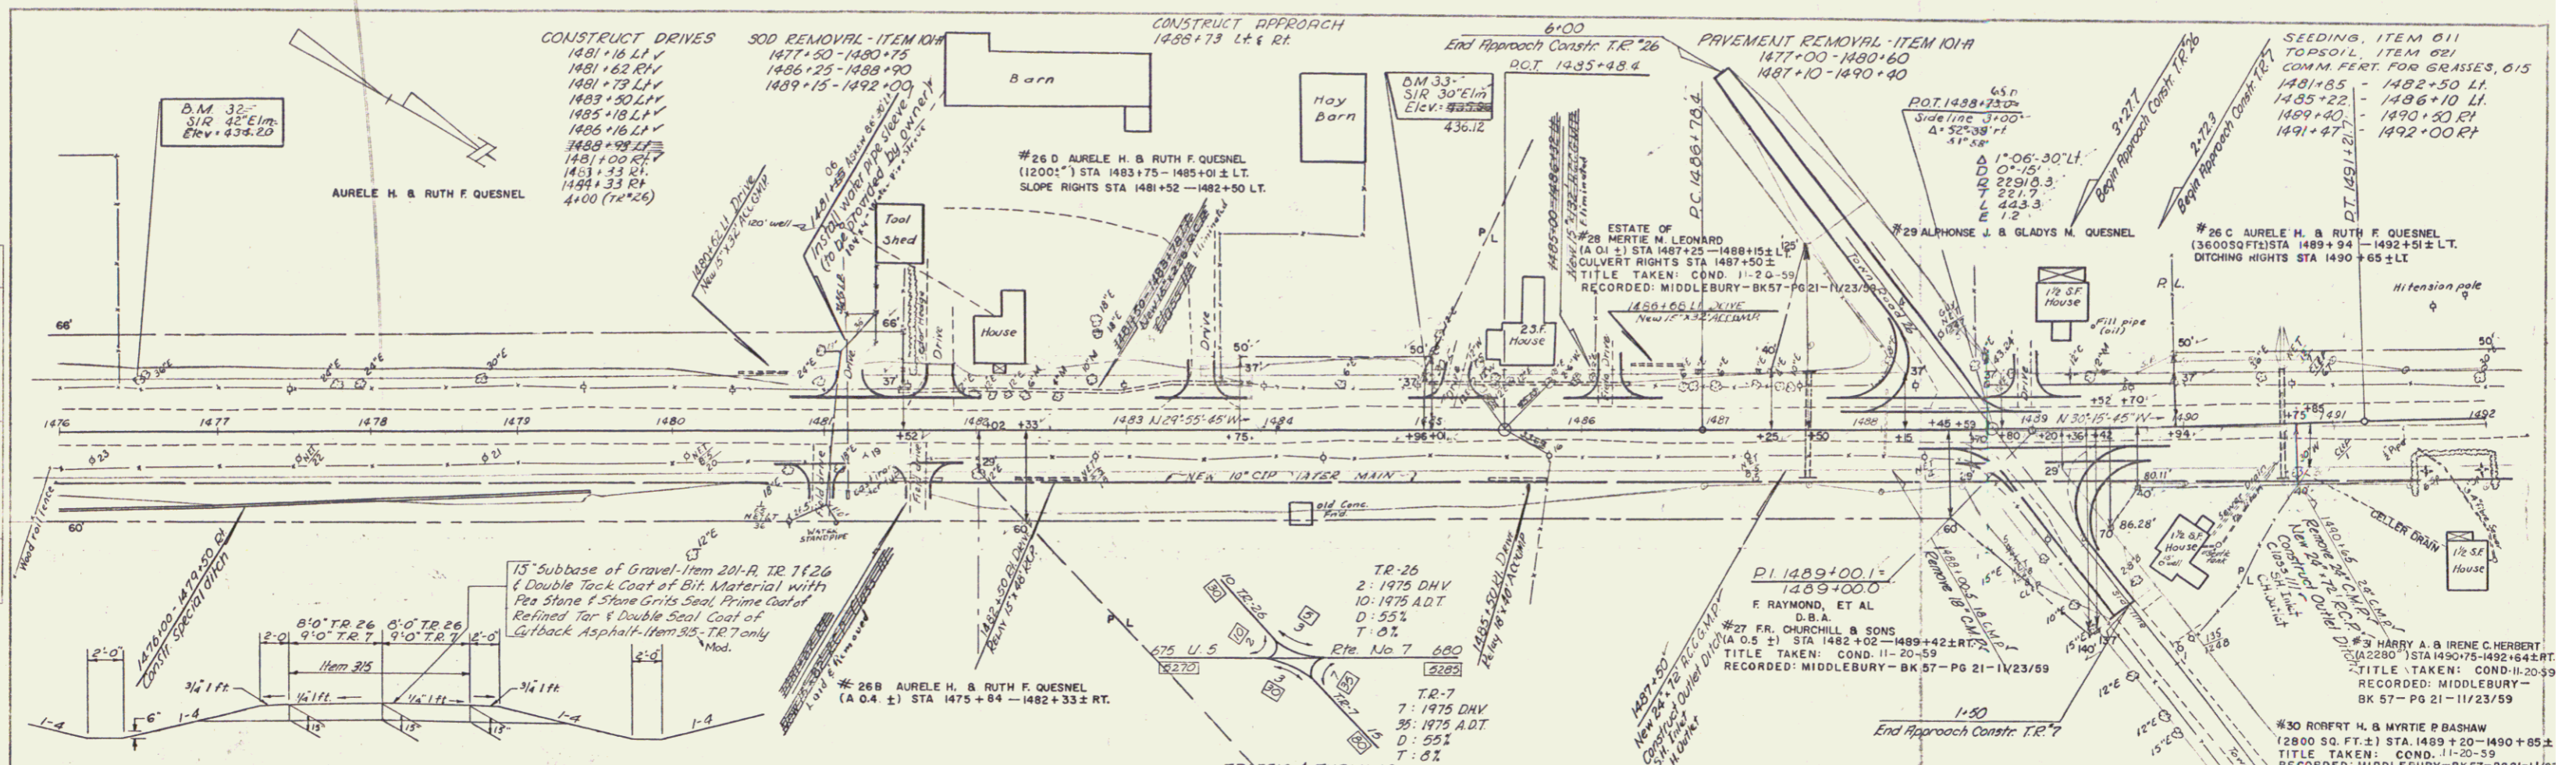

MIDDLEBURY
Proj. F019-3(11)
Sheet 25 of 182
9
APR 25 1978