

INDEX OF SHEETS


1	TITLE PAGE	
2	TYPICAL	
3	GUARD RAIL TYPICAL	
4	QUANTITY-TYPICAL	
5-6	RIGHT OF WAY DETAIL SHEETS	
7	PLAN-PROFILE	
8	BLANK	
9-22	BRIDGE SHEETS	
23	BLANK	
24	B-1 BANKING TABLES	5-9-74 R
25	E-3 BRIDGE CONSTRUCTION SIGNS	6-7-77 R
26	E-7 DELINATION AND BARRICADES	8-19-75 R
27	E-7A BREAKAWAY BARRICADES	8-8-77 R
28	G-1 STEEL BEAM GUARD RAIL W/WOOD POSTS	1-17-78 R
29	G-14 B.C.T FOR STEEL BEAM GUARD RAIL	4-21-77 R
30	J-1 BOUNDARY MARKERS	12-6-71
31	SB-R6-76 A	1-8-76
32	SCB-D1-75	4-3-78 R
33	SCB-D4-76 B	1-8-76 R
34	SCB-D6-73 A-E	4-3-78 R
35	SCB-D7-71 C-E	12-15-76 R
36	SCB-D8-71 A	6-1-77 R
37	SCB-D9-77 A	1-27-75 R
38	BLANK	
39-40	CROSS SECTIONS	

STATE OF VERMONT
AGENCY OF TRANSPORTATION



PROPOSED IMPROVEMENT
TOWN OF BARTON
COUNTY OF ORLEANS

U.S. ROUTE 5

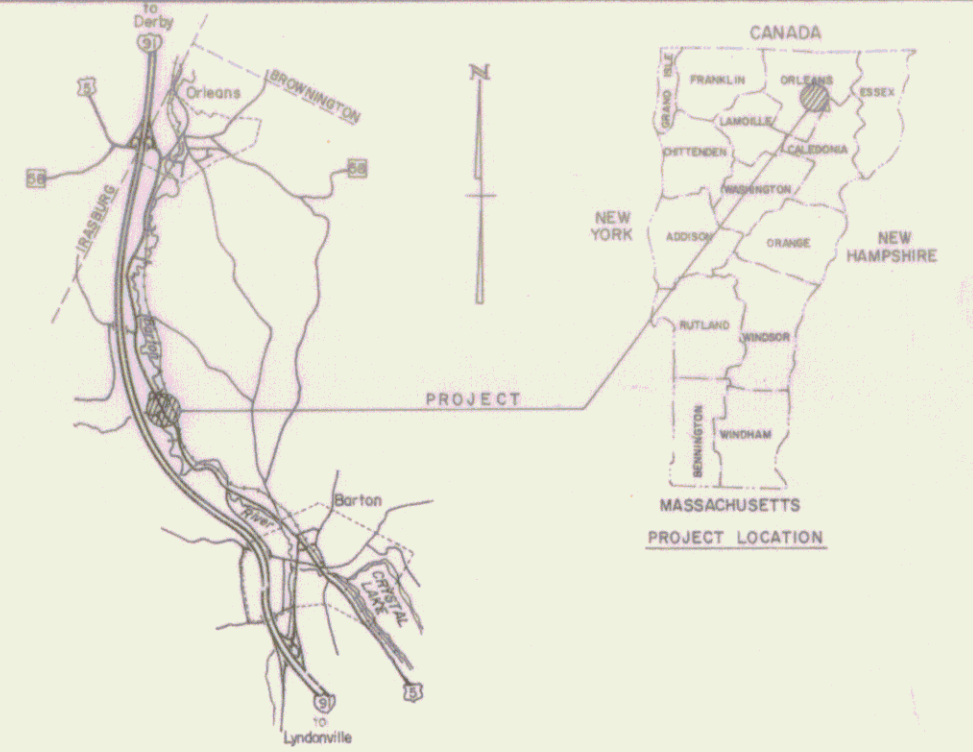

RECORD PLANS-MATERIAL SUPPLIERS

CONTRACTOR-CONTRACTORS CRANE SERVICE, MORRISVILLE, VT.
 CONTRACT DATED-14 JULY 1978 CONSTRUCTION BEGAN-20 JULY 1978
 CONSTRUCTION SUSPENDED-1 DECEMBER 1978 RESUMED-23 MAY 1979
 CONSTRUCTION COMPLETED-29 JUNE 1979 ACCEPTED-1 JULY 1979
 RESIDENT ENGINEER-DAVID H. SARGENT RECORD PLANS-GEORGE J. ABRAHAM
 SUBBASE OF GRAVEL-CALKINS PIT, COVENTRY, VT. & THOMPSON PIT, GLOVER, VT.
 PLANT MIXED BASE COURSE, BITUMINOUS CONCRETE PAVEMENT-L.M. PIKE, COVENTRY, VT.
 CONCRETE-CALKINS REDIMX, COVENTRY, VT. STRUCTURAL STEEL-VERMONT STRUCTURAL STEEL CORP., BURLINGTON, VT.
 REINFORCING STEEL-WATER REPELLENT-K-ROSS BUILDING SUPPLY CENTER, LEBANON, N.H.
 COMB-LANE METAL PRODUCTS CO., INC., BALLISTON, N.Y.
 BRIDGE RAILING, GUARD RAIL, BREAKAWAY CABLE, EROSION MATTING-LAFAYETTE-SHELDON INC., ESSEX JCT, VT.
 BEARING DEVICE ASSEMBLY-VERMONT STRUCTURAL STEEL CORP., BURLINGTON, VT.
 GRANULAR BACKFILL FOR STRUCTURES-CALKINS PIT, COVENTRY, VT.


BEGINNING 1.790 MILES NORTH OF THE BARTON VILLAGE LINE AND EXTENDING NORTHERLY 0.132 MILES

LENGTH OF ROADWAY	515	FEET = 0.17	MILES
LENGTH OF BRIDGE	95	FEET = 0.016	MILES
LENGTH OF PROJECT	700	FEET = 0.133	MILES

1973	ADT	1900
1978	DHV	275
1983	ADT	2225
1983	DHV	300
	D	51%
	T	7%


NOTE: ANY FURTHER INFORMATION CONCERNING
 PRICES, QUANTITIES, AMOUNTS OR OTHER DETAILS
 RELATIVE TO THIS PROJECT MAY BE FOUND IN
 DRAWING THE FIELD BOOKS OR THE ESTIMATE
 FILE.

NOTE: ANY FURTHER INFORMATION CONCERNING
 PRICES, QUANTITIES, AMOUNTS OR OTHER DETAILS
 RELATIVE TO THIS PROJECT MAY BE FOUND IN
 DRAWING THE FIELD BOOKS OR THE ESTIMATE
 FILE.

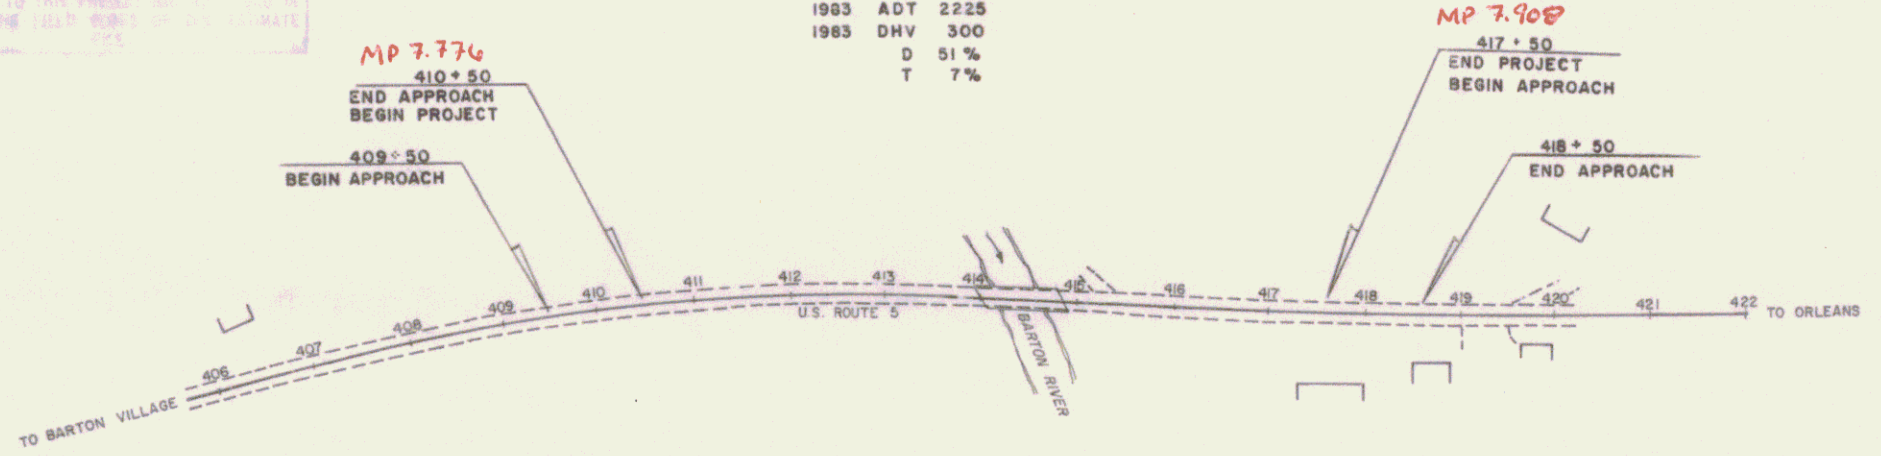

- CONVENTIONAL SIGNS
- COUNTY LINE
 - TOWN LINE
 - LIMITS OF ACCESS
 - POINT OF ACCESS
 - FENCE LINE
 - STONE WALL
 - TRAVELED WAY
 - GUARD RAIL
 - RAILROAD
 - SURVEY LINE
 - CULVERT
 - POWER POLE
 - TELEPHONE POLE
 - TREES
 - CONTROL OF ACCESS
 - PROPERTY LINE
 - ROW TAKING LINE
 - SLOPE RIGHTS
 - TOP OF CUT
 - TOE OF SLOPE

DATUM
 VERTICAL
 HORIZONTAL

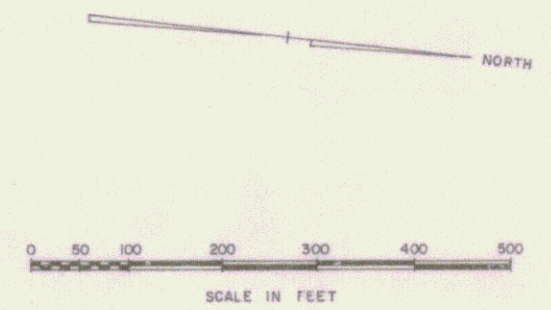

These plans are subject to such engineering changes as may be required by the Federal Highway Administration or the Director of Engineering and Construction.
 Construction is to be carried on in accordance with these plans and the Standard Specifications for Highway and Bridge Construction dated March, 1976, as approved by the Federal Highway Administration on October 27, 1976, for use on this project, including all subsequent revisions and such revised specifications and special provisions as are incorporated in these plans.

Pin # 76E073
 Date 6/29/1979

SUBMITTED BY ORDER OF THE STATE TRANSPORTATION BOARD
 APPROVED: *Robert J. Jones* DATE: June 79
 DIRECTOR OF ENGINEERING AND CONSTRUCTION

DEPARTMENT OF TRANSPORTATION
 FEDERAL HIGHWAY ADMINISTRATION

APPROVED: _____ DATE: _____
 DIVISION ADMINISTRATOR

PROJECT TSP NO. 015 (17)
 BARTON
 SHEET 1 OF 40 SHEETS