

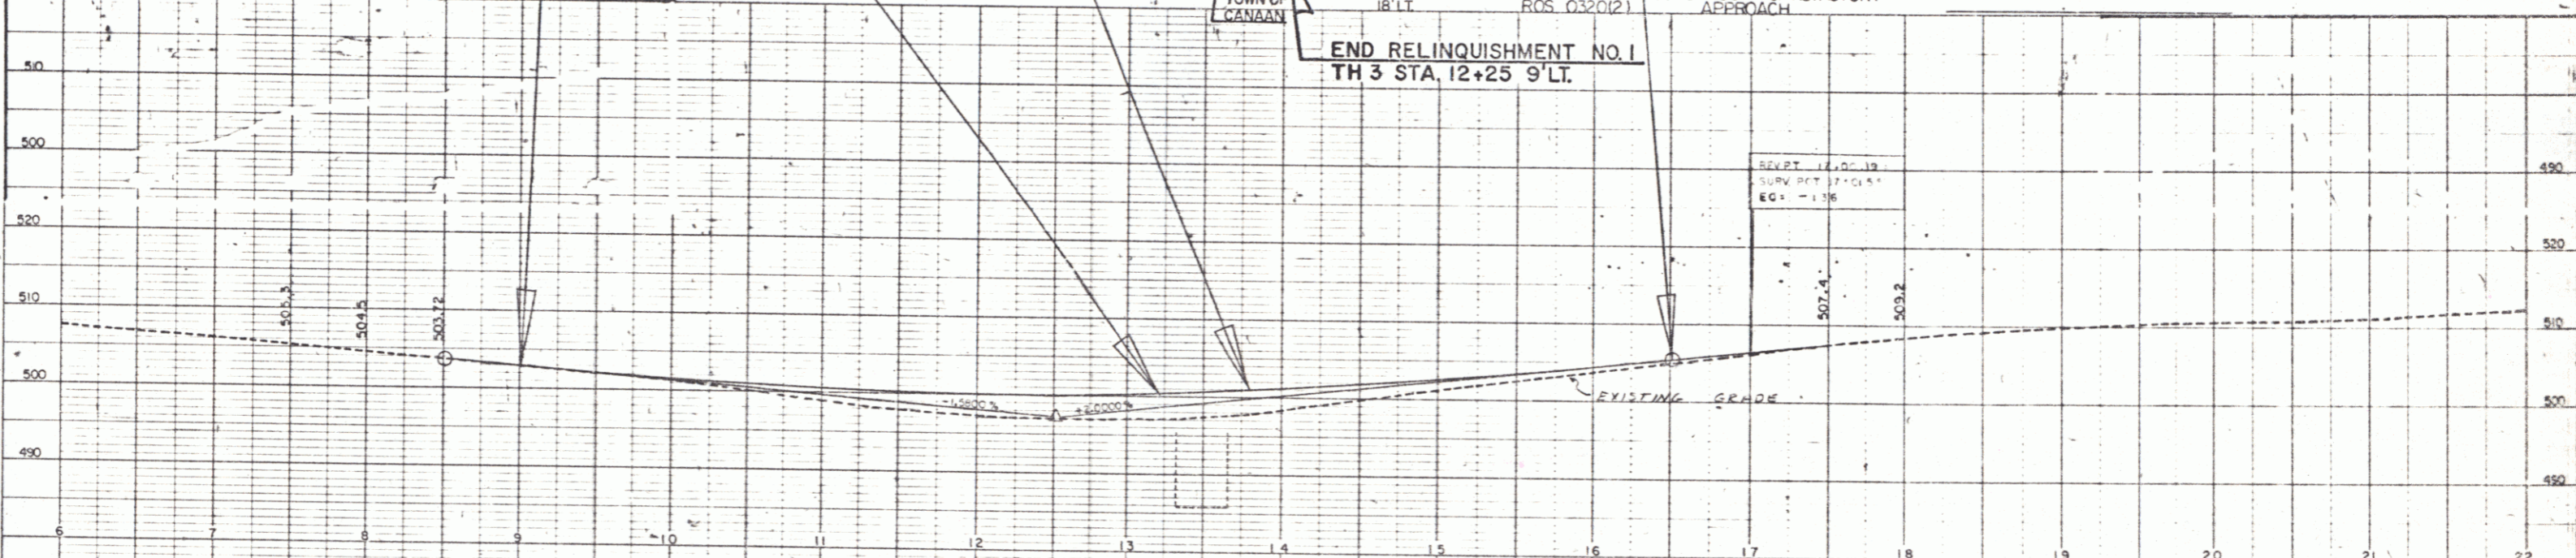


PLAN	
DESIGNED BY	CLARK
CHECKED BY	TOOLAN
DATE	1-80
SCALE	AS SHOWN

PROFILE	
DESIGNED BY	CLARK
CHECKED BY	TOOLAN
DATE	1-80
SCALE	AS SHOWN

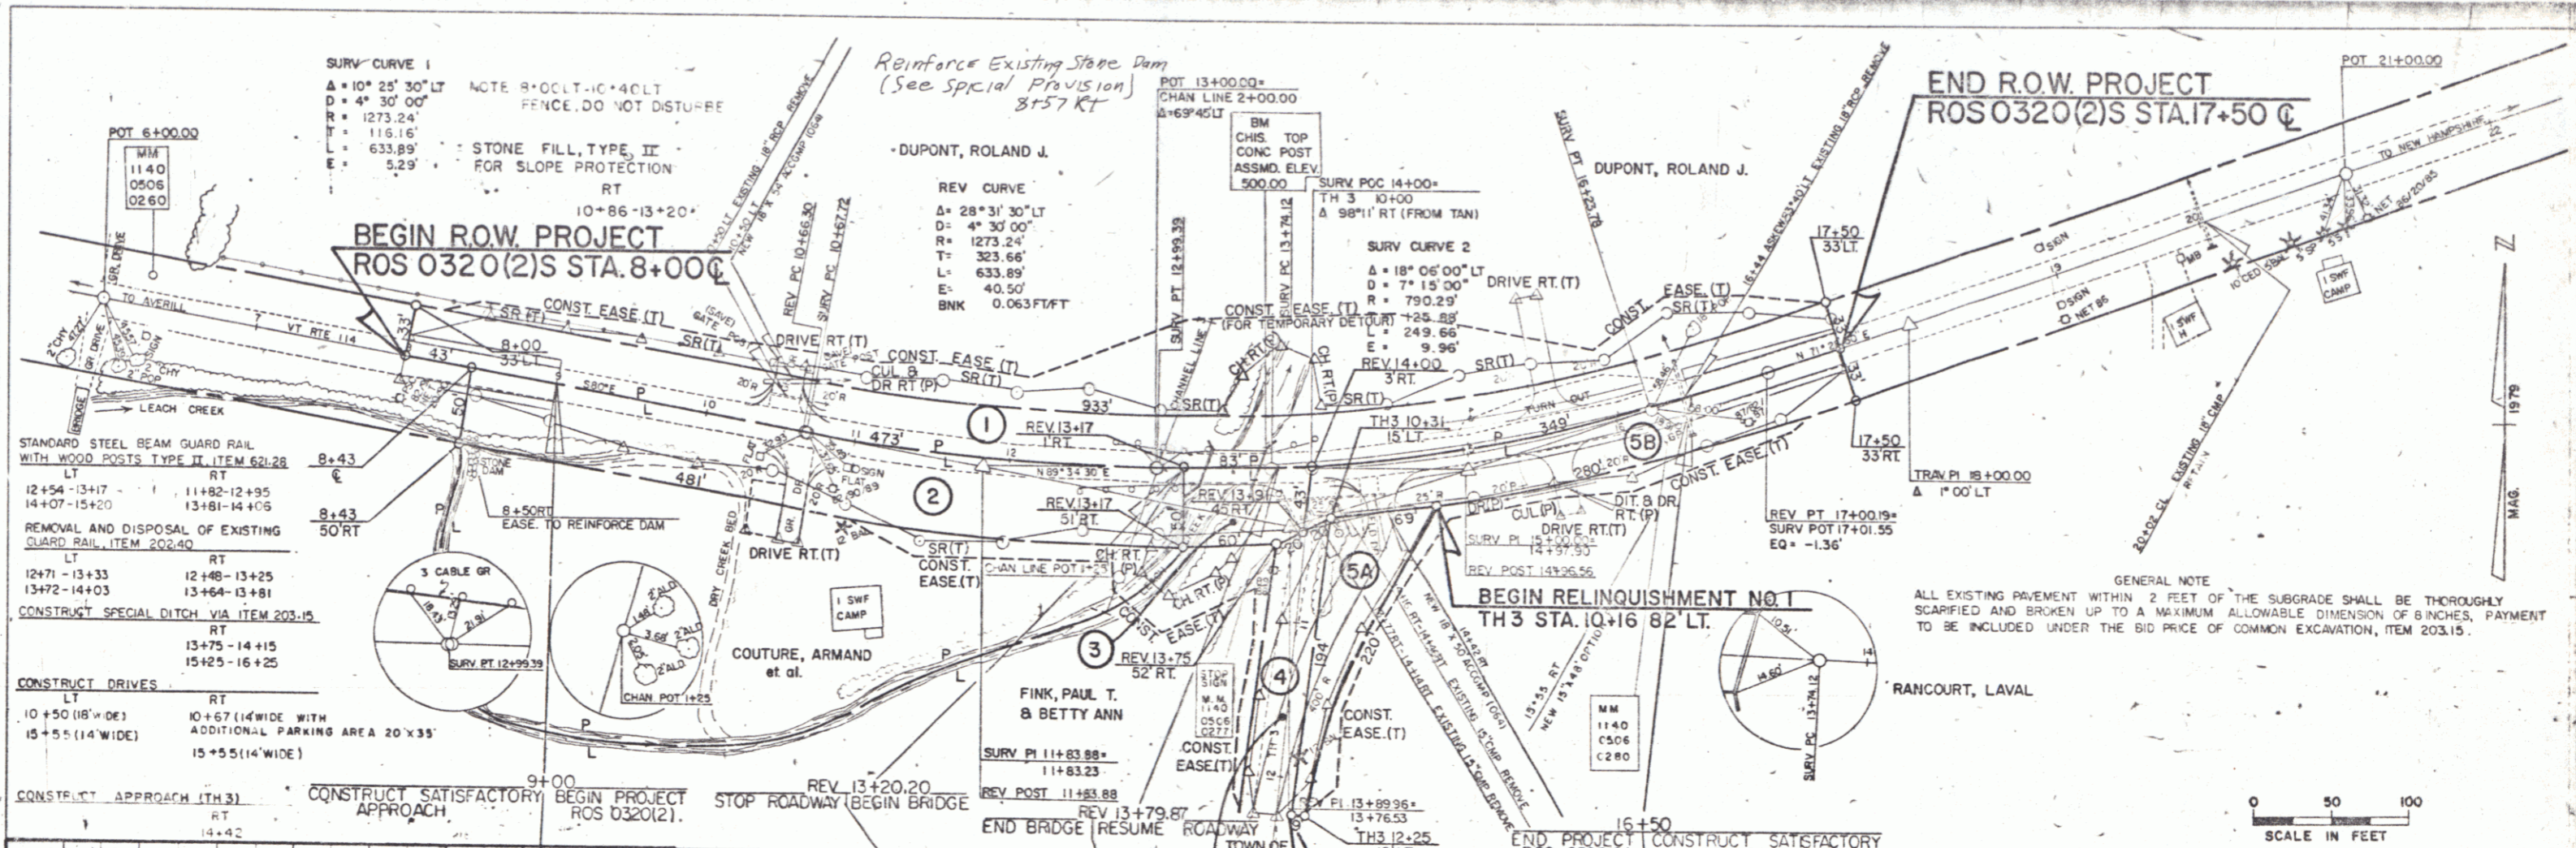

DATUM	
VERTICAL	ASSUMED
HORIZONTAL	N/A

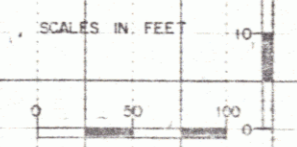

MAY 16 1985

SURVEYED BY	CLARK	DATE	1-80
DRAWN BY	TOOLAN	DATE	6-82
TRACED BY	TOOLAN	DATE	6-82
CANAAN			
PROJ. RCS 0320(2)S			
SHEET 5 OF 5			

PLATE 1 SINGLE PLAN - PROFILE
CHARLES BRUNING CO.

4