


CONSTRUCT DRIVES 6+57 Rt. - Gravel	CONSTRUCT APPROACH 9+35 Rt. - Gravel & Bit. Conc.	GUARD RAIL - STANDARD STEEL BEAM WITH WOOD POSTS, TYPE II	REMOVAL AND DISPOSAL OF EXISTING GUARD RAIL
	REMOVING & RESETTING FENCE (Position on or near R.O.W. Line) 6+06 - 6+35 Rt.	Lt. 6+93 - 7+61 Rt. 6+62 - 7+38 7+98 - 9+24 7+73 - 8+28	Lt. 7+86 - 8+35 Rt. 7+10 - 7+40 7+74 - 8+04

BRIDGE DATA
 Conc. T Beam (1926)
 Conc. R27
 Clear Span 300
 Clear Height 6.3'
 Roadway Width 21'

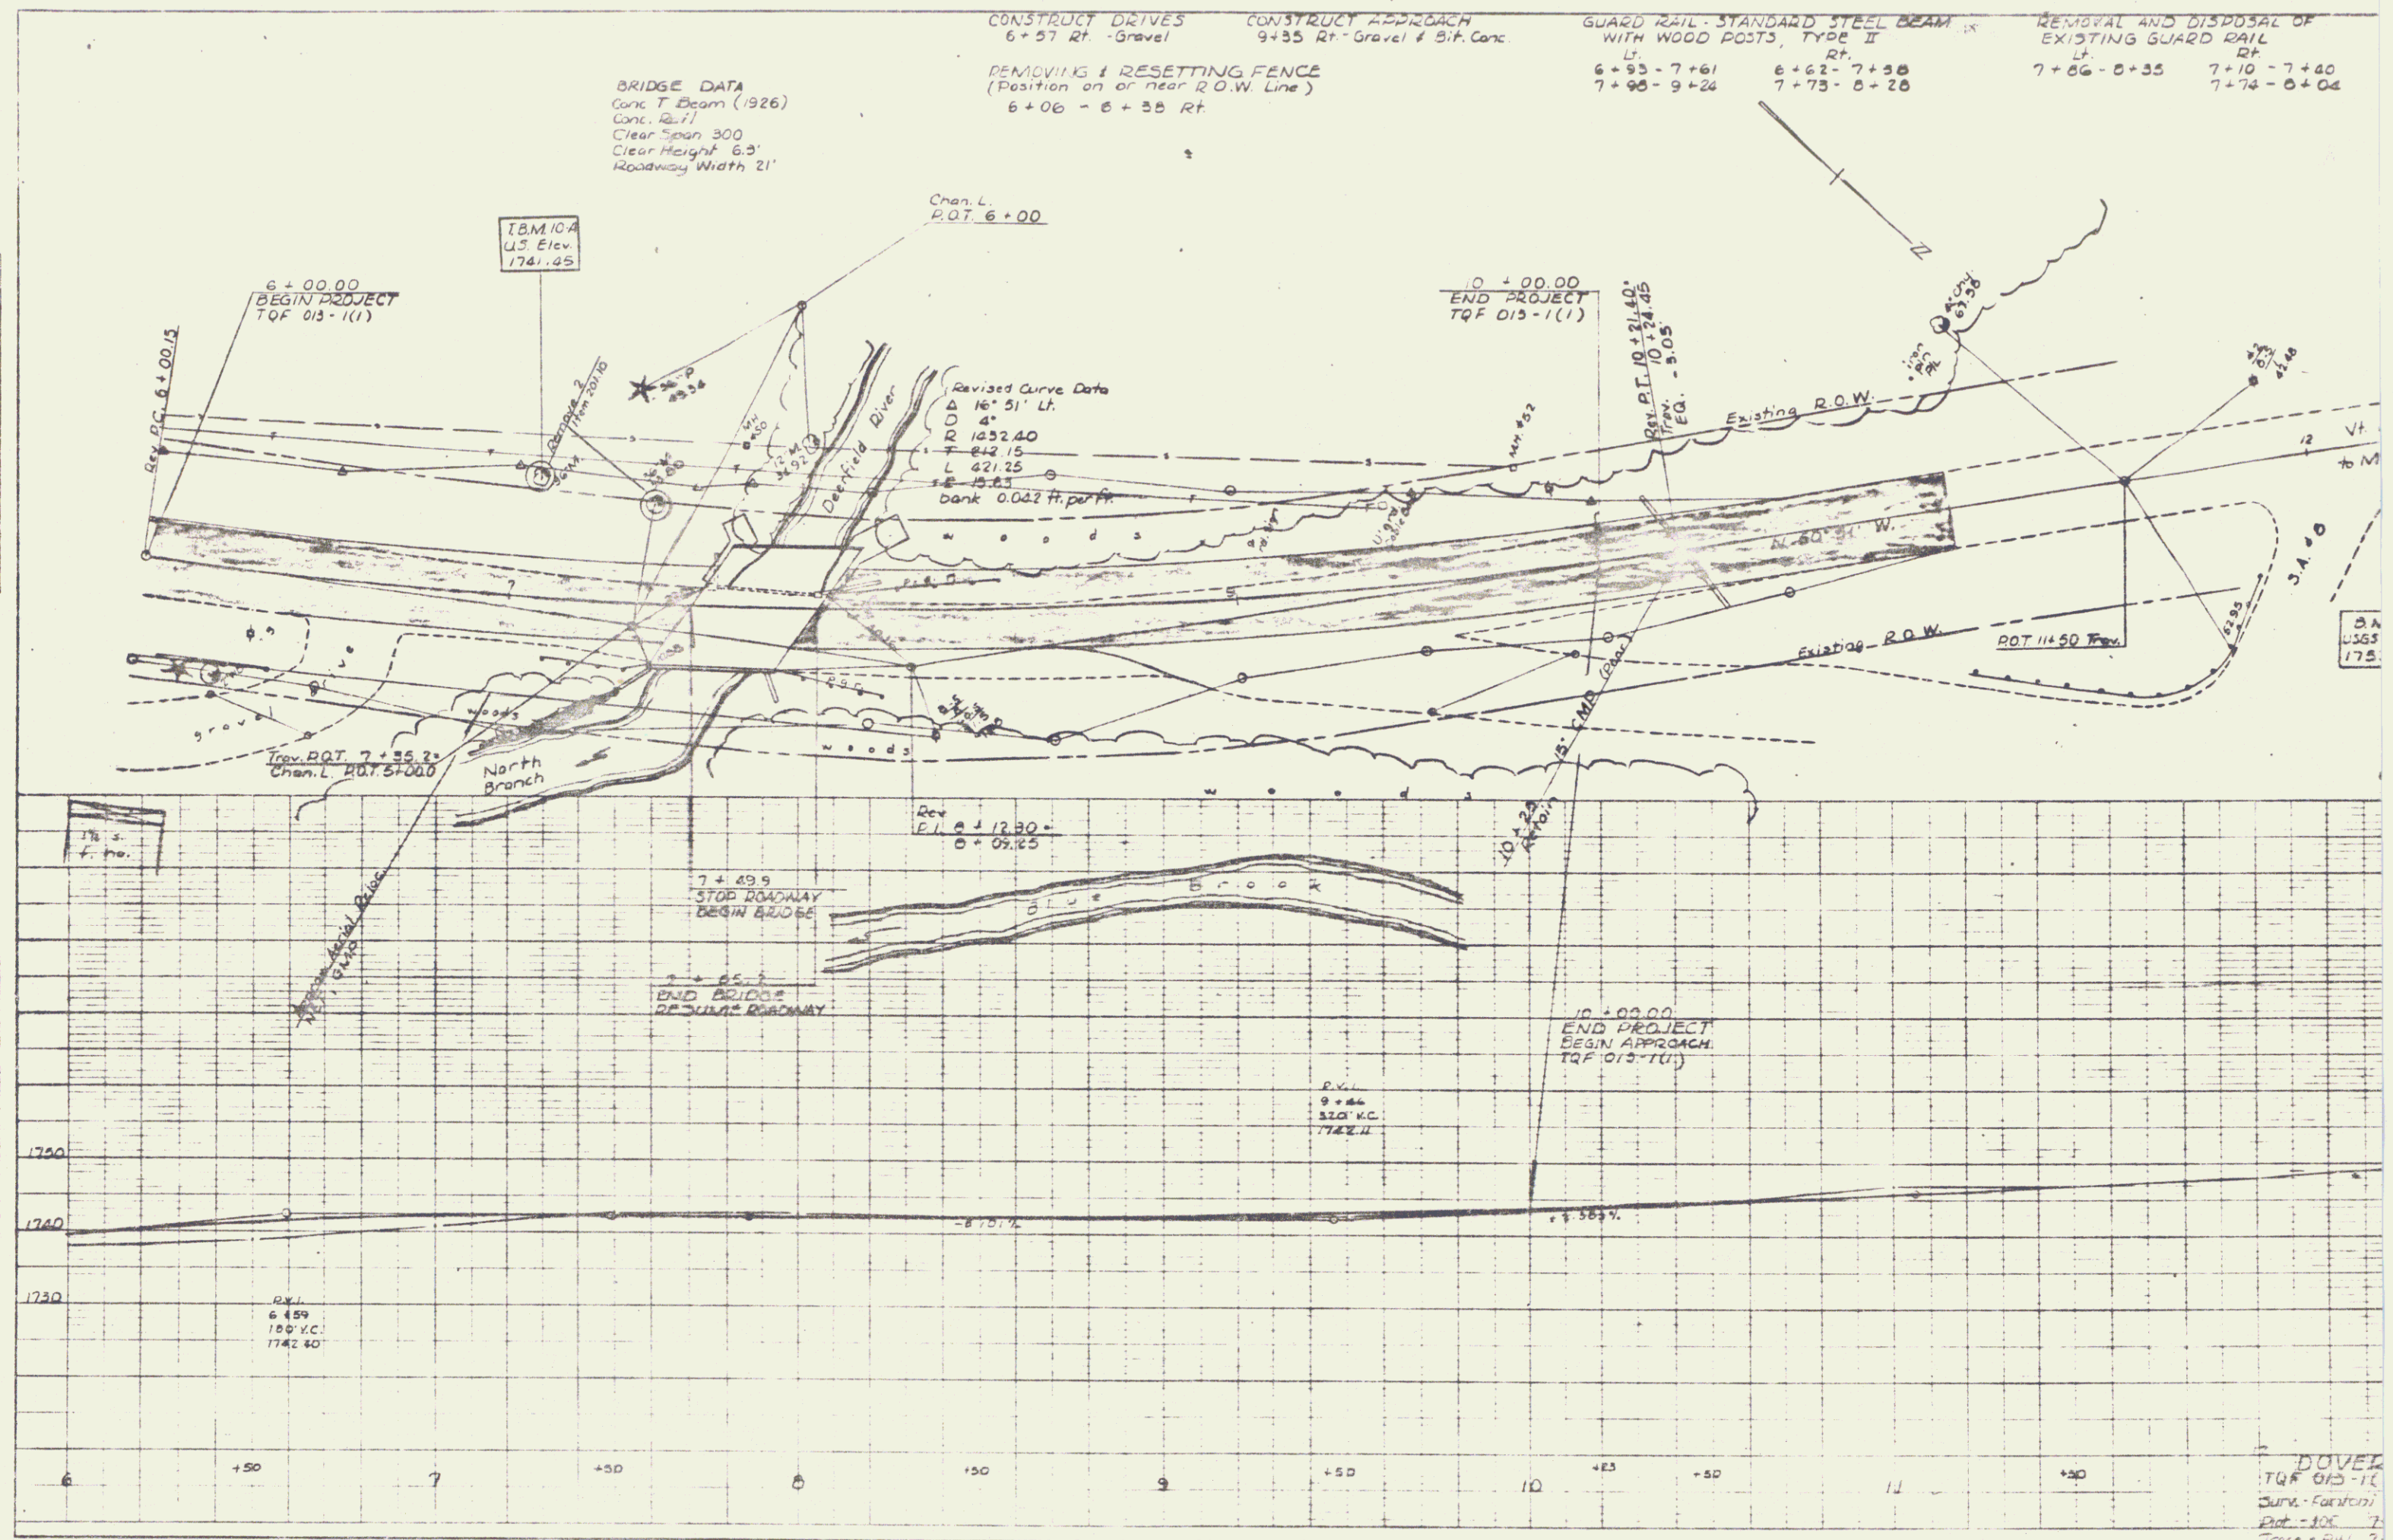

PLAN
 DATE: 10/1/50
 DRAWN BY: [illegible]
 CHECKED BY: [illegible]

PROFILE
 DATE: 10/1/50
 DRAWN BY: [illegible]
 CHECKED BY: [illegible]

K-E PLANS & PROFILES
 1170 E. 10th St. S. S. P.O. Box 1000
 MINNEAPOLIS, MINN.

DOVE
 T&E 013-12
 Date - 10/1/50
 Plot - 10/1/50
 Time - 10/1/50
 Sheet 3 of 3