


INDEX OF SHEETS

# STATE OF VERMONT AGENCY OF TRANSPORTATION



## PROPOSED IMPROVEMENT TOWN OF GRANVILLE COUNTY OF ADDISON VT. RTE. 100


R.O.W. PLANS

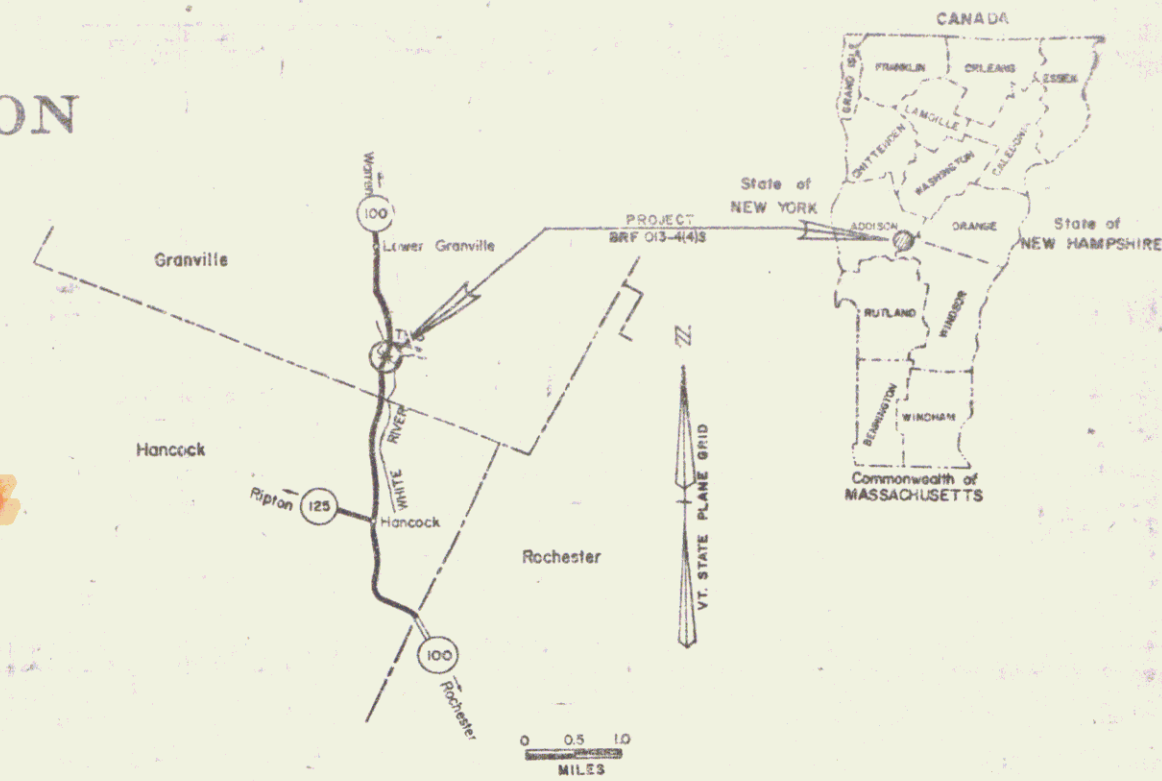

Beginning at a point 0.152 miles north of the Granville-Hancock town line and extending northerly 0.398 miles.

LENGTH OF ROADWAY	2022	FT.	0.383	MILE
LENGTH OF BRIDGE	78	FT.	.015	MILE
LENGTH OF PROJECT	2100	FT.	0.398	MILE
LENGTH OF R.O.W. PROJ.	2550	FT.	0.475	MILE
1979 ADT	1380			
1985 ADT	1550			
1985 DHV	225			
D	53%			
I	6%			
V	50 M.P.H.			

BEGIN R.O.W. PROJECT BRF 013-4(4)S  
REV. STA. 5+50 25' LT.

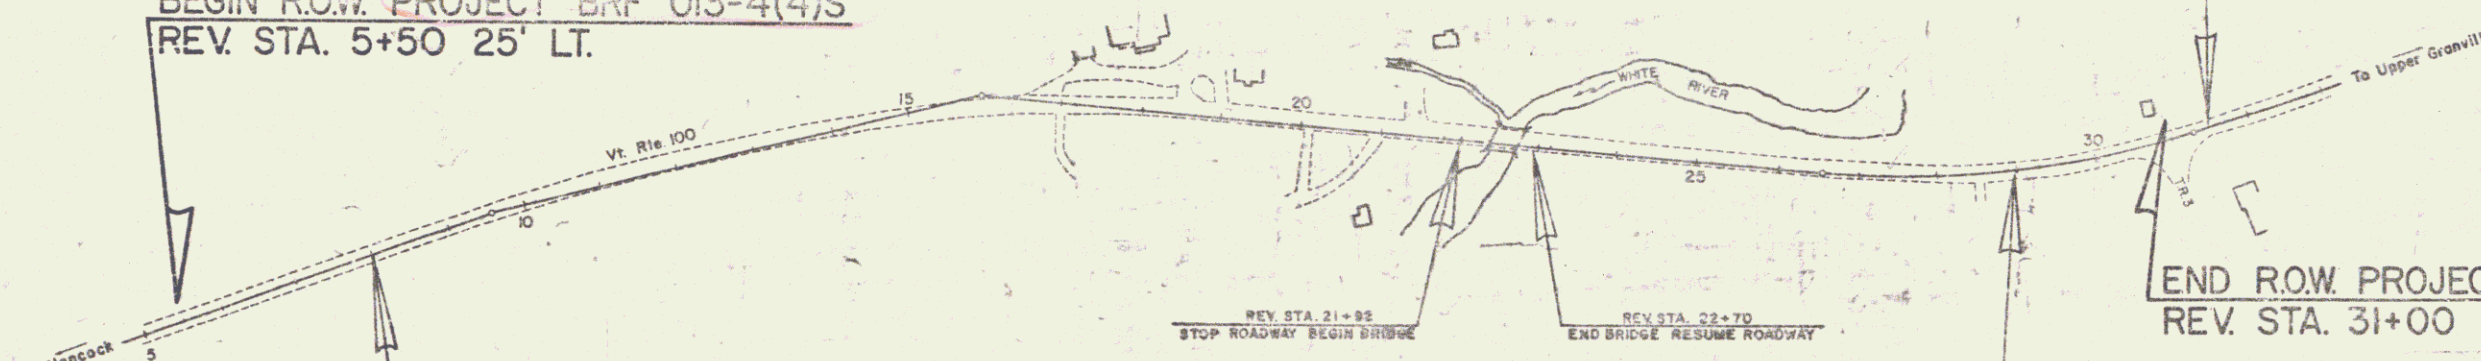

END R.O.W. PROJECT BRF 013-4(4)S  
REV. STA. 31+00 25' LT.

- CONVENTIONAL SIGNS
- COUNTY LINE
  - TOWN LINE
  - LIMITS OF ACCESS
  - POINT OF ACCESS
  - FENCE LINE
  - STONE WALL
  - TRAVELED WAY
  - GUARD RAIL
  - RAILROAD
  - SURVEY LINE
  - CULVERT
  - POWER POLE
  - TELEPHONE POLE
  - EES
  - CONTROL OF ACCESS
  - PROPERTY LINE
  - R.O.W. TAKING LINE
  - SLOPE RIGHTS
  - TOP OF CUT
  - TOE OF SLOPE

DATUM  
VERTICAL NGVD 1929  
HORIZONTAL N/A

PROJECT PROCESSED UNDER  
SECONDARY ROAD PLAN

Date: 10/22/1985  
RID: 176E086

These plans are subject to such engineering changes as may be required by the Federal Highway Admin. or Dir. of Engineering & Construction. Construction is to be carried out in accordance with these plans and the Standard Specifications for Highway and Bridge Construction dated March, 1976, as approved by the Federal Highway Administration on October 27, 1976, for use on this project, including all subsequent revisions and such revised specifications and special provisions as are incorporated in these plans.

APPROVED: [Signature]  
CHIEF, PROPERTY ADMINISTRATION

DATE: 10/22/1985



APPROVED: [Signature] DATE: 10/22/1985  
DIRECTOR OF ENGINEERING AND CONSTRUCTION

DEPARTMENT OF TRANSPORTATION  
FEDERAL HIGHWAY ADMINISTRATION

APPROVED: [Signature] DATE: 10/22/1985  
PROJECT BRF NO. 013-4(4)S

SHEET 1 OF 5 SHEETS

DATE: 10/22/1985

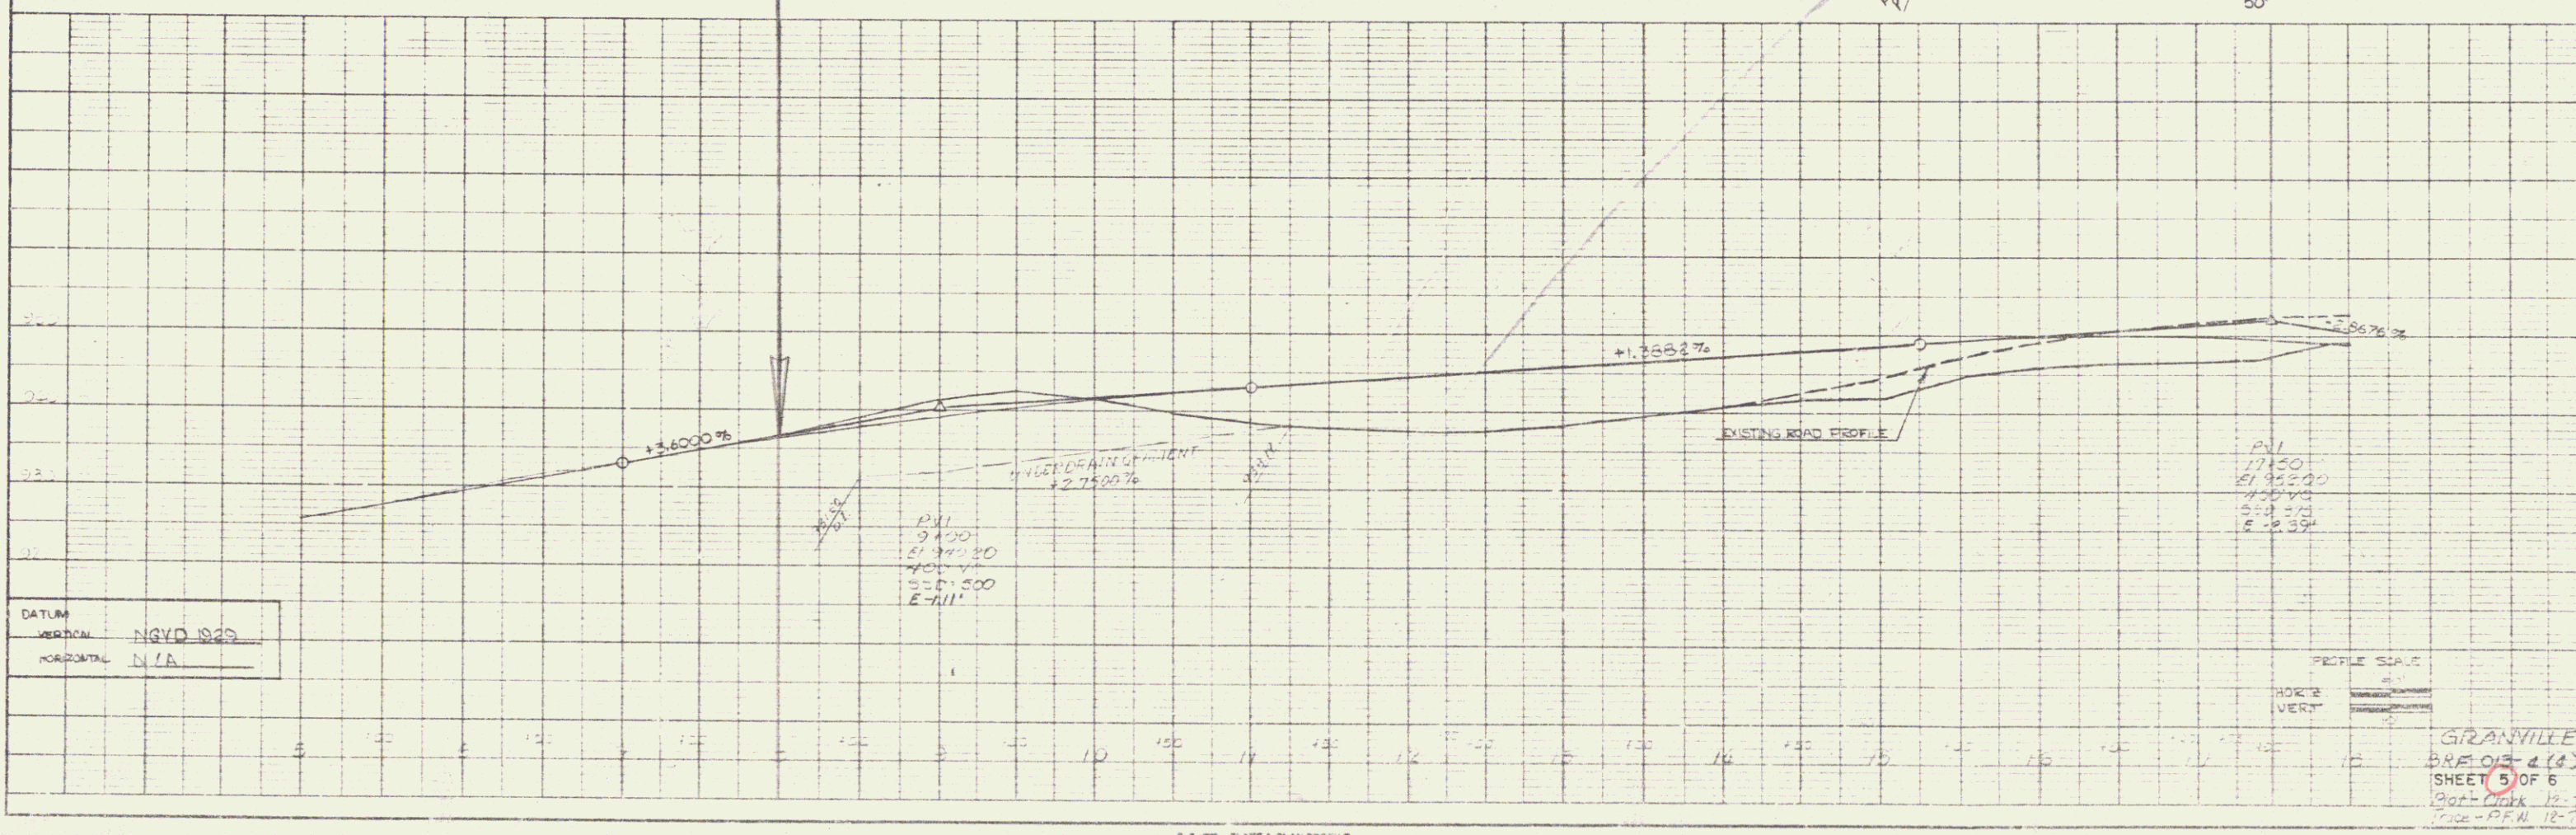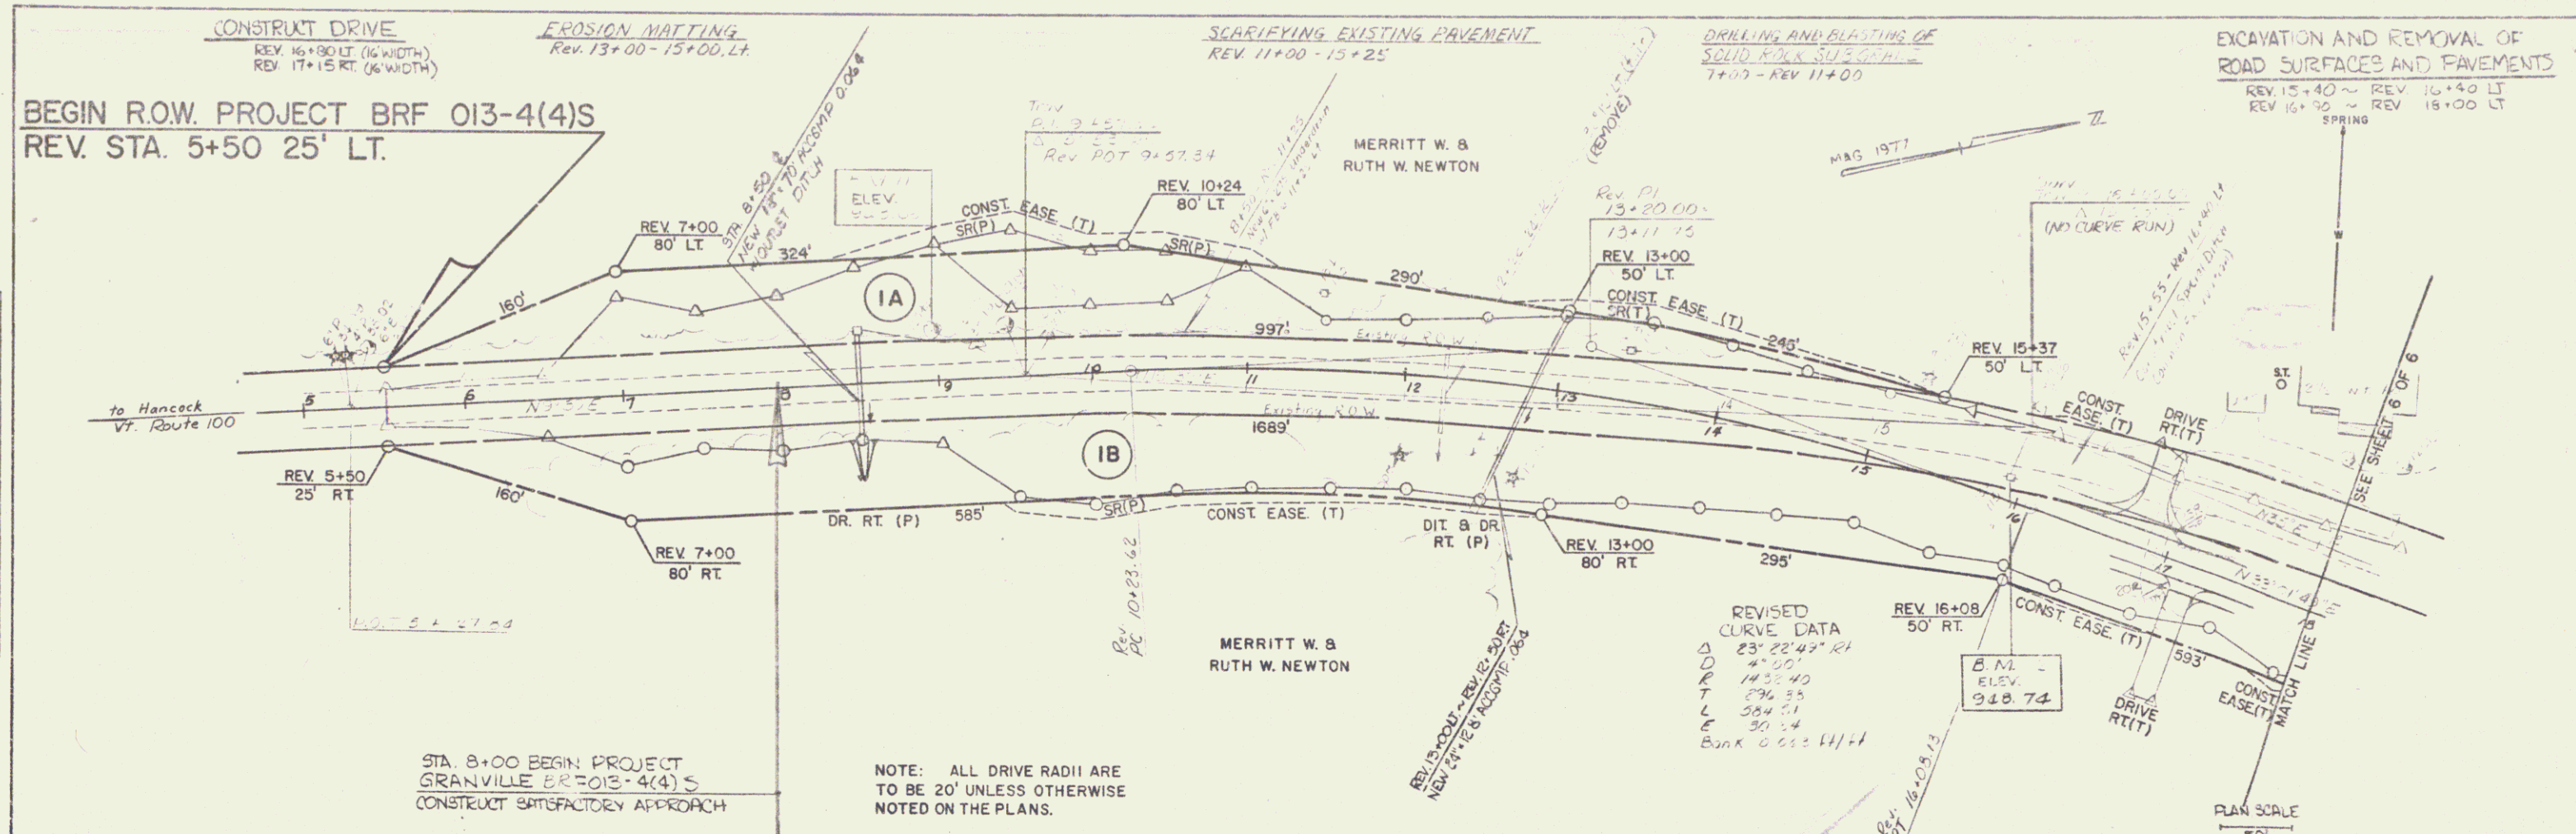

PLAN

DATE: 10-73

BY: [Signature]

SCALE: 1" = 50'

PROFILE

DATE: 10-73

BY: [Signature]

SCALE: 1" = 10'

K&E DATE 1, PLAN PROFILE

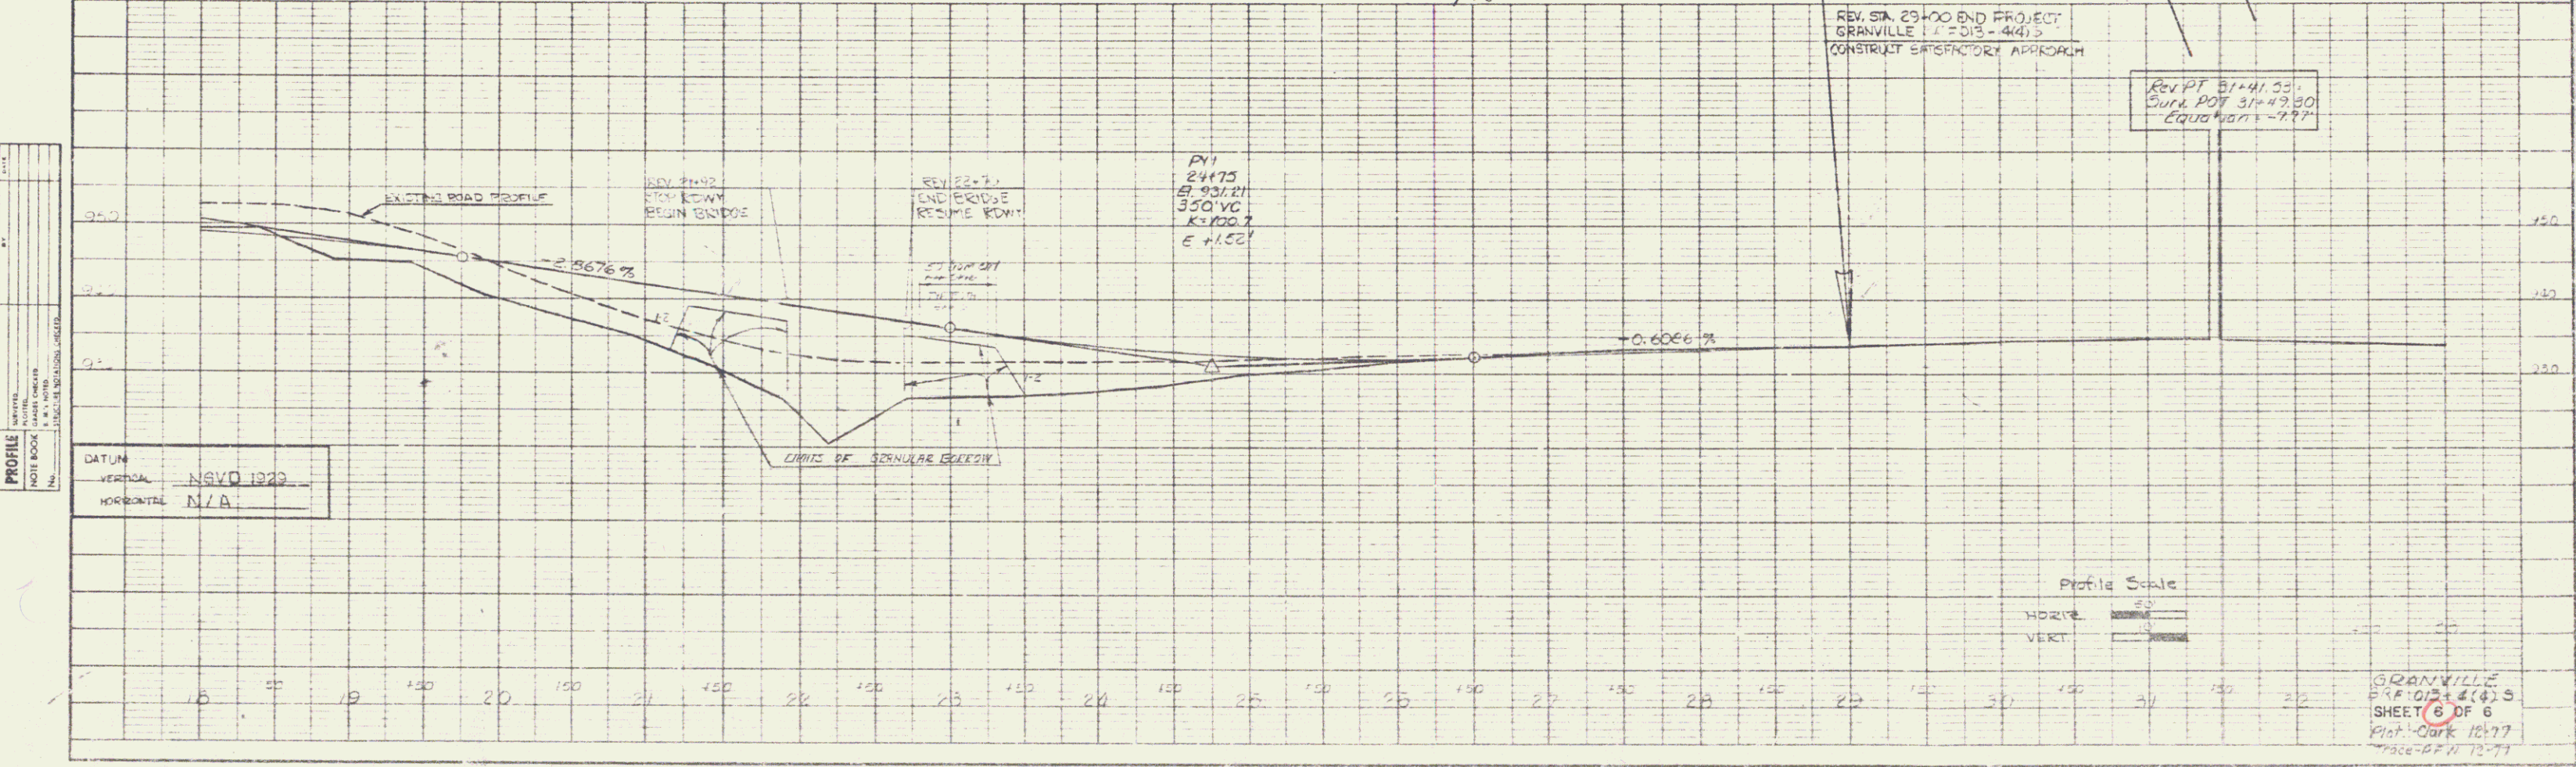
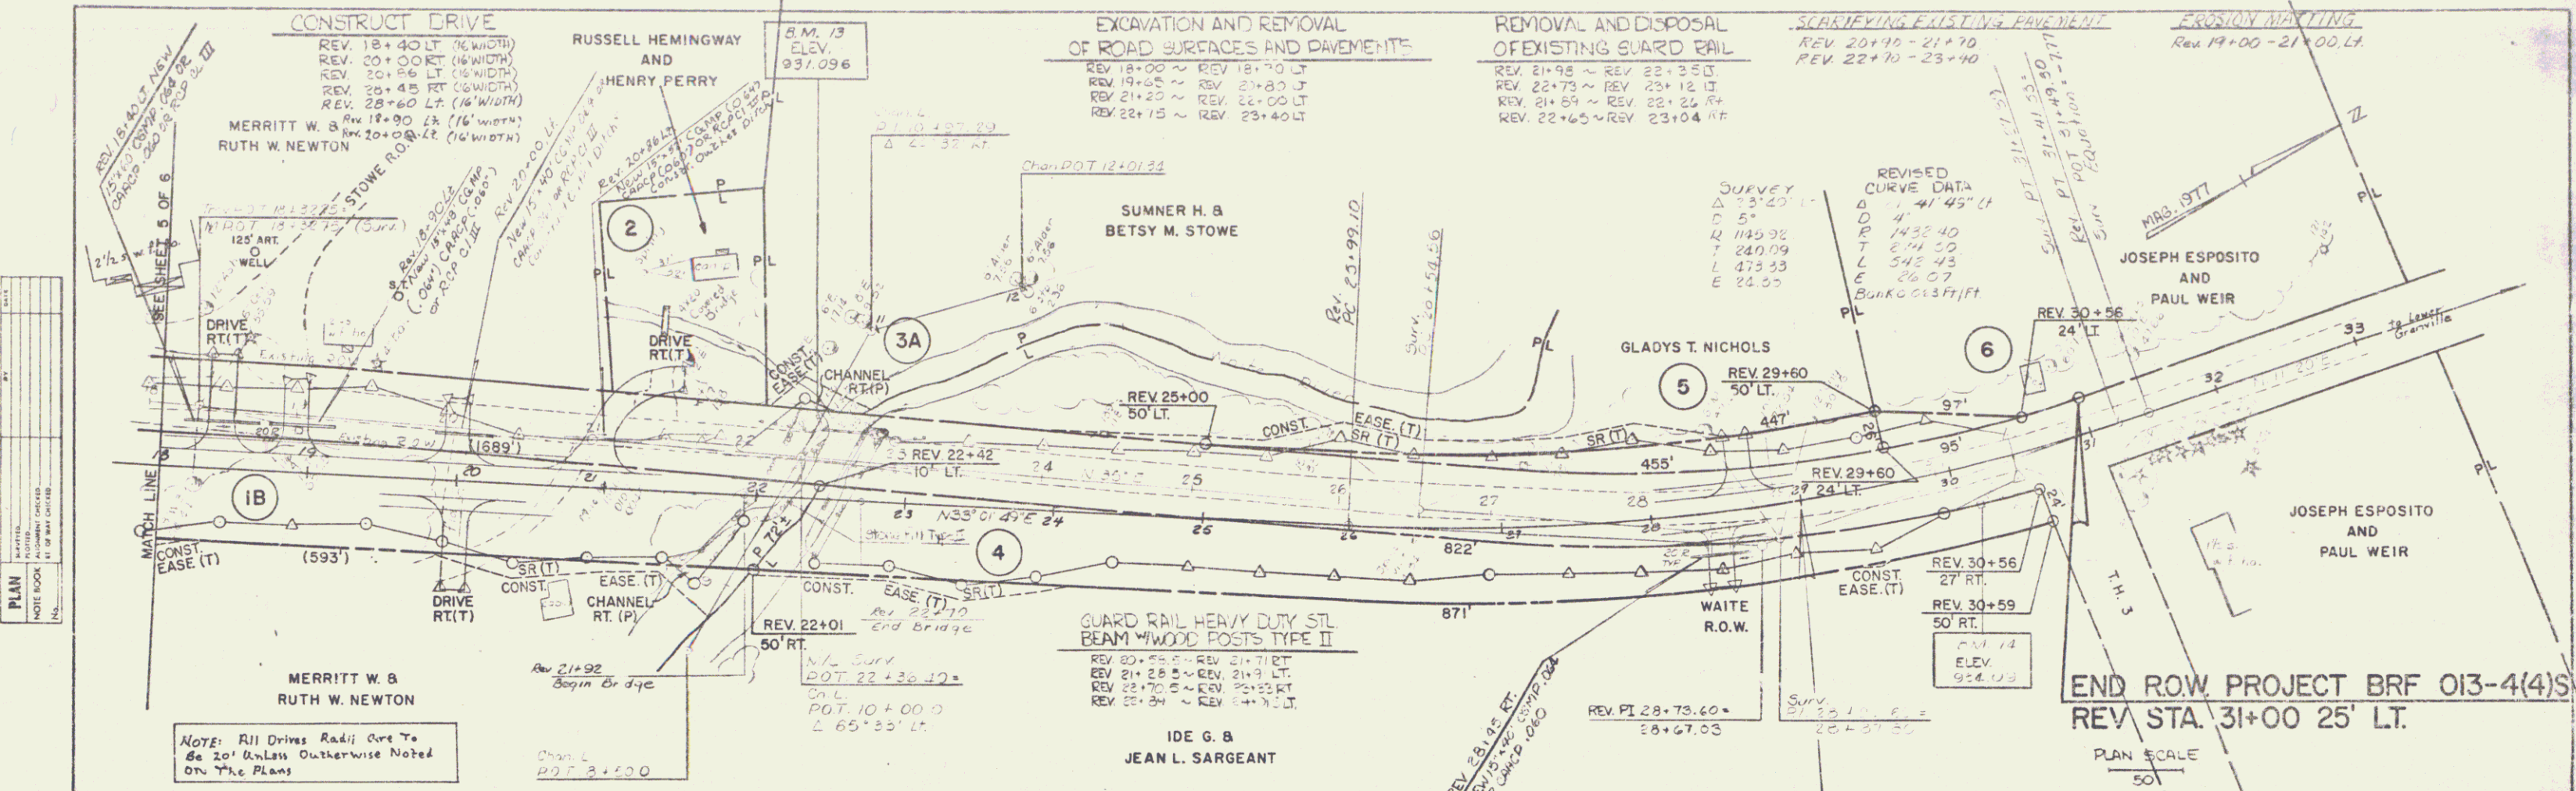


PLATE 1, PLAN-PROFILE