

INDEX OF SHEETS
 1. TITLE
 2. QUANTITY
 3. PLAN - TYPICAL - PROFILE
 4. APPROX. DETAILS

STANDARDS
 5. 56-86-76 STEEL BRIDGE RAIL MOUNTINGS
 6. 908-01-75 GENERAL INFORMATION
 7. 9-1 STEEL BEAM GUARD RAIL (20 MPH & OVER)
 8-II CHANNEL CROSS SECTIONS (SR 201-304)
 12-14 ROADWAY CROSS SECTIONS

JAN. 8, '76
 APRIL 3, '78 (R)
 MAY 29, '78 (R)

STATE OF VERMONT
 AGENCY OF TRANSPORTATION




FEDERAL AID SECONDARY HIGHWAY PROJECT
 PROPOSED IMPROVEMENT
TOWN OF GUILDHALL
 COUNTY OF ESSEX
VERMONT ROUTE 102

R.O.W. PLANS

PROJECT LOCATION: BEGINNING AT A POINT 2.393 MILES SOUTH OF THE GUILDHALL-MAIDSTONE TOWN LINE AND PROCEEDING NORTHEASTERLY 625.13 FEET ON VT. ROUTE 102.

PROJECT DESCRIPTION: THIS PROJECT CONSISTS OF CONSTRUCTING NEW CONCRETE HEADWALLS, NEW CONCRETE INVERT CURBS, AND INSTALLATION OF GUARD RAIL.

LENGTH OF ROADWAY = 625.13 FT = 0.118 MI.
 LENGTH OF BRIDGE
 LENGTH OF PROJECT = 625.13 FT = 0.118 MI.
 LENGTH OF R.O.W. PROJECT = 625.13 FT = 0.118 MI.

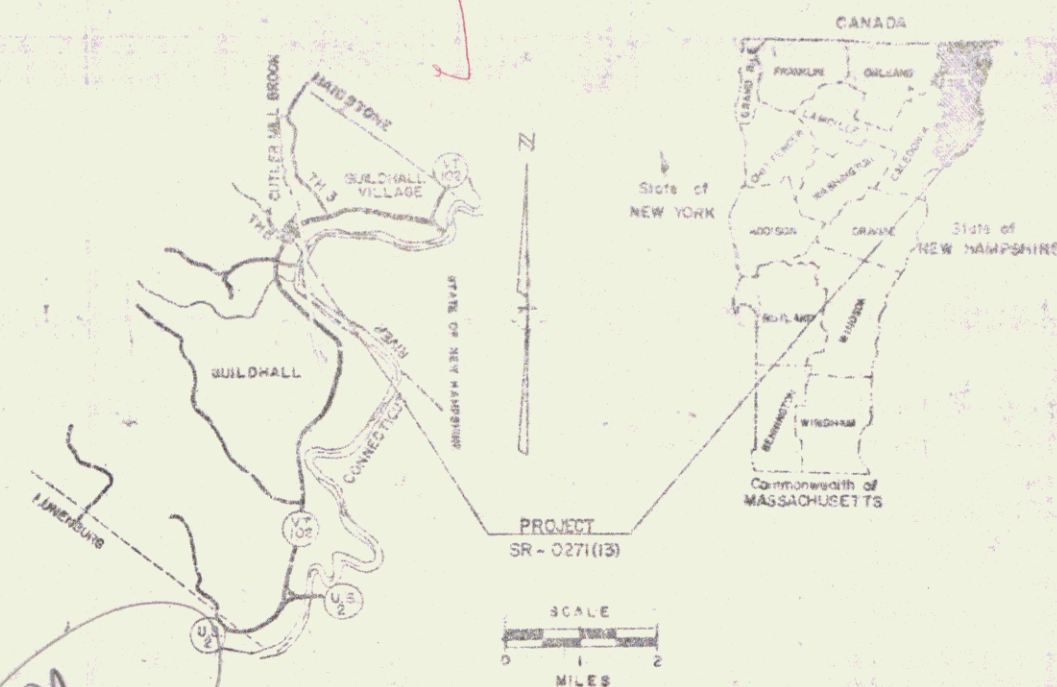


TRAFFIC DATA
 1980 AADT = 580
 1980 DHV = 105
 D = 65%
 T = 3%
 V = 50 MPH

VT 102

CONVENTIONAL SIGNS

- COUNTY LINE
- TOWN LINE
- LIMITS OF ACCESS
- POINT OF ACCESS
- FENCE LINE
- STONE WALL
- TRAVELED WAY
- GUARD RAIL
- RAILROAD
- SURVEY LINE
- CULVERT
- POWER POLE
- TELEPHONE POLE
- TREES
- CONTROL OF ACCESS
- PROPERTY LINE
- R.O.W. TAKING LINE
- SLOPE RIGHTS
- TOP OF CUT
- TOE OF SLOPE

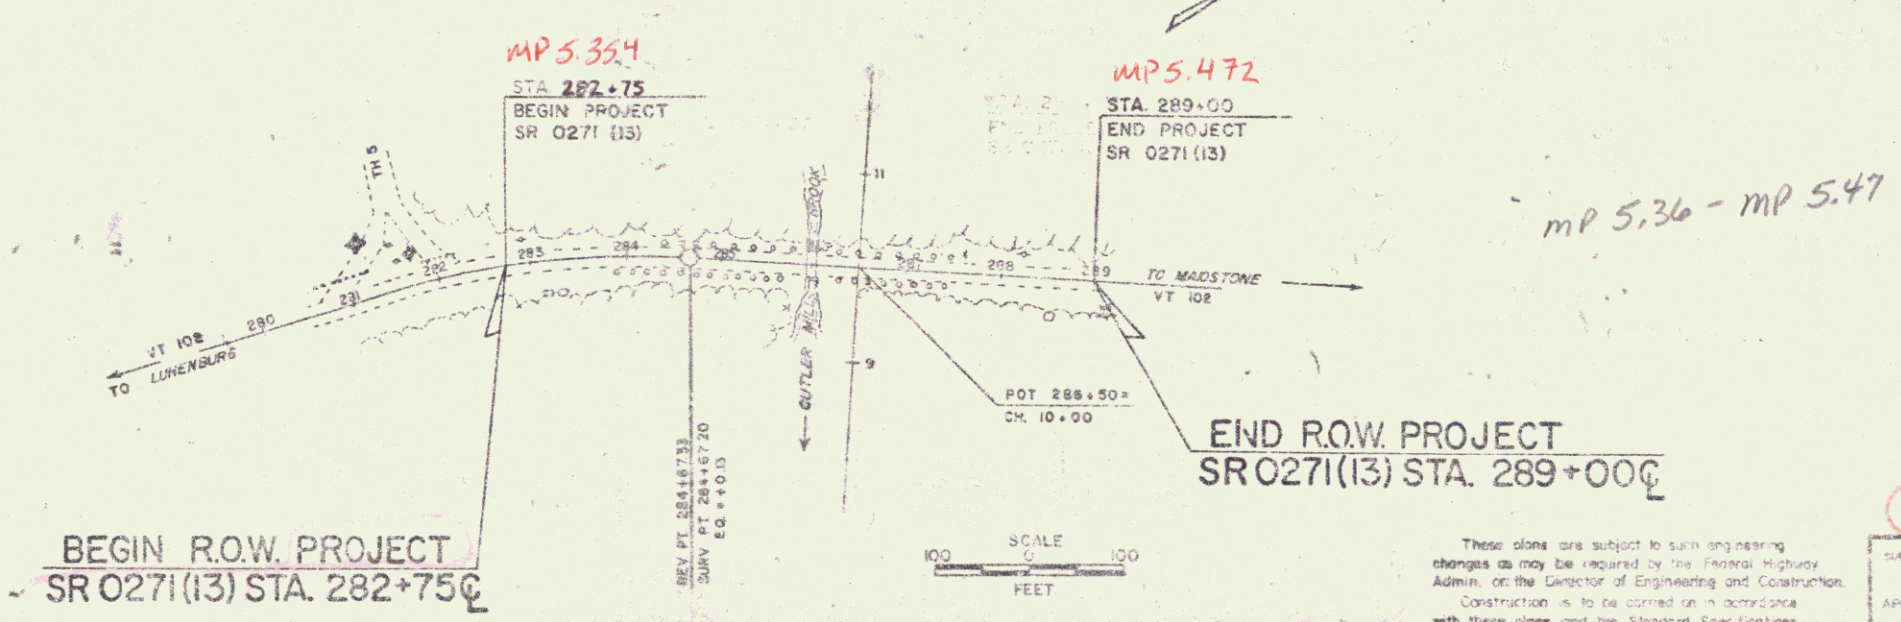

These plans are subject to such engineering changes as may be required by the Federal Highway Admin. or the Director of Engineering and Construction. Construction is to be carried on in accordance with these plans and the Standard Specifications for Highway and Bridge Construction, July, March, 1976, as approved by the Federal Highway Administration on October 27, 1975, for the use of this project including all subsequent revisions and such revised specifications and special provisions as are incorporated in these plans.

Pin # 76E088

APPROVED: [Signature] DATE: [Blank]

DIRECTOR OF ENGINEERING AND CONSTRUCTION
 DEPARTMENT OF TRANSPORTATION
 FEDERAL HIGHWAY ADMINISTRATION

APPROVED: [Signature] DATE: [Blank]

DIVISION ADMINISTRATOR

PROJECT: GUILDHALL
 SR 0271(13)
 3