


VT16 TYPICAL

1 1/2" Bituminous Concrete Pavement, Item 406.25 (± 1/4" For Total Thickness) Binder Course  
 1 1/4" Bituminous Concrete Pavement, Item 406.25 (± 1/4") Wearing Course  
 2 1/4" Subbase Of Gravel, Item 301.15 (± 1")  
 Shoulders: 1 1/2" Bituminous Concrete Pavement, Item 406.25

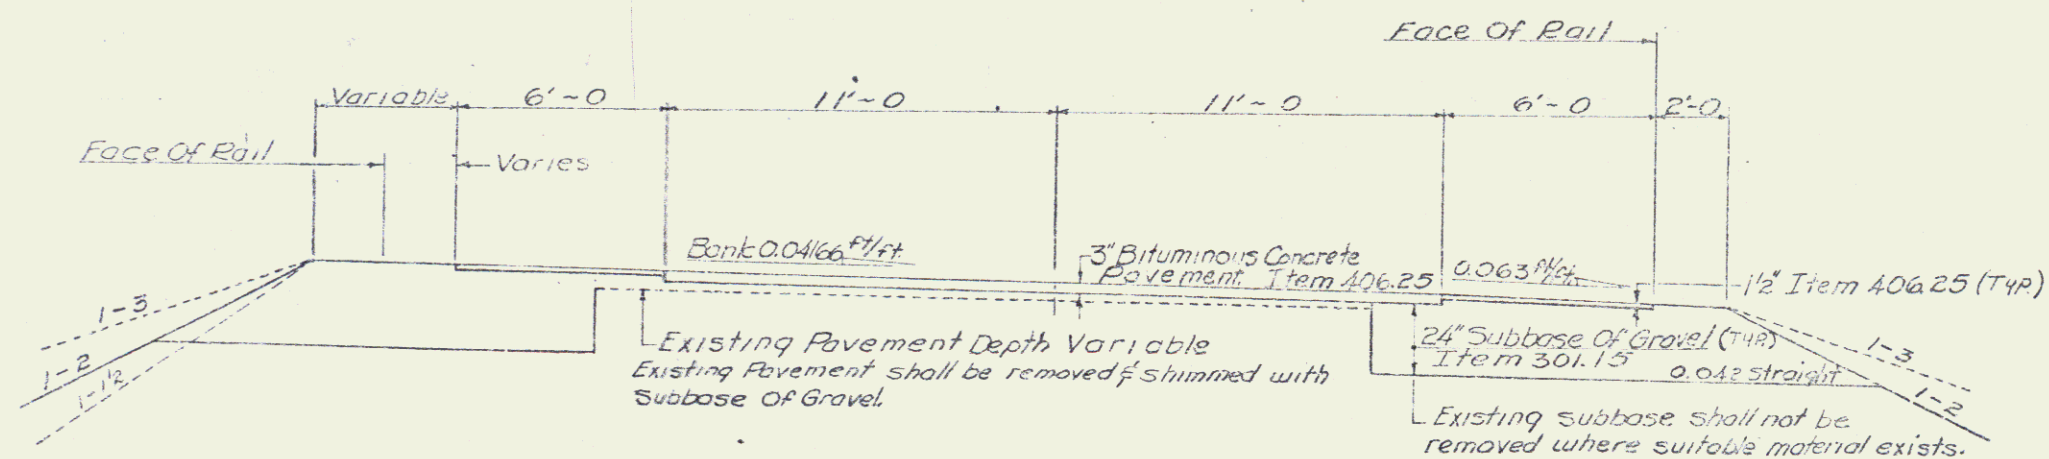

Seeding, Item 651.10			
%WT	Lbs./Acre	Name	Germ %
8.33	5	Timothy	85
3.33	2	Crown Vetch	97
41.67	25	Creeping Red Fescue	85
16.67	10	Alfalfa (Var. Saranac)	85
5.00	3	Red Top	85
16.67	10	Perennial Ryegrass (Var. Pennine)	90
8.33	5	Birdsfoot Trefoil	85
100	60		


Fertilizer, Item 651.15, To be mixed as follows:  
 Nitrogen 10%  
 Phosphorous 20%  
 Potash 10%

Fertilizer shall be delivered in bags of not to exceed 100 lbs. each & is to be applied @ the rate of 500 lbs. per acre.

For sandy soils, the fertilizer mix should be changed to:  
 Nitrogen 10%  
 Phosphorous 20%  
 Potash 20%

Agricultural Limestone, Item 651.20:  
 To be applied to all earth slopes @ the rate of two tons per acre or as directed by the engineer.

Hay Mulch, Item 651.25:  
 To be placed on all earth slopes @ the rate of two tons per acre.

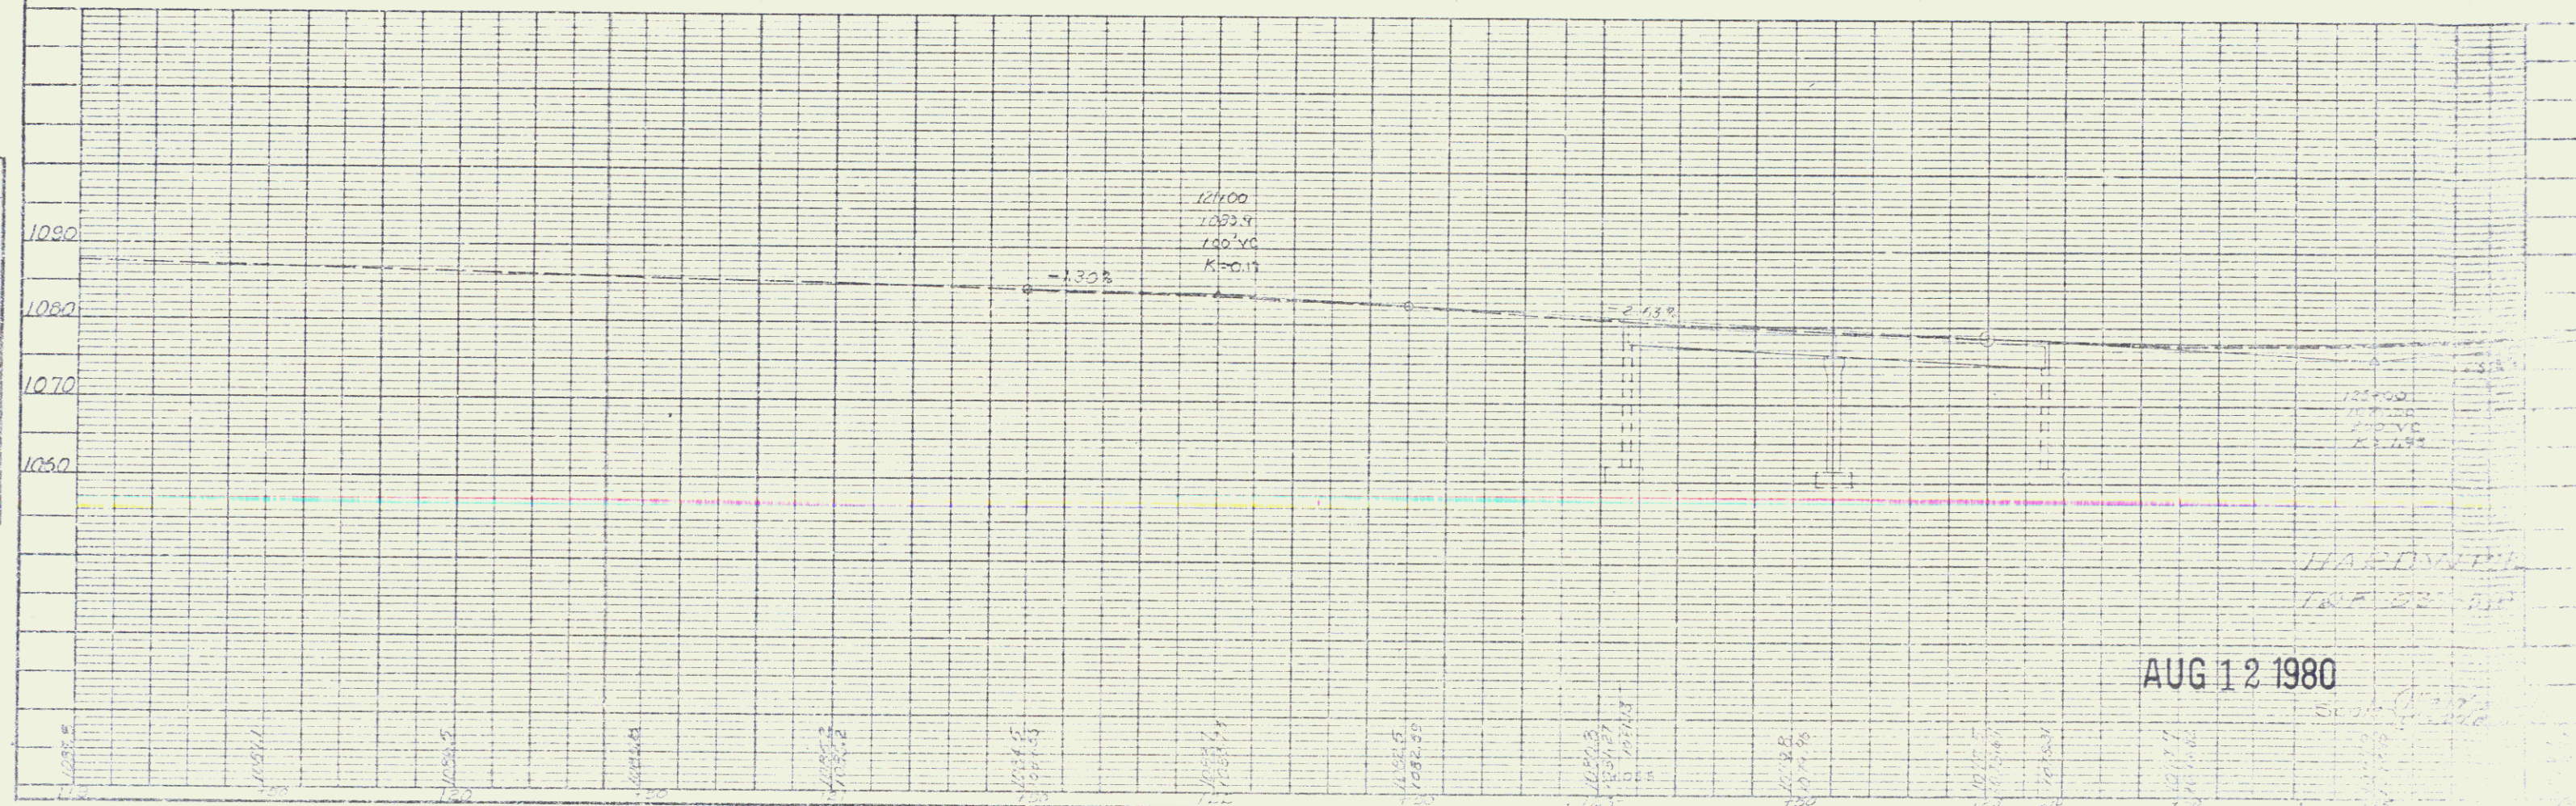

AUG 12 1980