


BM # 3  
 4.3' Lt Sta 127+61  
 Chisel Stone headwall  
 Elev 1090.20=  
 Construction Elev 1090.16

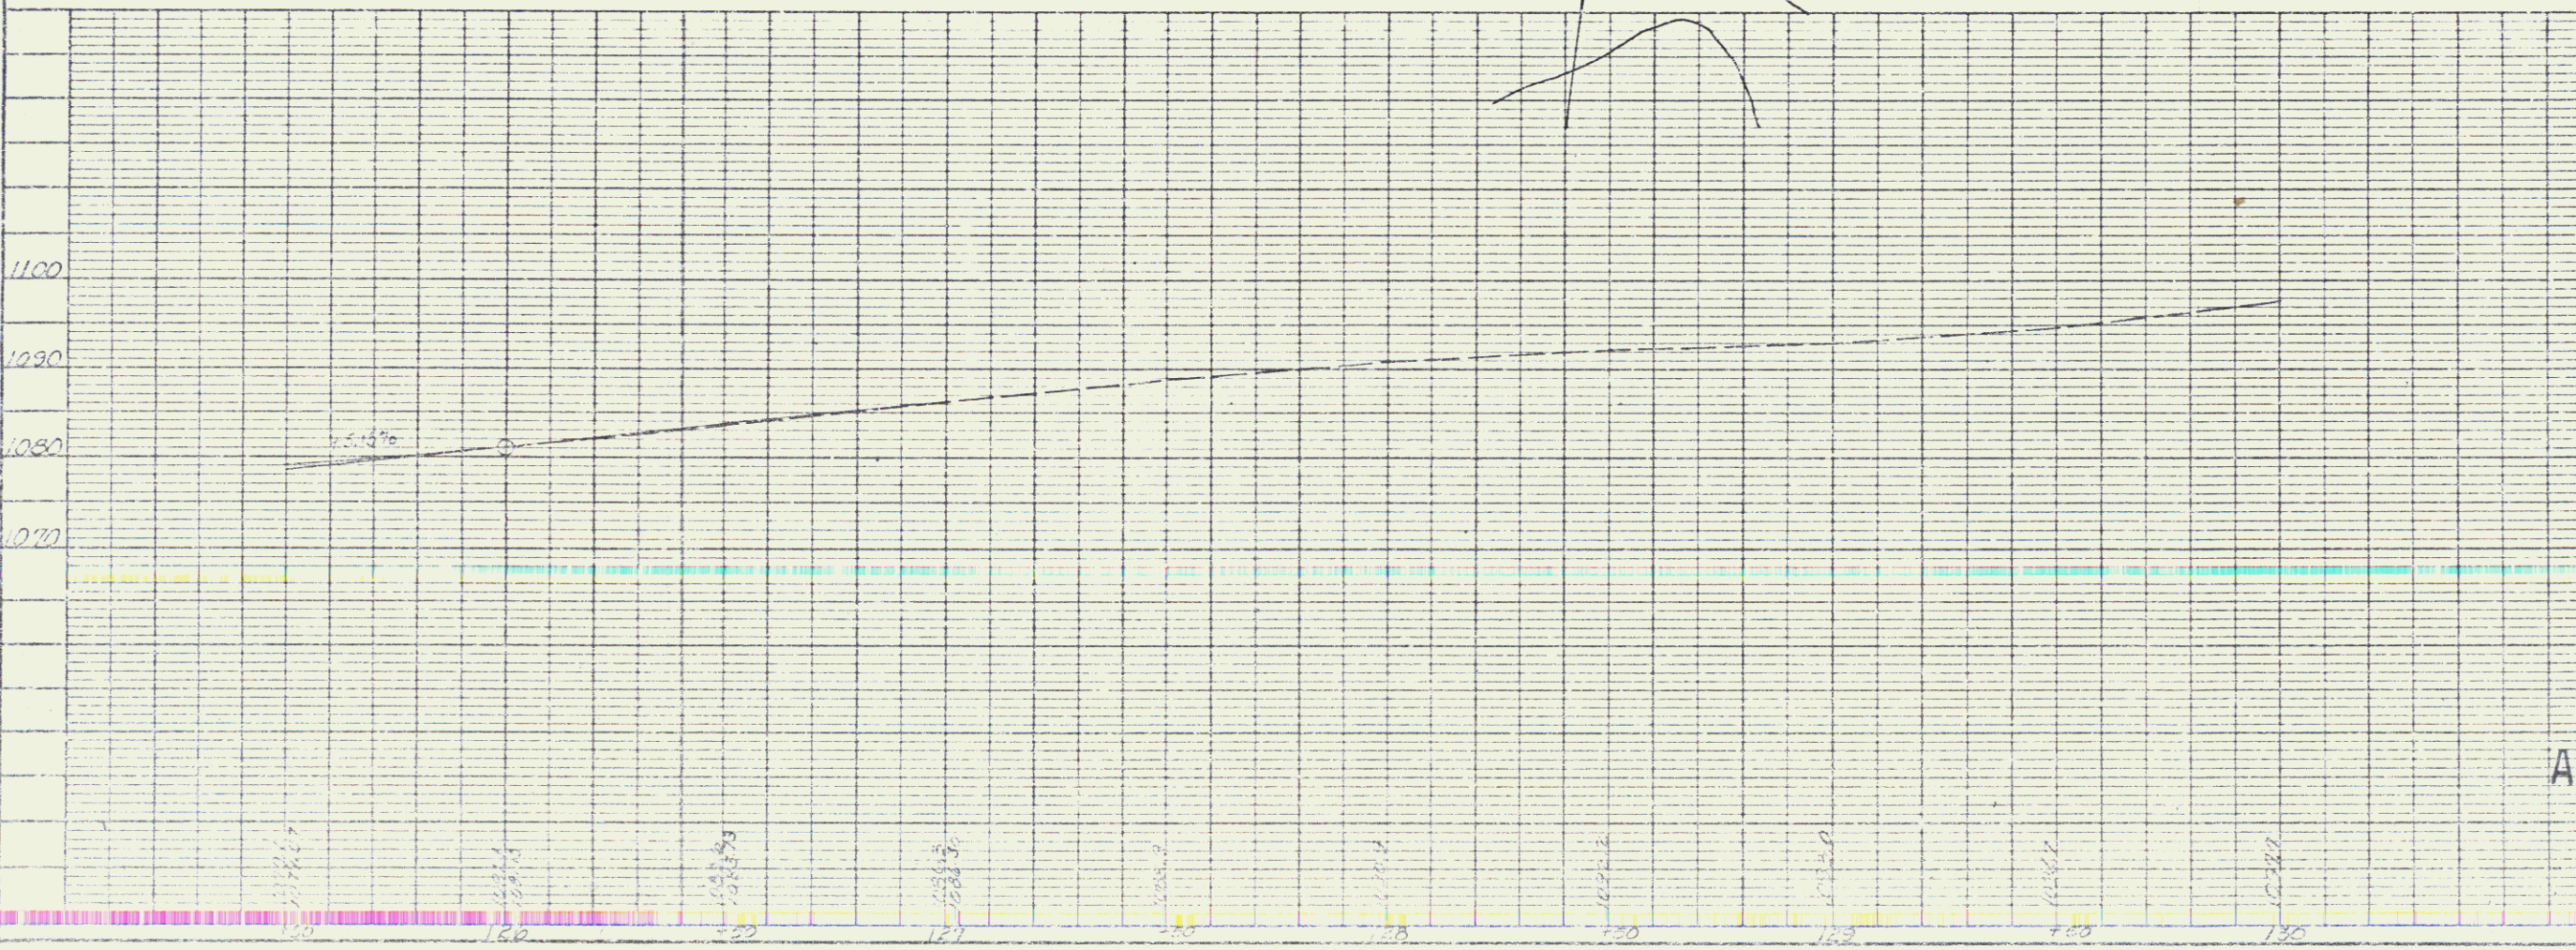

DATE	8/12/80
PROJECT	HARDWICK
FILE NO.	037-3(1)
DATE	8/12/80
PROJECT	HARDWICK
FILE NO.	037-3(1)

DATE	8/12/80
PROJECT	HARDWICK
FILE NO.	037-3(1)
DATE	8/12/80
PROJECT	HARDWICK
FILE NO.	037-3(1)

HARDWICK  
 LOT 037-3(1)

AUG 12 1980

PLATE 1, PLAN PROFILE  
 ENGINEER & ARCHITECTS

Sheet 6 of 8

5