


BEGIN R.O.W. PROJECT FO 2H(0S)
STA. 17+00 @

BUSIER, BRIAN & KATHY

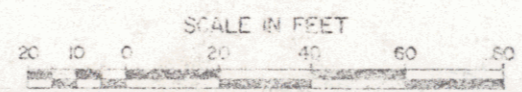

OCT 21 1986

HINESBURG
FO 21-1(8)S
SHEET 6 OF 8